


J-11-O SHT 25

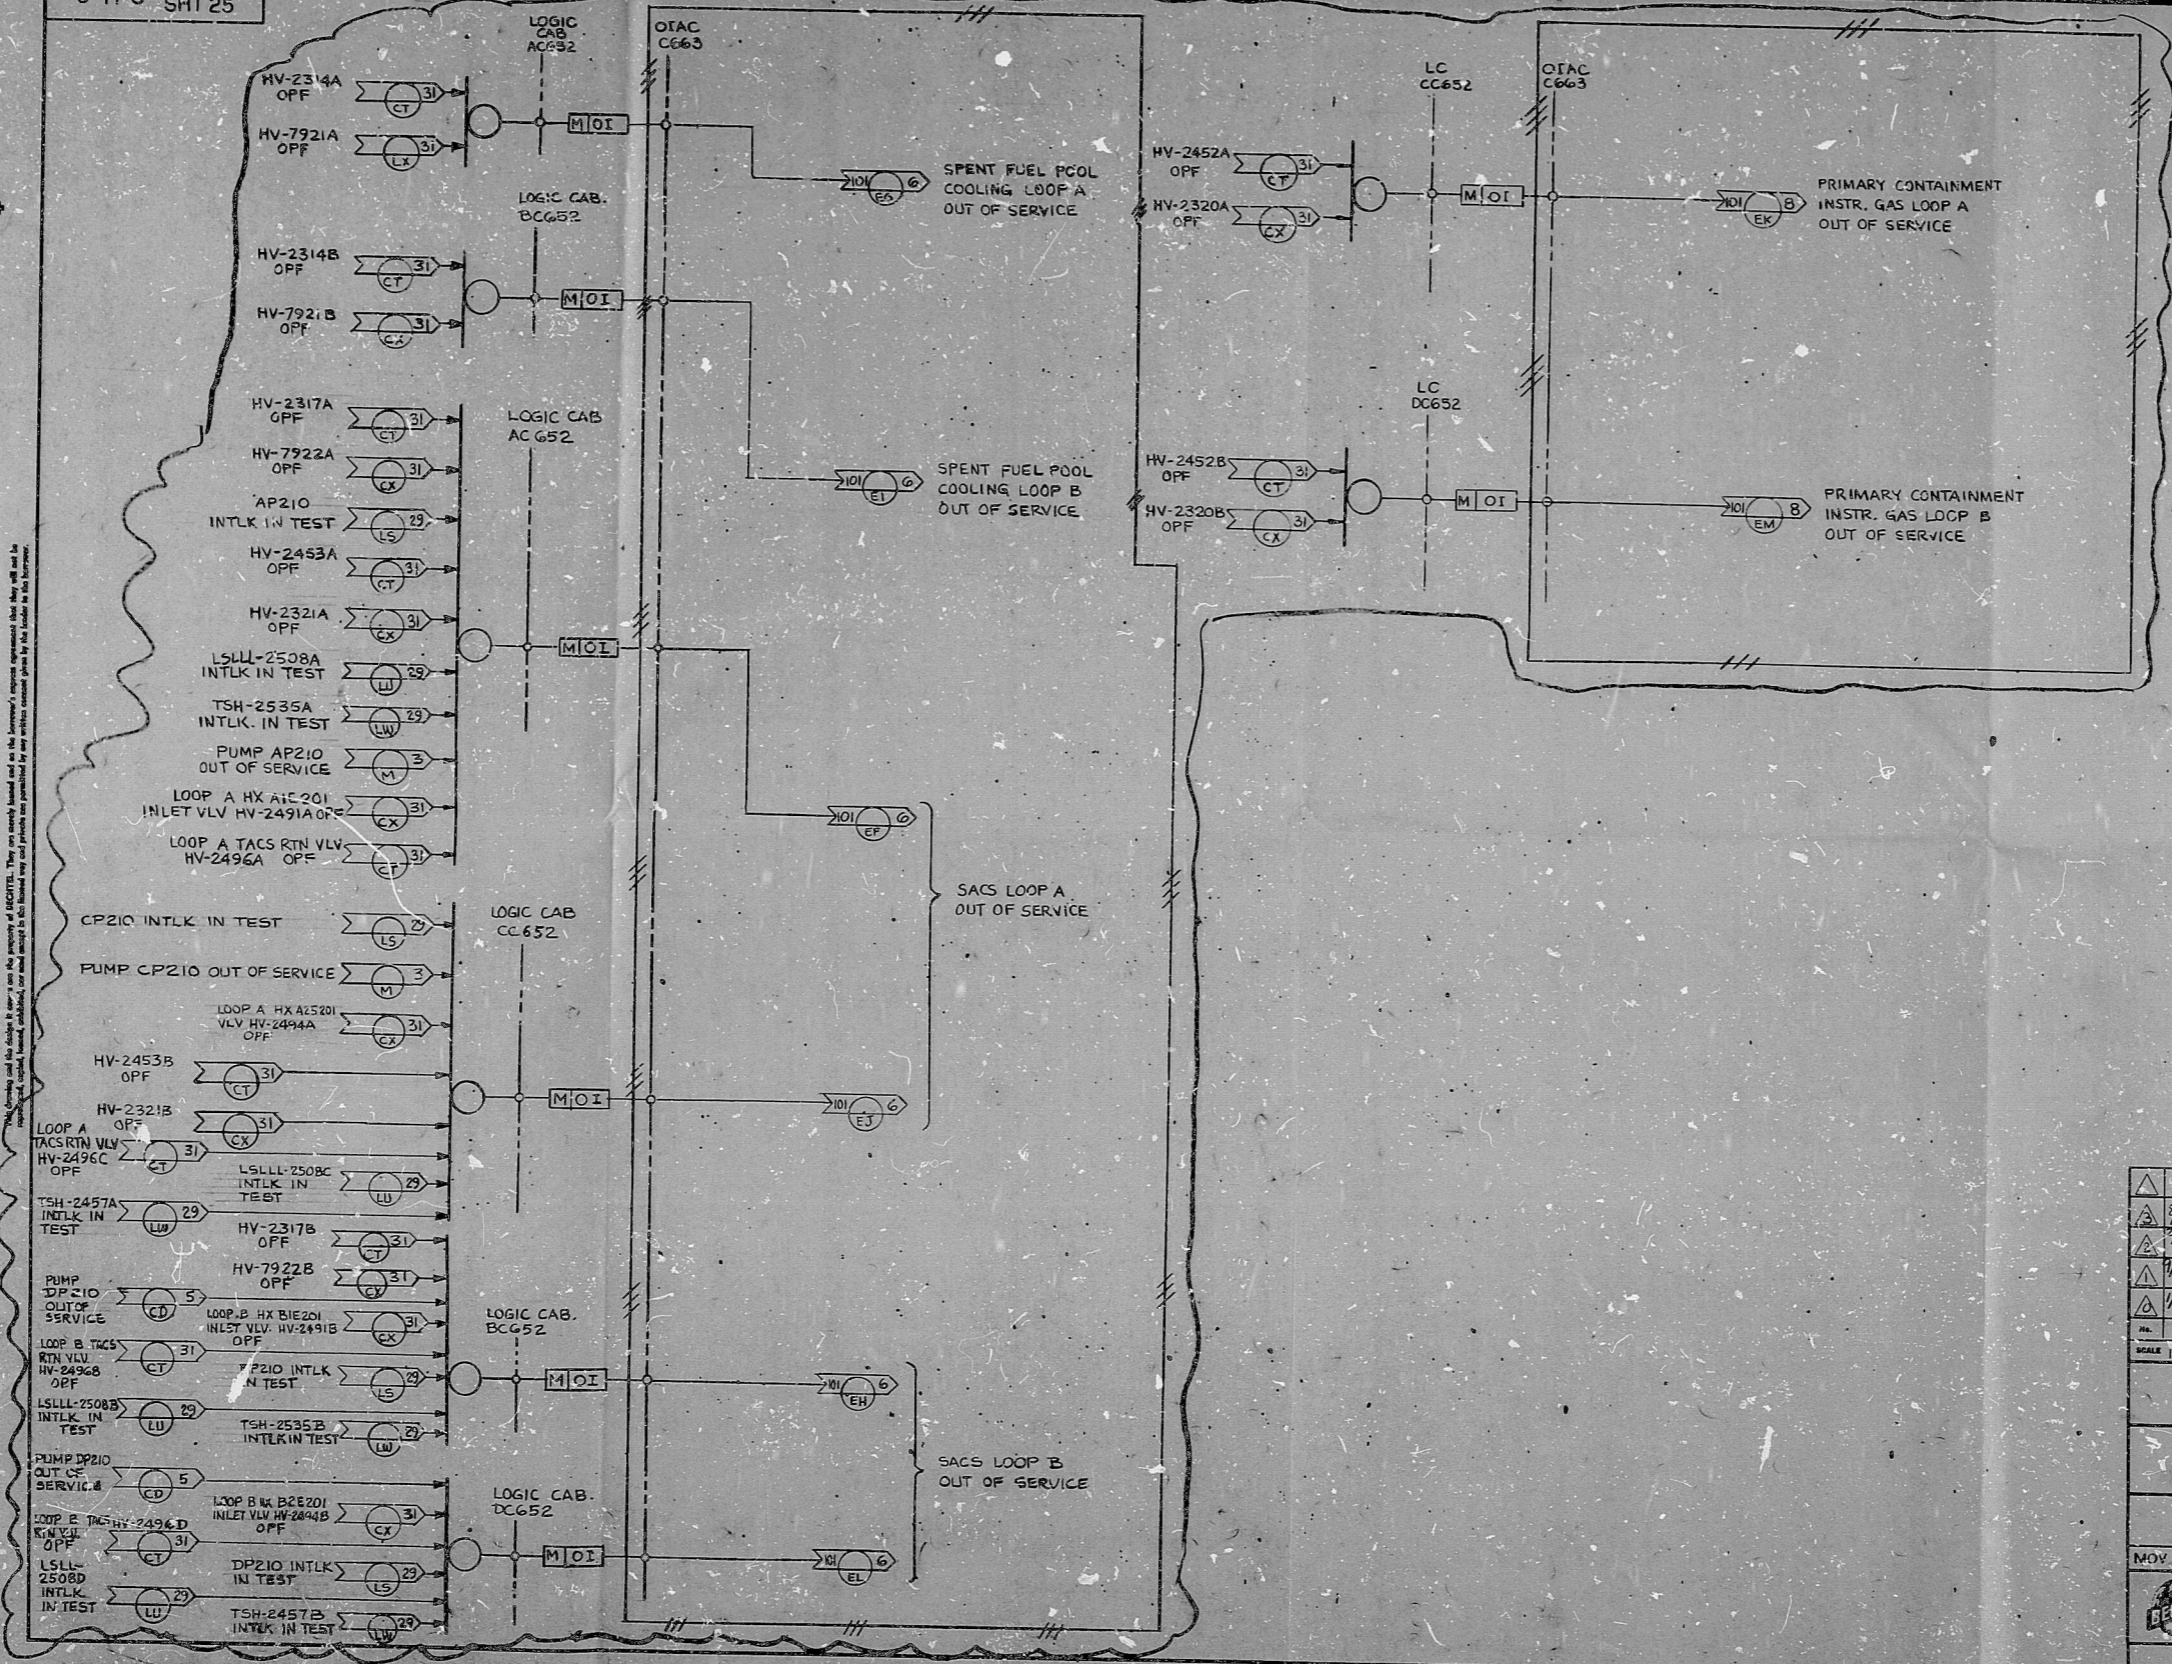

PRC APERTURE CARD

Δ	DESIGN FREEZE ISSUE & REDRAWN	SF	OP	DR	DR	DR	DR	DR	DR
Δ	REVISED BAILEY INTERFACE AND AS NOTED	S	S	S	S	S	S	S	S
Δ	INCORPORATED DCN#1	S	S	S	S	S	S	S	S
Δ	ISSUED FOR CONSTRUCTION THIS SHEET ADDED	S	S	S	S	S	S	S	S
NO.	DATE	REVISION	BY	CHKD	RECHK	DRWN	APPV		
SCALE	NONE	REGION	SF	DRAWN	SRF				
BECHTEL SAN FRANCISCO									
PUBLIC SERVICE ELECTRIC AND GAS COMPANY HOPE CREEK GENERATING STATION									
LOGIC DIAGRAM SAFETY AUXILIARIES COOLING MOV OVLO/PWR FAIL AND OUT OF SERVICE STATUS DISPLAY									
JOB NO.		DRAWING NO.		REV.					
10055		J-11-O SHT 25		3		Q			

RIDS

8307270484

