


J-110, 5HT33

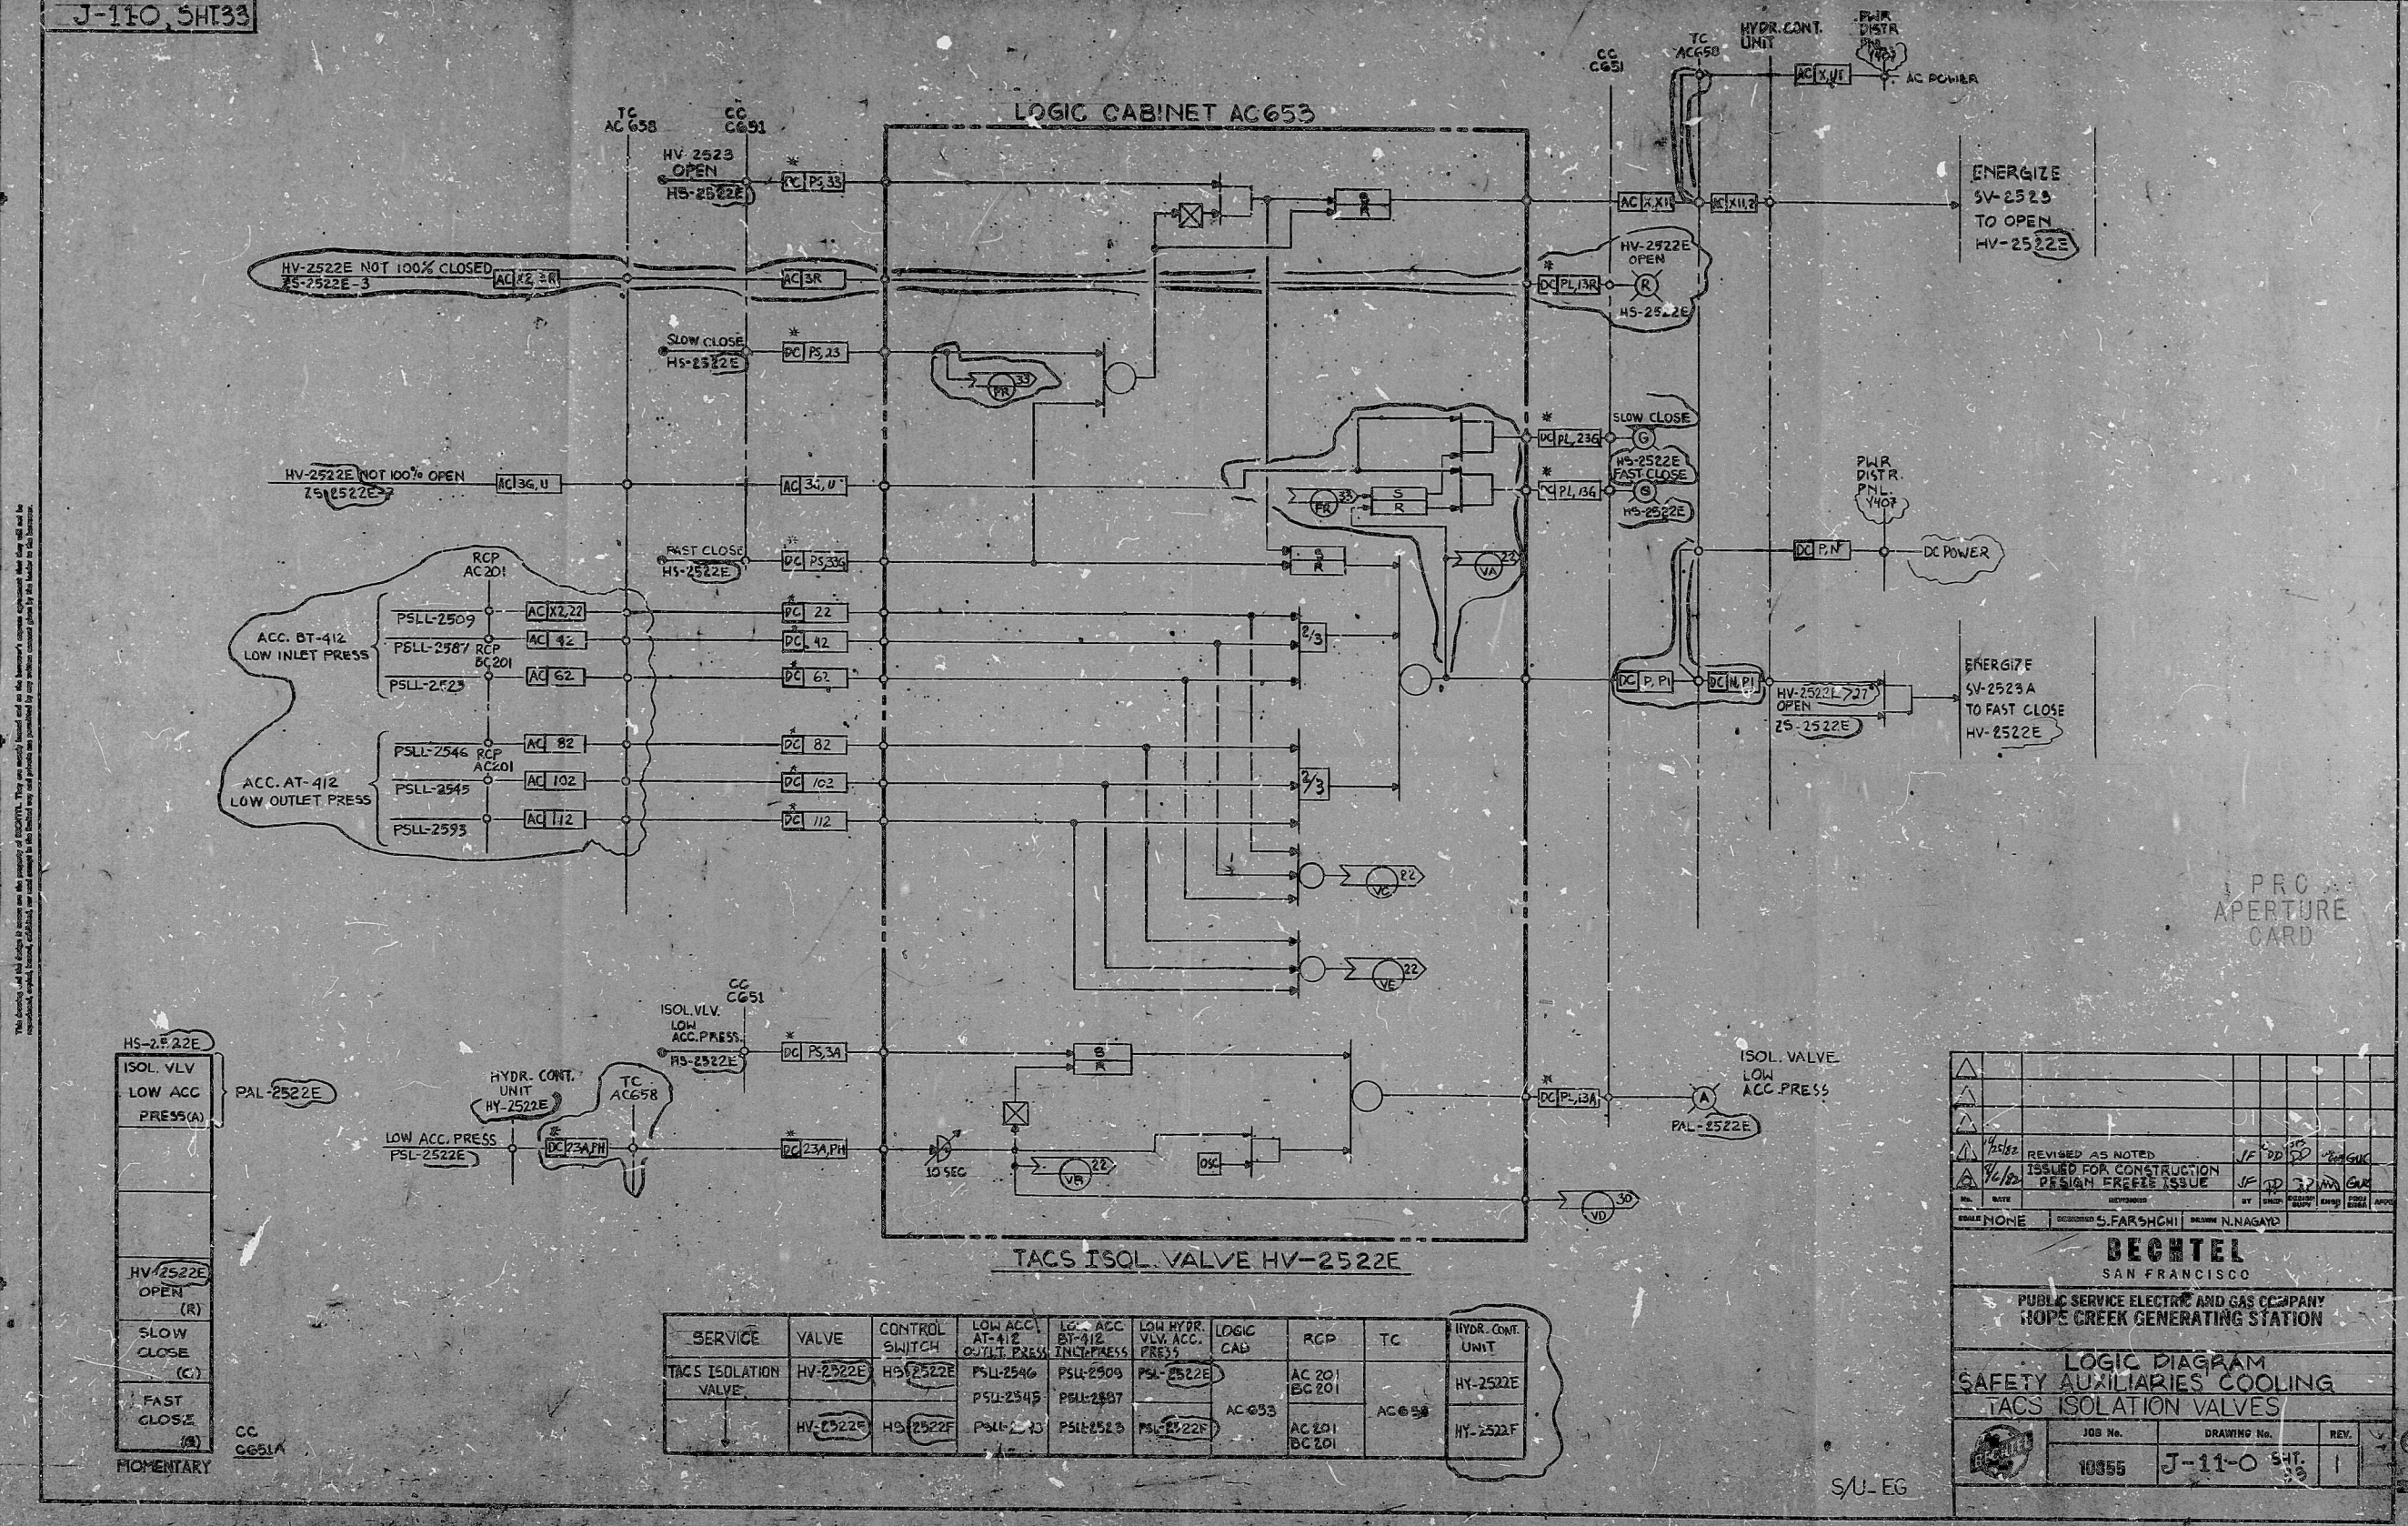

HS-2522E
 ISOL. VLV.
 LOW ACC.
 PRESS(A)
 PAL-2522E
 HV-2522E
 OPEN
 (R)
 SLOW
 CLOSE
 (C)
 FAST
 CLOSE
 (F)
 CC
 6651A

SERVICE	VALVE	CONTROL SWITCH	LOW ACC. AT-412 OUTLET PRESS.	LOW ACC. BY-412 INLET PRESS.	LOW HYDR. VLV. ACC. PRESS.	LOGIC CAB.	RCP	TC	HYDR. CONT. UNIT
TACS ISOLATION VALVE	HV-2522E	HS-2522E	PSL-2546	PSL-2509	PSL-2522E	AC 201 BC 201	AC 201 BC 201	AC 658	HY-2522E
	HV-2522F	HS-2522F	PSL-2545	PSL-2587	PSL-2522F	AC 653	AC 201 BC 201	AC 658	HY-2522F

PRO APERTURE CARD

NO.	DATE	REVISION	BY	CHECKED	APP'D
1					

BECHTEL
 SAN FRANCISCO
 PUBLIC SERVICE ELECTRIC AND GAS COMPANY
 ROPE CREEK GENERATING STATION
 LOGIC DIAGRAM
 SAFETY AUXILIARIES COOLING
 TACS ISOLATION VALVES
 JOB No. 10355 DRAWING No. J-11-0 5HT. 33 REV. 1

S/U-EG

RIDS

8307270493

