


22"  
11"  
11"  
11"  
8.5"  
11"  
17"  
8.5"  
11"  
22"

22"  
11"  
11"  
11"  
8.5"  
11"  
17"  
8.5"  
11"  
22"

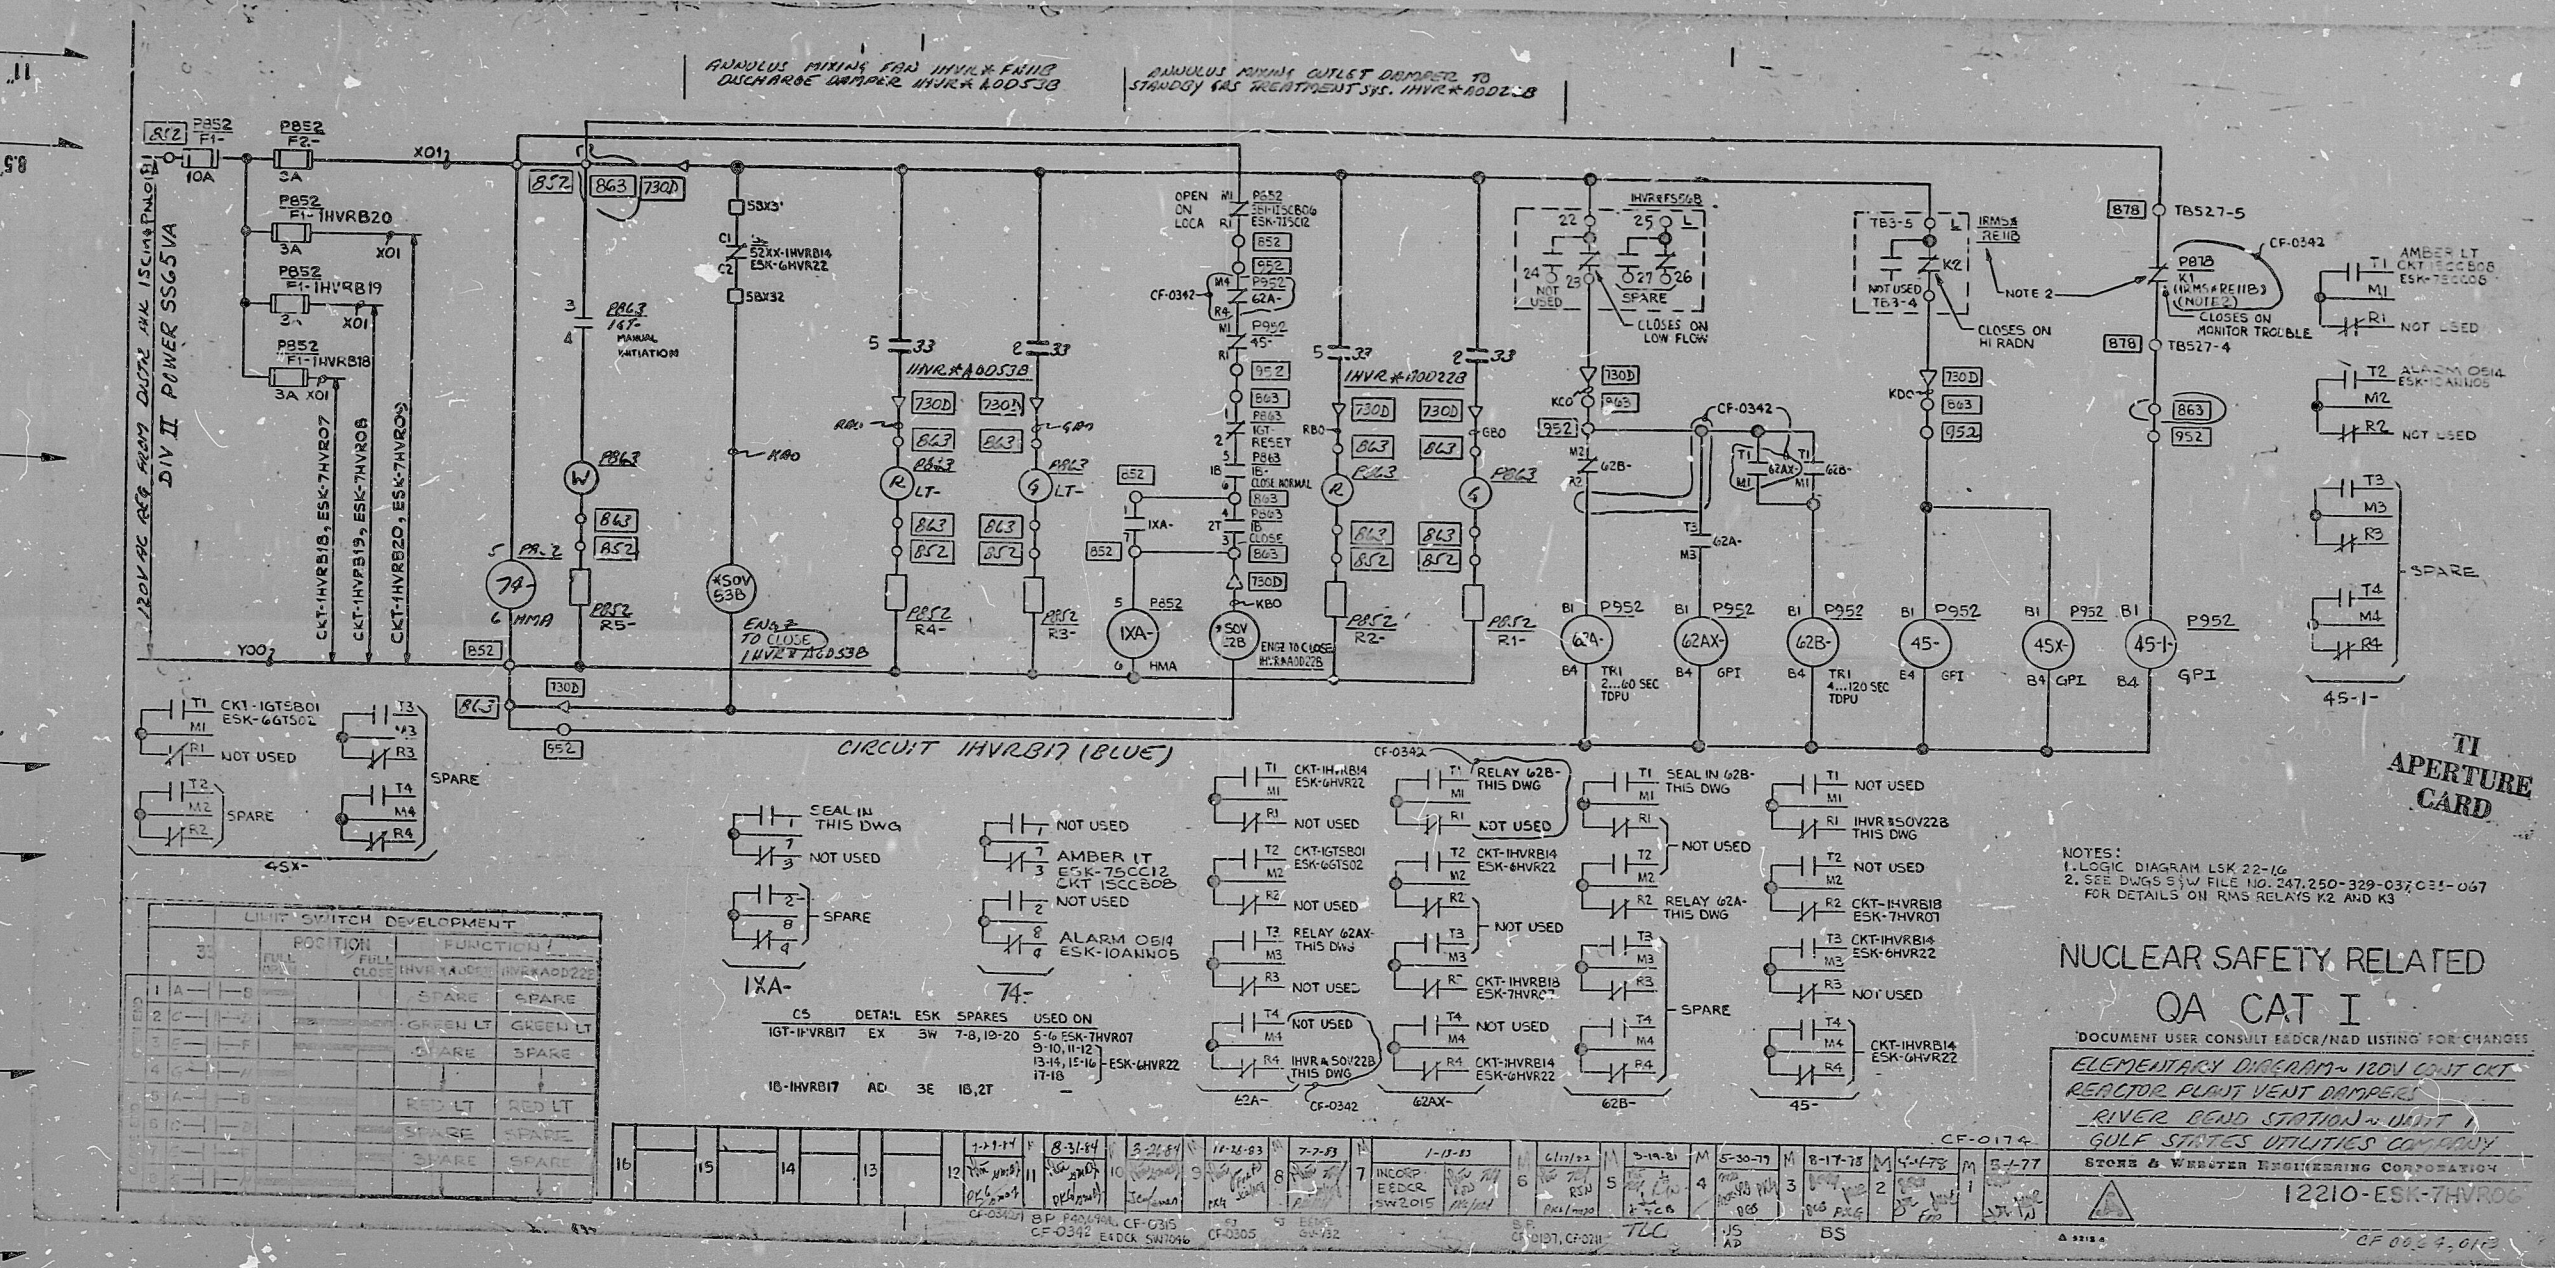

FOR INFORMATION ONLY



84/2/80052

PDR RIDS

