


007.001.011 SYSTEM
 007.001.002 CENTRIFUGAL CHARGING PUMP 2A
 007.001.003 CENTRIFUGAL CHARGING PUMP 2B

ITEM NUMBERS

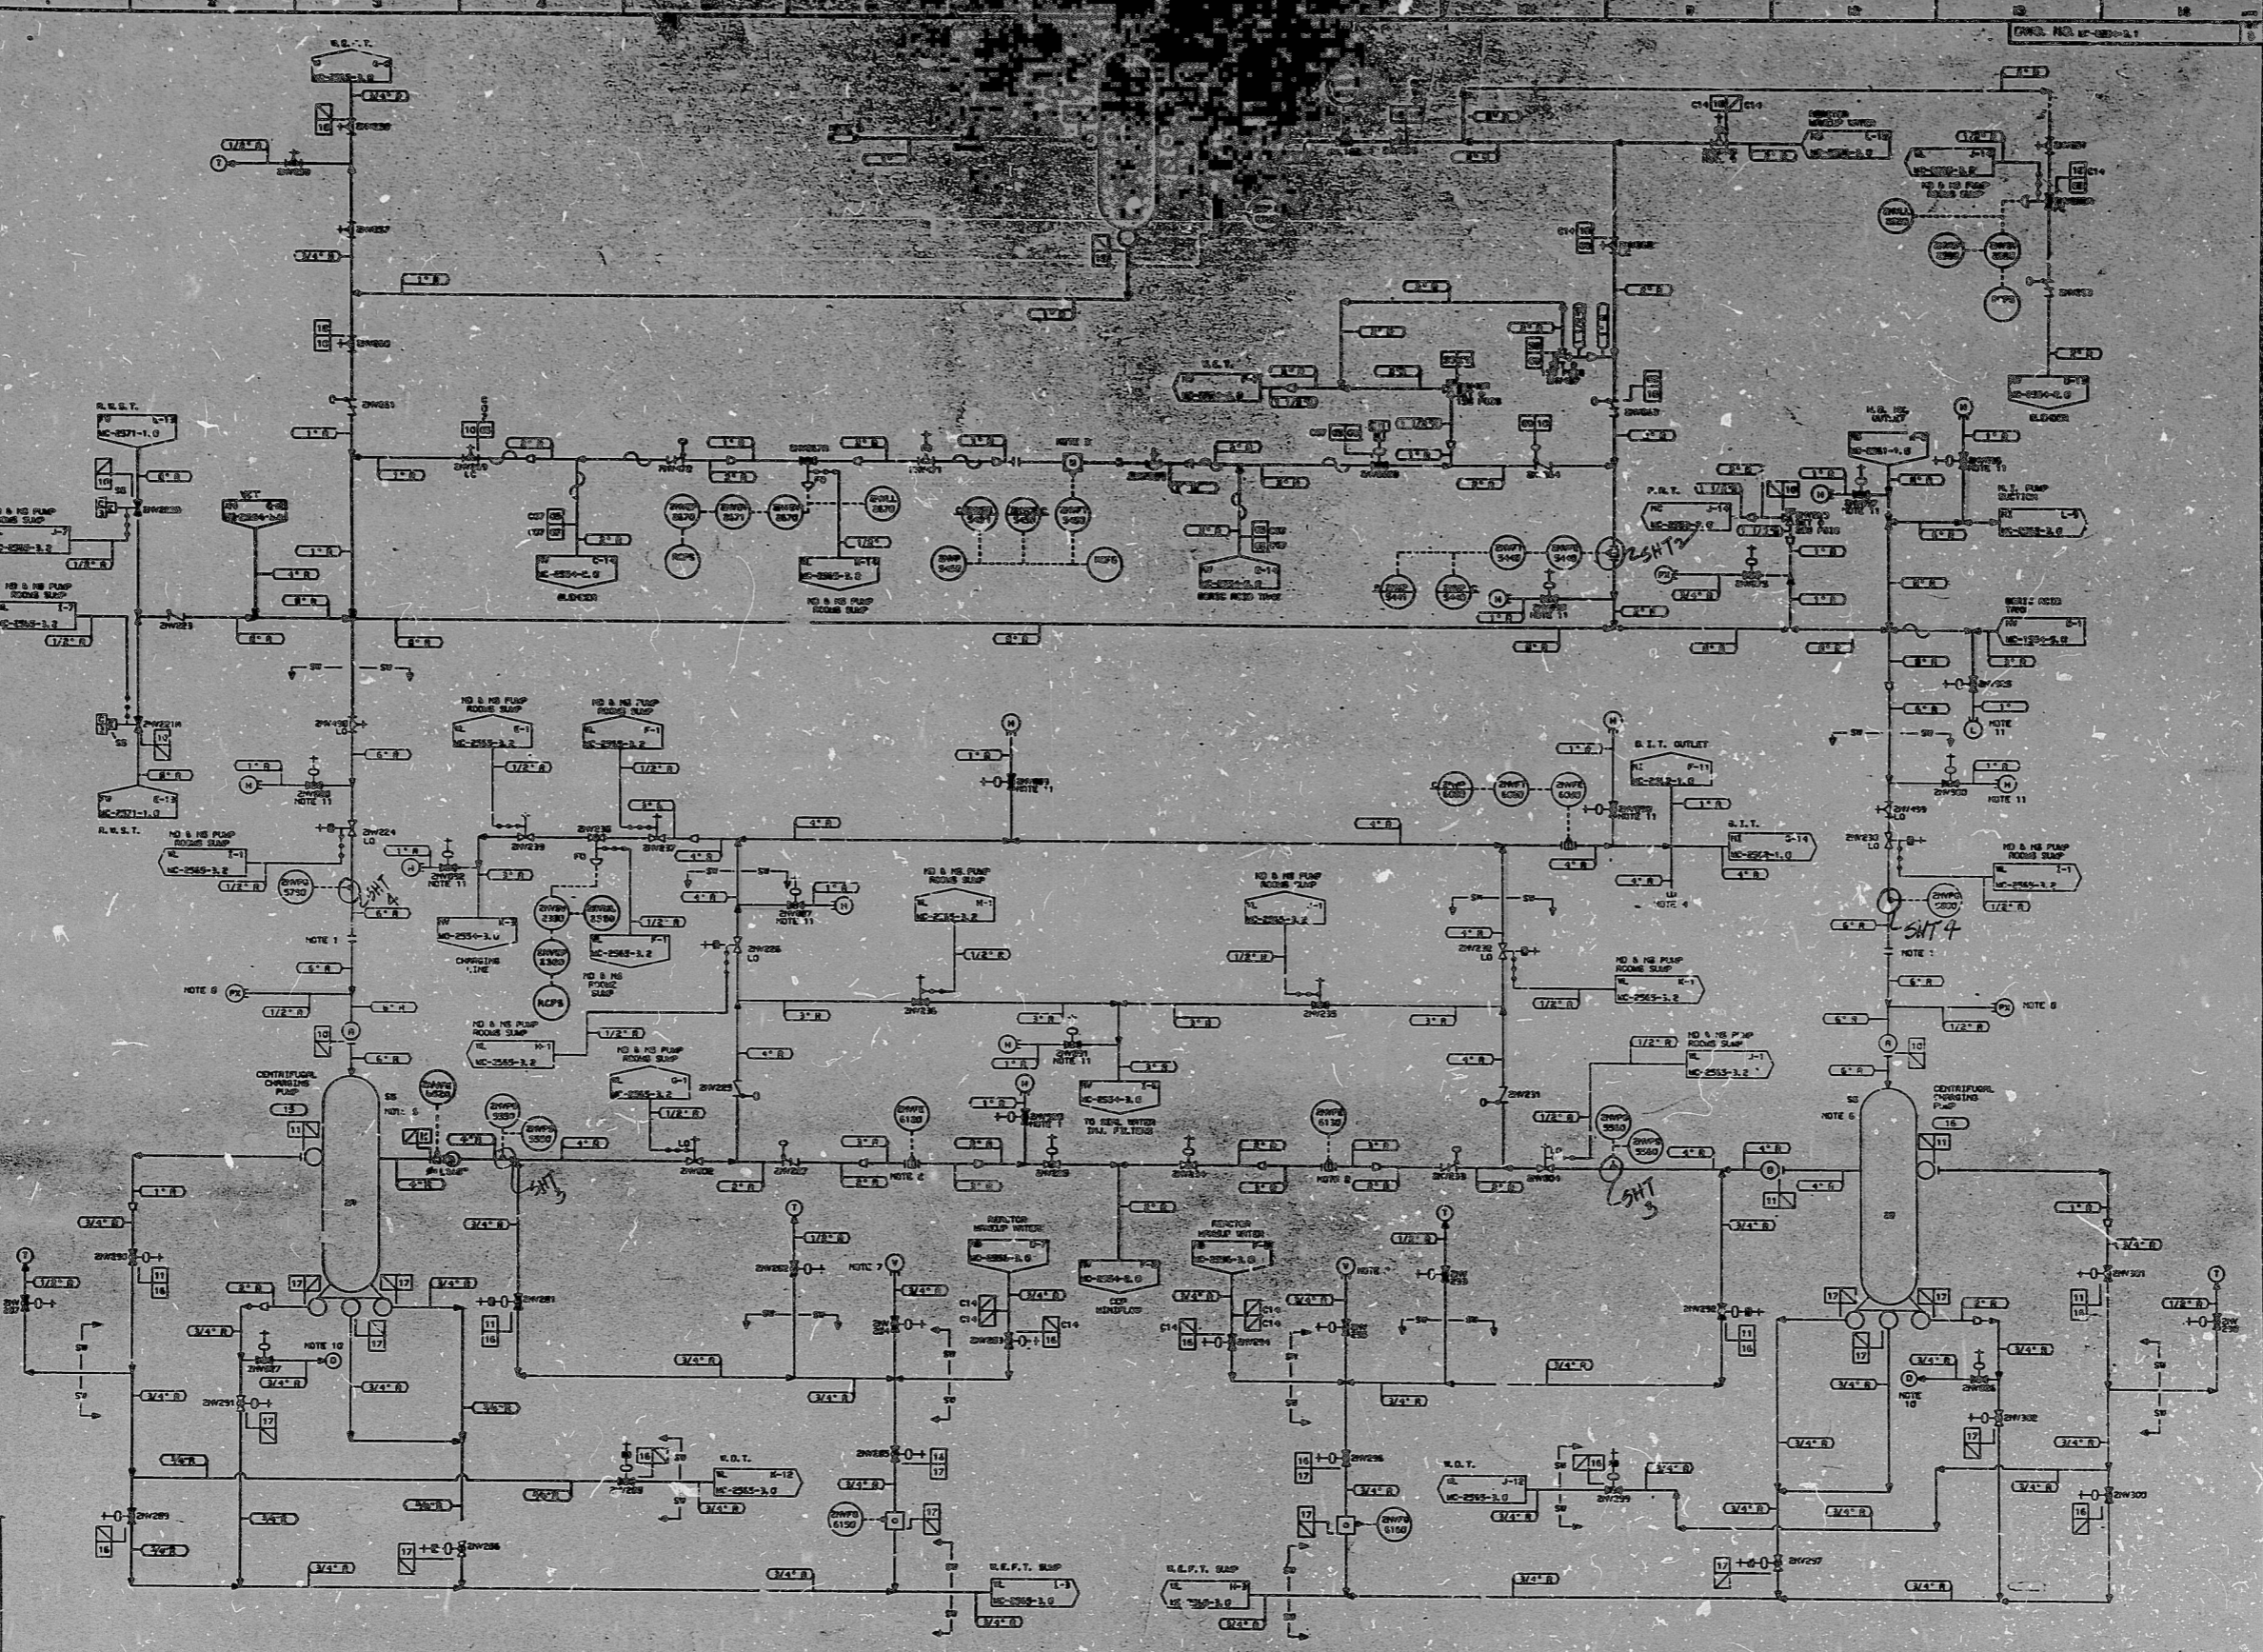

- NOTES:

FOR INFORMATION ONLY

SI APERTURE CARD

ON CONDITION 2
ON CONDITION 1

DUKE POWER COMPANY

FLOW DIAGRAM OF
CHARGING PUMP SYSTEM CONTROLS
ATTENTION (HW)

CL 2 44 DRD SHT 1

8904030402

PDR RIDS

