


i Added "As - Built - Stemp

REVISIONS

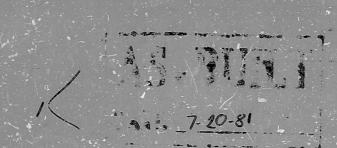

NUCLEAR SAFETY RELATED EXCLUSIONS

- 1. FITTIMES, TUDINGS, PIPING & VALVES CHOT PART OF A

7.30 (OW) 7.363 N/R C/M N/R

- 2. INSTRUMENTS (DO NOT SERVE A SAFETY FUNCTION)
 - a) 2NVPG5550, 2NVPS5550 b) 2NVPG5560, 2NVPS5560

/ QA CONDITION I

NUCLEAR SAFETY RELATED

MCGUIRE NUCLEAR STATION UNIT 2

INSTRUMENT DETAIL
CENTRIFUGAL CHARGING PUMP
DISCHARGE PRESSURE

DWG. NO. MC-2499-NV52 FOR INFORMATION ONLY

CL-ZHyBRO

31 APERTURL CARD

- 1. SLOPE IMPULSE LINE DOWNING FROM PROCESS TAP TO INSTRUMENT A MINIMUM OF 1/4" PER FOOT.
- 2. FITTINGS, TUBINGS, AND VALVES DESIGNATED ON THIS DETAIL BY CLASSIFICATION 1: OF THE FITTINGS CLASSIFICATION LIST ARE SAFETY CLASS. SUBSTITUTES FROM OTHER CLASSIFICATIONS ARE NOT PERMITTED.

FUNCTIONAL DESCRIPTIONS (A APPLIES TO B)

8904030413

PDR RIDS

