


GENERAL ELECTRIC 828E531AA
 ELEM DIAG
 REACTOR PROTECTION SYSTEM

RPS SYS A PWR LOSS OR INPUT OR OUTPUT CARD OUT OF SERVICE
 24VDC ISOLATOR PWR LOSS OR INPUT OR OUTPUT CARD OUT OF FILE
 RPS SYS B PWR LOSS OR INPUT OR OUTPUT CARD OUT OF SERVICE
 24VDC ISOLATOR PWR LOSS OR INPUT OR OUTPUT CARD OUT OF FILE
 24VDC ISOLATOR PWR LOSS OR INPUT OR OUTPUT CARD OUT OF SERVICE
 RECIRC PUMP TRIP SYS A MANUAL BYPASS
 RECIRC PUMP TRIP SYS B MANUAL BYPASS

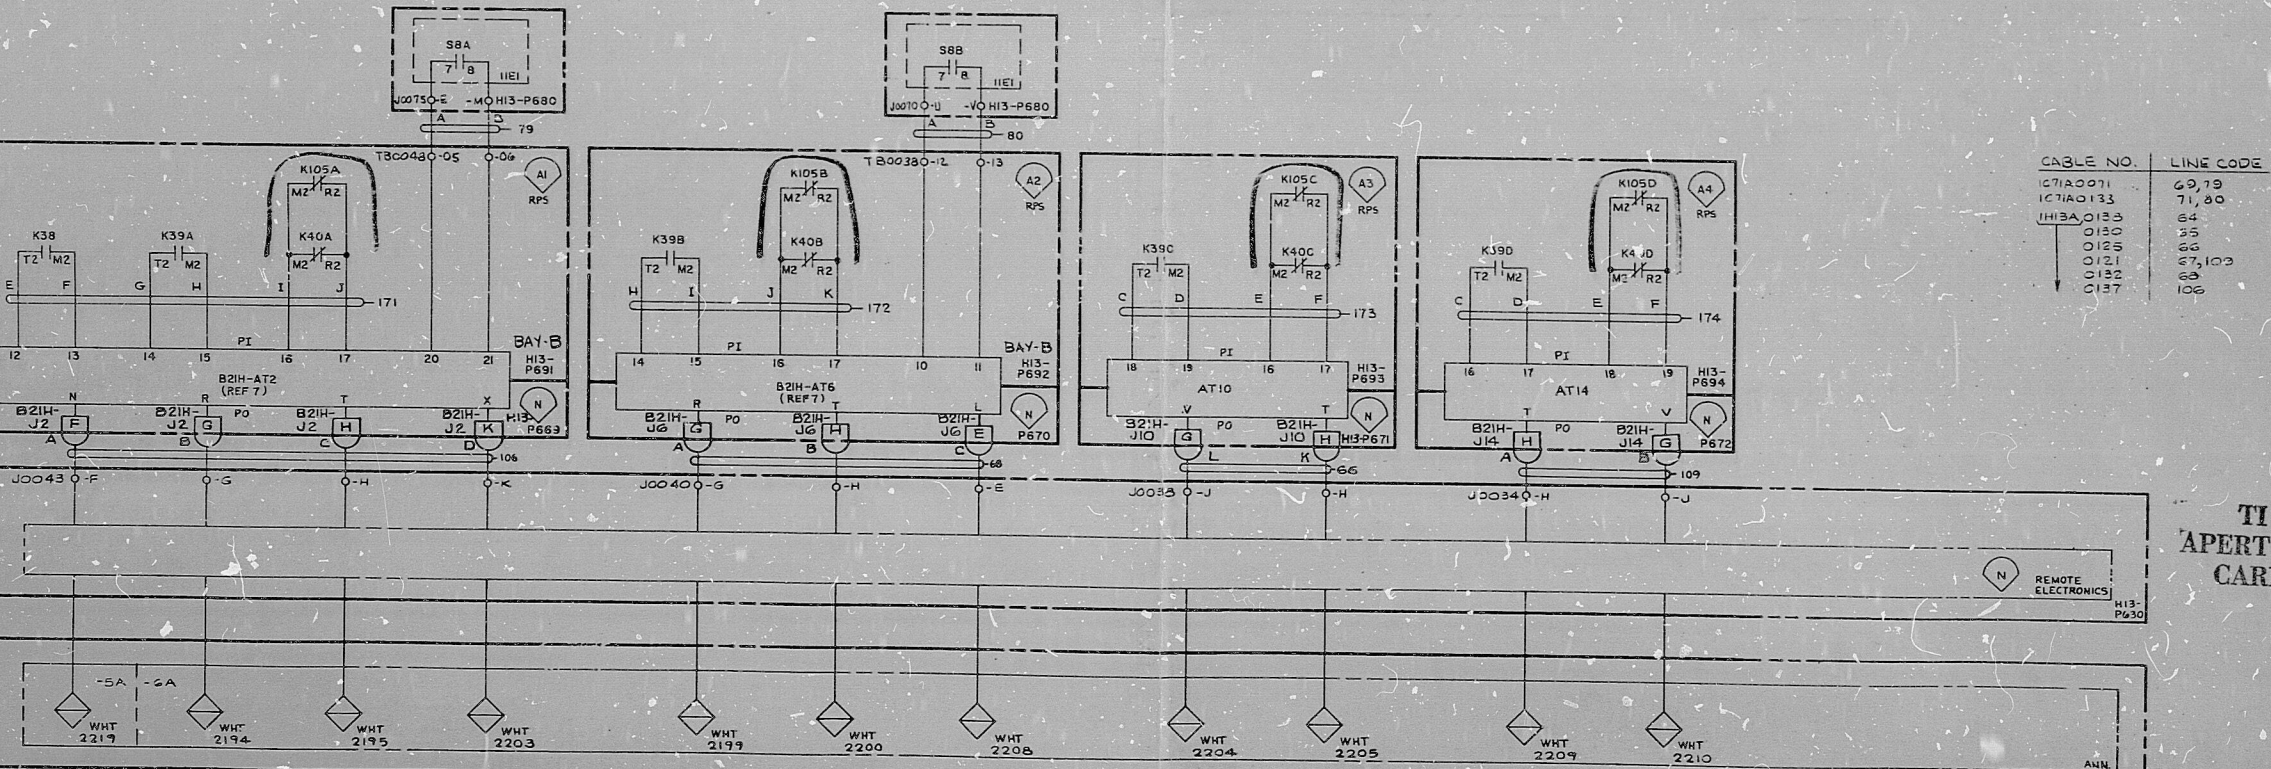

CABLE NO.	LINE CODE
O137	106

TRIP UNIT IN CAL OR GROSS FAILURE (NON SAFETY)
 TRIP UNIT IN CAL OR GROSS FAILURE (SAFETY)
 TRIP UNIT OUT OF FILE OR POWER FAILURE
 SYS OUT OF SERVICE SW A ACTIVATED
 TRIP UNIT IN CAL OR GROSS FAILURE
 TRIP UNIT OUT OF FILE OR POWER FAILURE
 SYS OUT OF SERVICE SW B ACTIVATED
 TRIP UNIT IN CAL OR GROSS FAILURE
 TRIP UNIT OUT OF FILE OR POWER FAILURE
 TRIP UNIT IN CAL OR GROSS FAILURE
 TRIP UNIT OUT OF FILE OR POWER FAILURE
 TRIP UNIT IN CAL OR GROSS FAILURE
 TRIP UNIT OUT OF FILE OR POWER FAILURE

TI APERTURE CARD

LINE CODES: 64-69, 71, 79, 80, 106, 109, 171-174

REV.	DATE	BY	CHKD.	APP.	REVISION
6	NUJ36259	12-10-87			
9	NUJ41765 A3	11-27-97			
		12-29-90			
		12-28-90			
		12-27-97			
		12-27-92			

828E531AA
 12 CHAS ST. V. BEAT
 12 15 15
 CI EIS

PDR RIDS

8412180165

