POOR ORIGINAL

APPROX. 155 L.F.

GUIDE	RESTRAINT	
SPRING HANGER	RIGID HANGER	ANCHOR
DIRECTION OF RESTRAINT	DIRECTION OF EXPANSION	SNUBBER

NOTES:

1. ALL PIPING TO BE FABRICATED AND ERECTED IN ACCORDANCE WITH SPECIFICATION(S) 7220-M-209, 44.4.0, AS.2.0.
2. FOR MATERIAL DESCRIPTION OF PIPE, VALVES AND FITTINGS, SEE PIPING CLASS SHEET(S) NO. M-481.
3. FOR PIPING AND INSTRUMENT DIAGRAM SEE DWG. M-406 SH-1
4. FOR EQUIPMENT LIST SEE M-485.
5. FOR INSTRUMENT CONNECTION DETAIL SEE DRAWING M-483.
6. NO ALLOWANCE HAS BEEN MADE FOR WELDED JOINTS OR GASKETS AND ALL PIPING IS DIMENSIONED IN THE COLD ERECTED POSITION UNLESS OTHERWISE NOTED ON THE DRAWING.
7. FOR PIPING SYSTEM COMPOSITE DRAWING(S) THIS AREA SEE M-34 on 8 1/2, M-35 on 2, M-36 on 2.
8. FOR INSULATION SCH. SEE DWG. M-466.
9. PIPE BEND RADII UNLESS OTHERWISE NOTED HAVE A MINIMUM CENTERLINE RADIUS OF FIVE (5) TIMES THE NOMINAL PIPE DIAMETER.
10. FOR PIPING AND INSTRUMENT SYMBOLS SEE DWG. M-460 THRU SH'S.
11. FIELD WELD JOINTS WHERE SPECIFICALLY REQUIRED ARE INDICATED (FW).
12. FOR VENTS AND DRAINS SEE DRAWING M-482. VENTS ARE INDICATED (V) AND (D).
13. ALL FACE TO FACE AND END TO END DIM. OF FIRE PROTECTION VALVES ARE PER ANSI B16.10. UNLESS OTHERWISE NOTED.
14. ◇ INDICATES REACTOR BUILDING EXTERIOR WALL PENETRATION.
15. ▭ INDICATES FLOOR OR WALL PENETRATION.
16. INDICATES DIMENSION TO N.C.V.D. DATUM NORTH-SOUTH AND EAST-WEST AXIS.

△2 HANGERS INDICATED ON THIS ISO ARE BECHTEL DESIGNED HANGERS FOR ALLOTTED HANGERS THIS DWG SEE GRINNELL HANGER DWG. GH-604 SH. 11.

NO.	REVISION	BY	CHK	APP	DATE
4	6-1-81 REVISED TO REFLECT AS-BUILT CONDITIONS				
3	7-14-80 REVISED TO REFLECT REV 9 OF M-150 & REV 5 DATA PF 362				
2	5-9-79 REVISED TO REFLECT M-150				
1	12-14-78 REVISED TO AGREE WITH M-604 SH. 11				
0	12-14-78 ISSUED FOR SUPPORT FAB.				

MATERIAL NONE ISSUED FOR CONSTRUCTION DRAWN A.A.L.

BECHTEL
ANN ARBOR, MICHIGAN

MIDLAND PLANT UNITS 1 & 2
CONSUMERS POWER COMPANY

HANGER ISOMETRIC
MAKE-UP AND PURIFICATION
SYSTEM UNIT 2

JOB NO.	DRAWING NO.	REV.
7220	M-604 SH 11 (Q)	4

STRESS APPROVAL

THIS ISO | DATE | CHK | STRESS | DATE

TERA APERTURE CARD

I certify that ... reproduced on this frame ... in the regular course of business. ... an accurate ... submitted in ... the document

30X

RIDS

811R220202

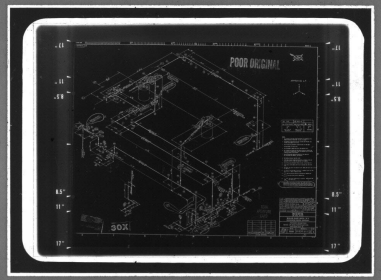

MMM 5824 — FILMSORT* Brand Aperture & Camera Cards and DUPLICARD* Brand Copy Cards — Product of 3M Company, St. Paul, Minn.