



H-604 SH16(Q)

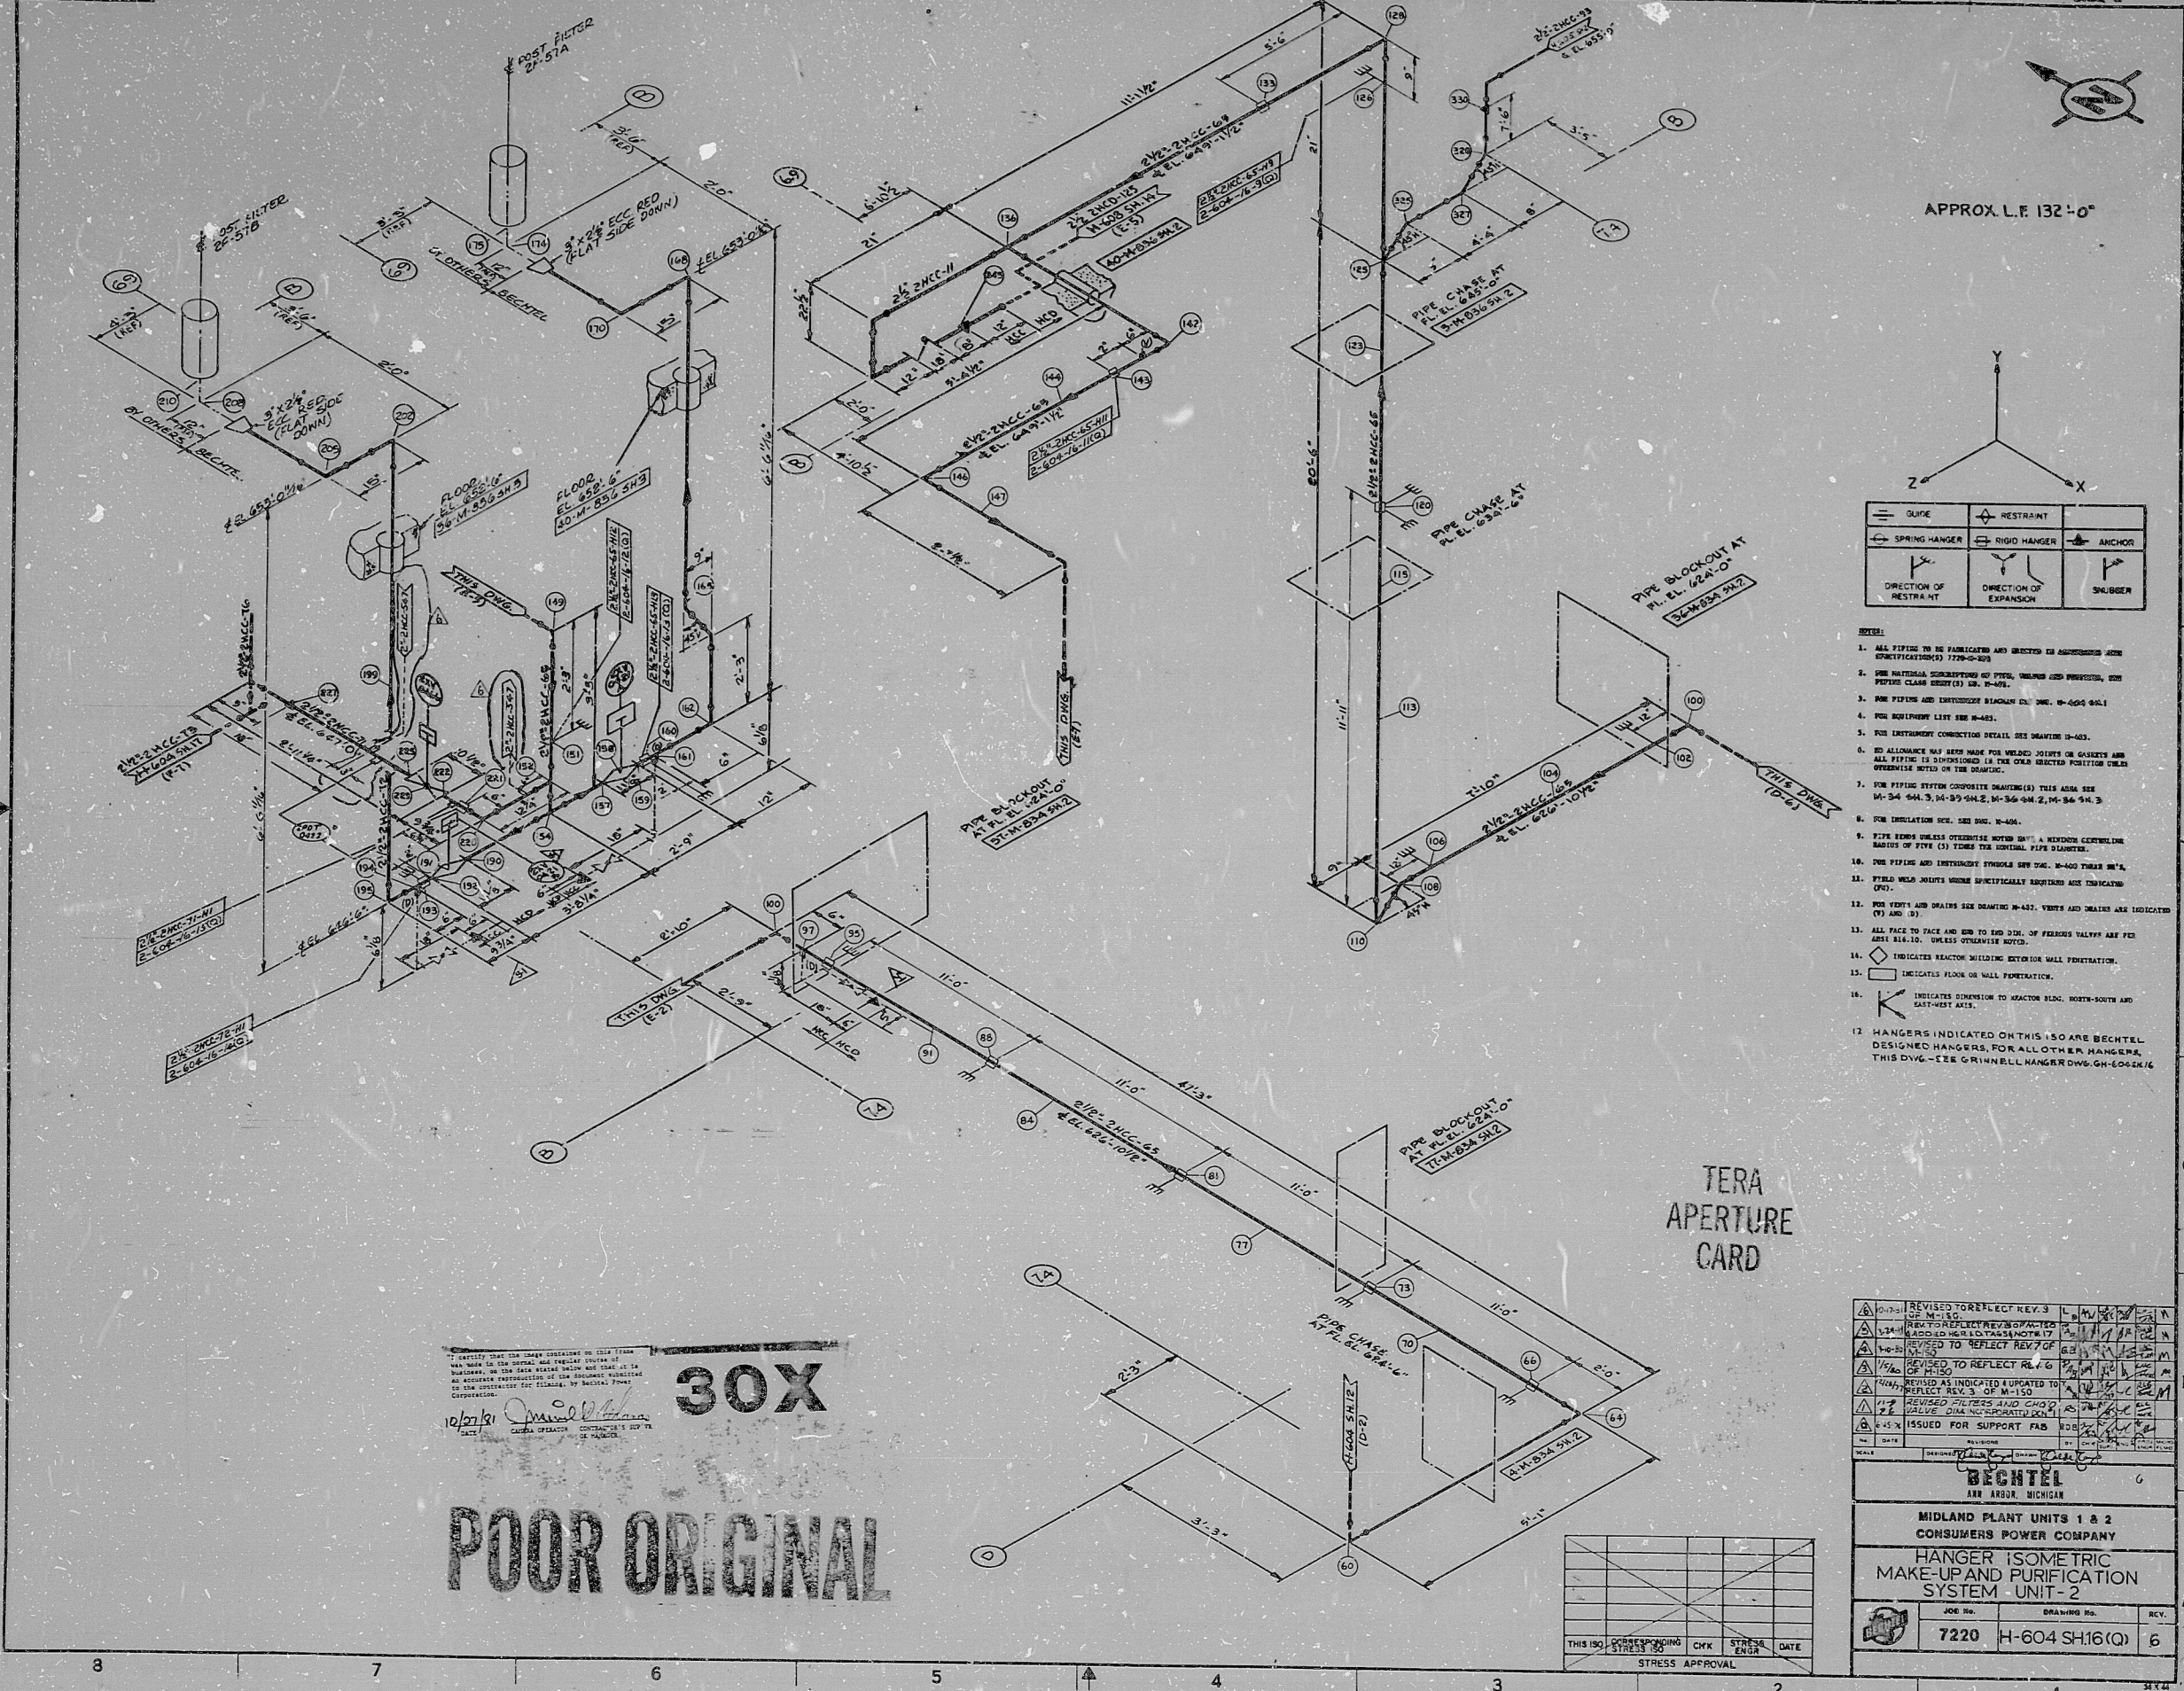

APPROX. L.F. 132'-0"

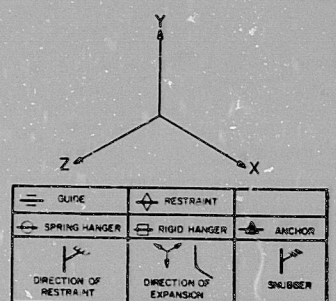

- NOTES:
1. ALL PIPING TO BE FABRICATED AND ERECTED IN ACCORDANCE WITH THE SPECIFICATIONS 1700-300.
 2. FOR MATERIAL DESCRIPTIONS OF PIPES, VALVES AND FITTINGS, SEE PIPELINE CLASS SPEC (P) OR M-401.

 11. FIELD WELD JOINTS SHALL BE SPECIFICALLY IDENTIFIED AND IDENTIFIED UPON.
 12. FOR VENTS AND DRAINS SEE DRAWING M-401. VENTS AND DRAINS ARE INDICATED (V) AND (D).
 13. ALL FACE TO FACE AND END TO END DIM. OF FLANGES VALVES ARE PER ANSI B16.10. UNLESS OTHERWISE NOTED.
 14. DIMENSIONS REACTOR BUILDING EXTERIOR WALL PENETRATION.
 16. K INDICATES CONNECTION TO REACTOR BLDG. NORTH-SOUTH AND EAST-WEST AXIS.
 17. HANGERS INDICATED ON THIS ISOMETRIC ARE BECHTEL DESIGNED HANGERS. FOR ALL OTHER HANGERS, THIS DWG. SEE GRINNELL HANGER DWG. GH-004-016.

TERA
APERTURE
CARD

30X
POOR ORIGINAL


THIS IS A CORRESPONDING	CHK	STRESS	DATE
STRESS APPROVAL	ENGR		

BECHTEL
ANN ARBOR, MICHIGAN

MIDLAND PLANT UNITS 1 & 2
CONSUMERS POWER COMPANY

HANGER ISOMETRIC
MAKE-UP AND PURIFICATION
SYSTEM UNIT-2

JOB NO. 7220
DRAWING NO. H-604 SH16(Q)
REV. 6

RIDS

8112220219

