


This drawing and the design it covers are the property of BECHTEL. They are hereby loaned and on the borrower's express agreement that they will not be reproduced, copied, loaned, exhibited, nor used, except in the limited way and under the written consent given by the lender to the borrower.

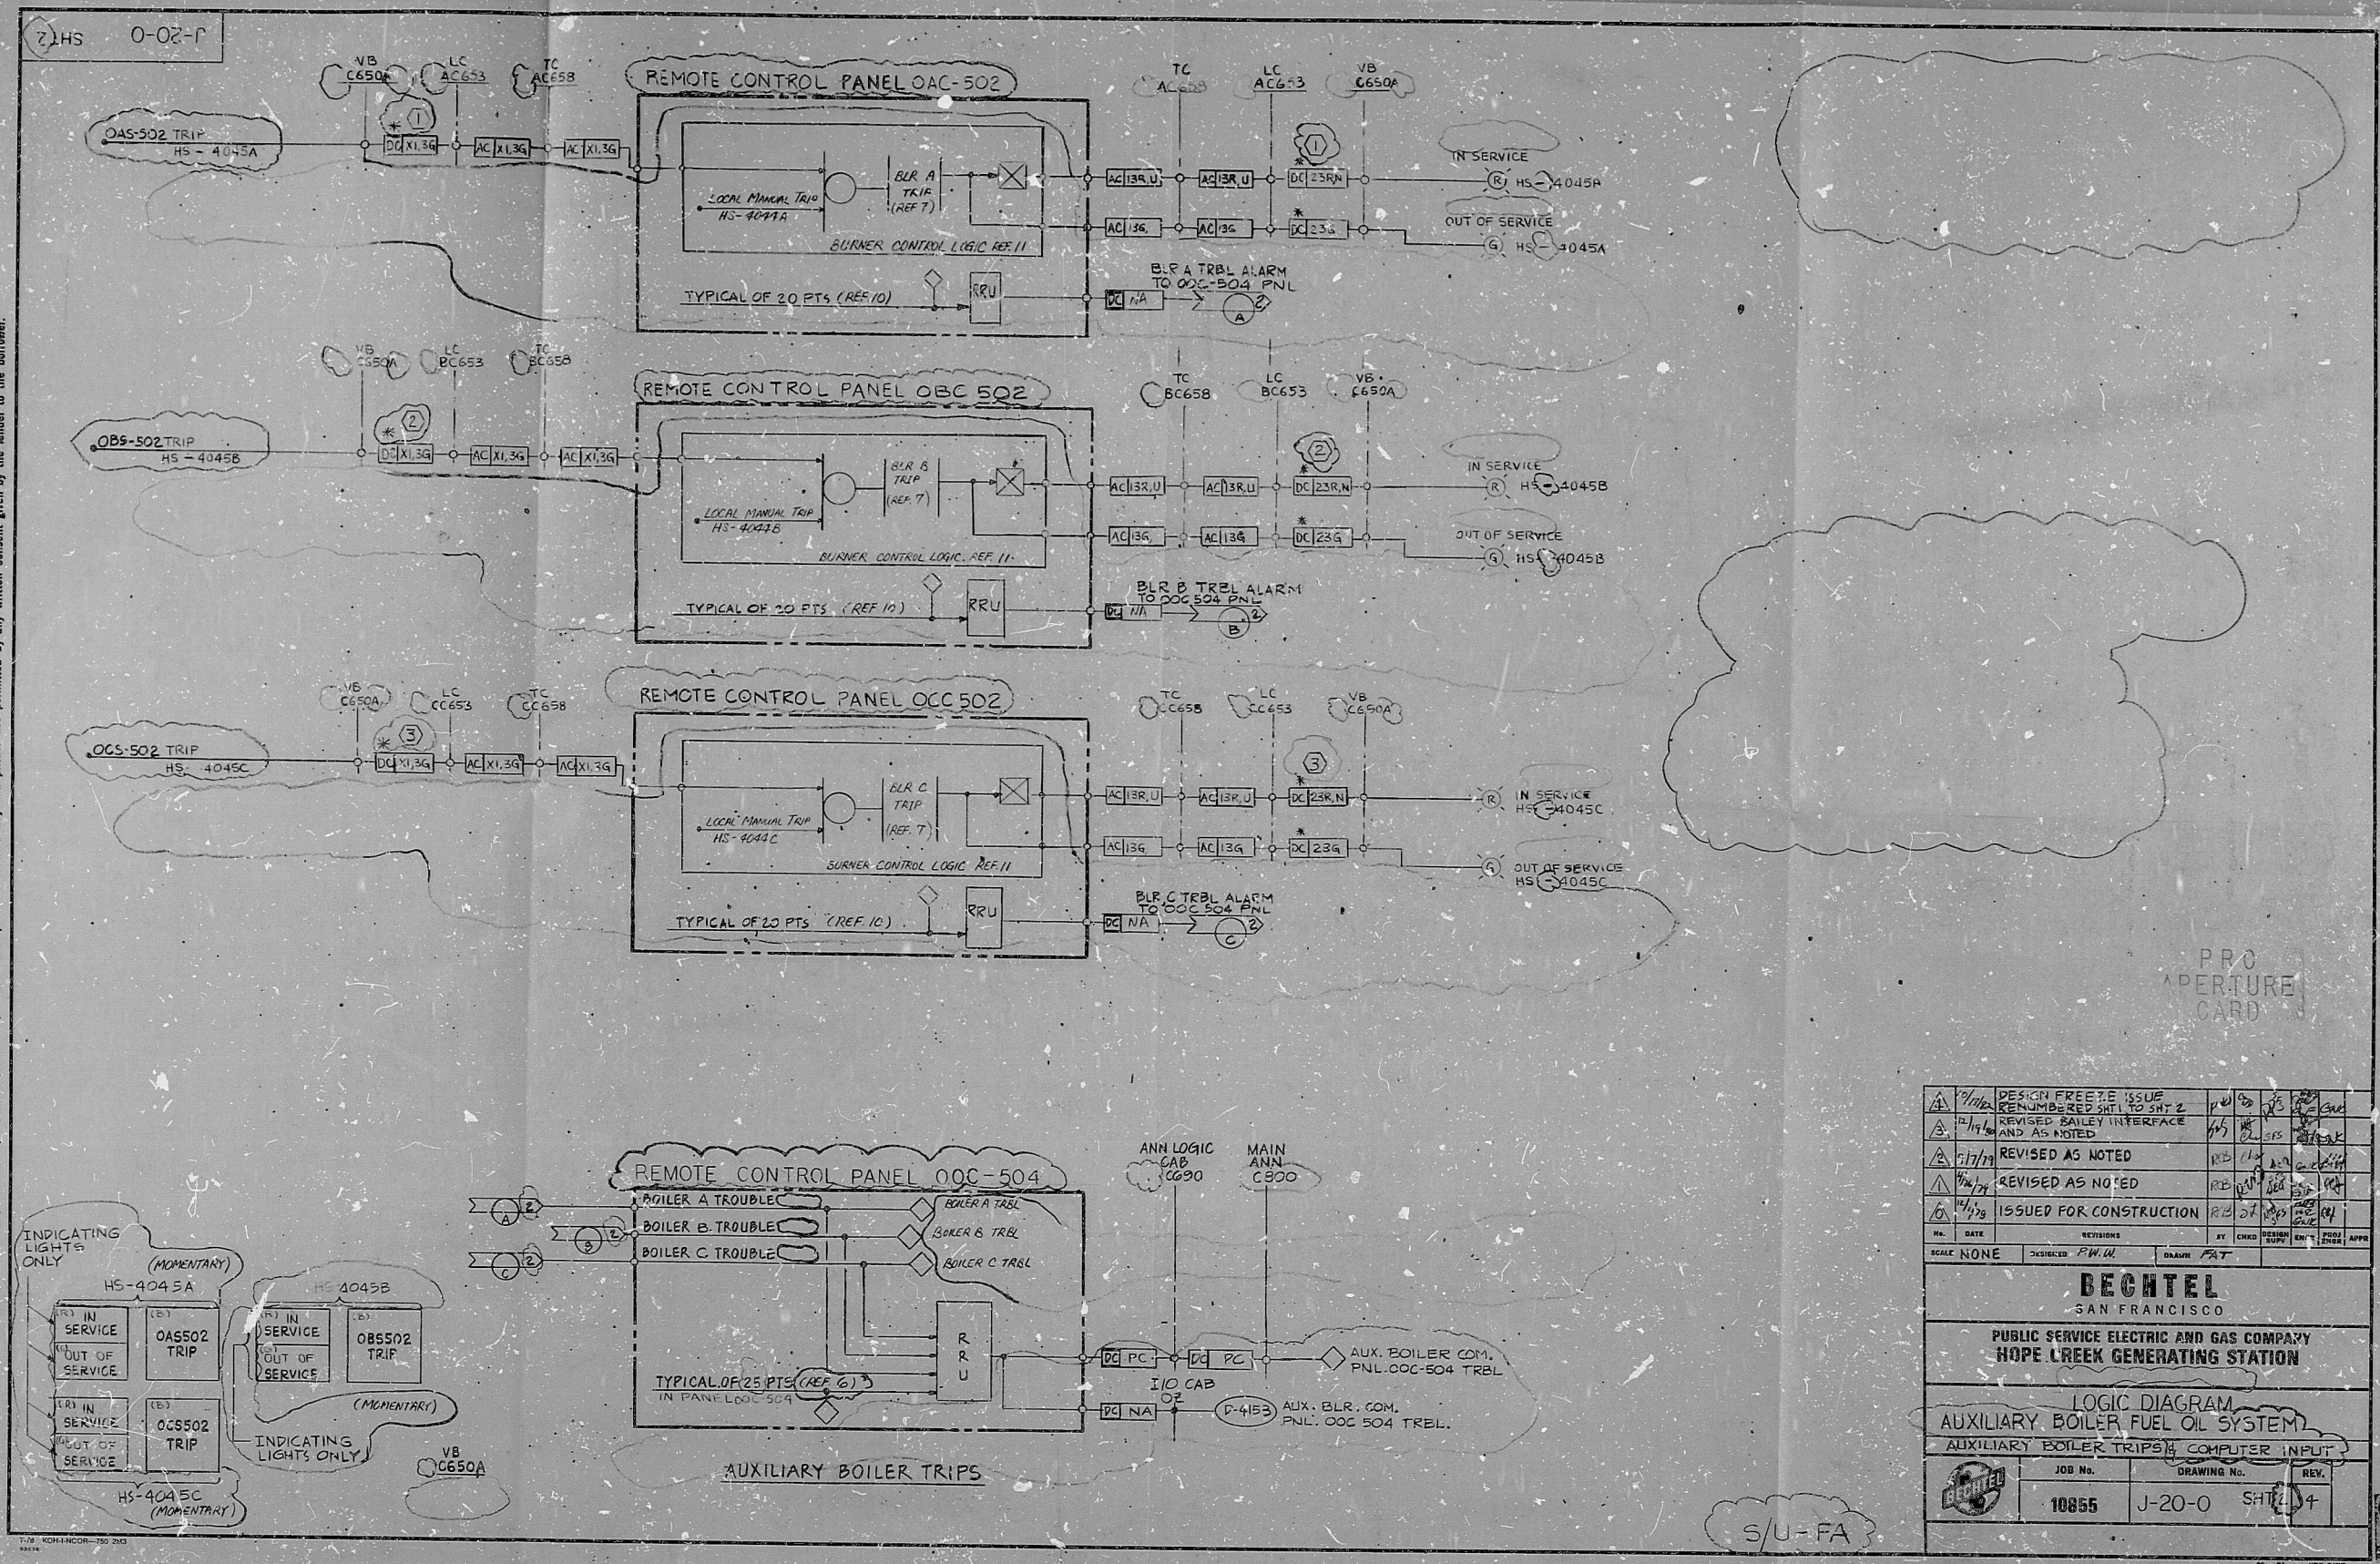

PRO  
APERTURE  
CARD

No.	DATE	BY	CHKD	DESIGN	ENT	PROJ	APPV						
SCALE	NONE	DESIGNED	FWU	DRAWN	AT								
<b>BECHTEL</b> SAN FRANCISCO													
PUBLIC SERVICE ELECTRIC AND GAS COMPANY HOPE CREEK GENERATING STATION													
LOGIC DIAGRAM AUXILIARY BOILER FUEL OIL SYSTEM													
AUXILIARY BOILER TRIP COMPUTER INPUT													
JOB No.		DRAWING No.		REV.									
10855		J-20-0		SHT 2/4									

S/U-FA

22"  
17"  
11"  
9.5"  
8.5"  
11"  
17"  
22"

22"  
17"  
11"  
9.5"  
8.5"  
11"  
17"  
22"



RIDS

8307270535

