


H-611 SH1 (Q)

SIZE E

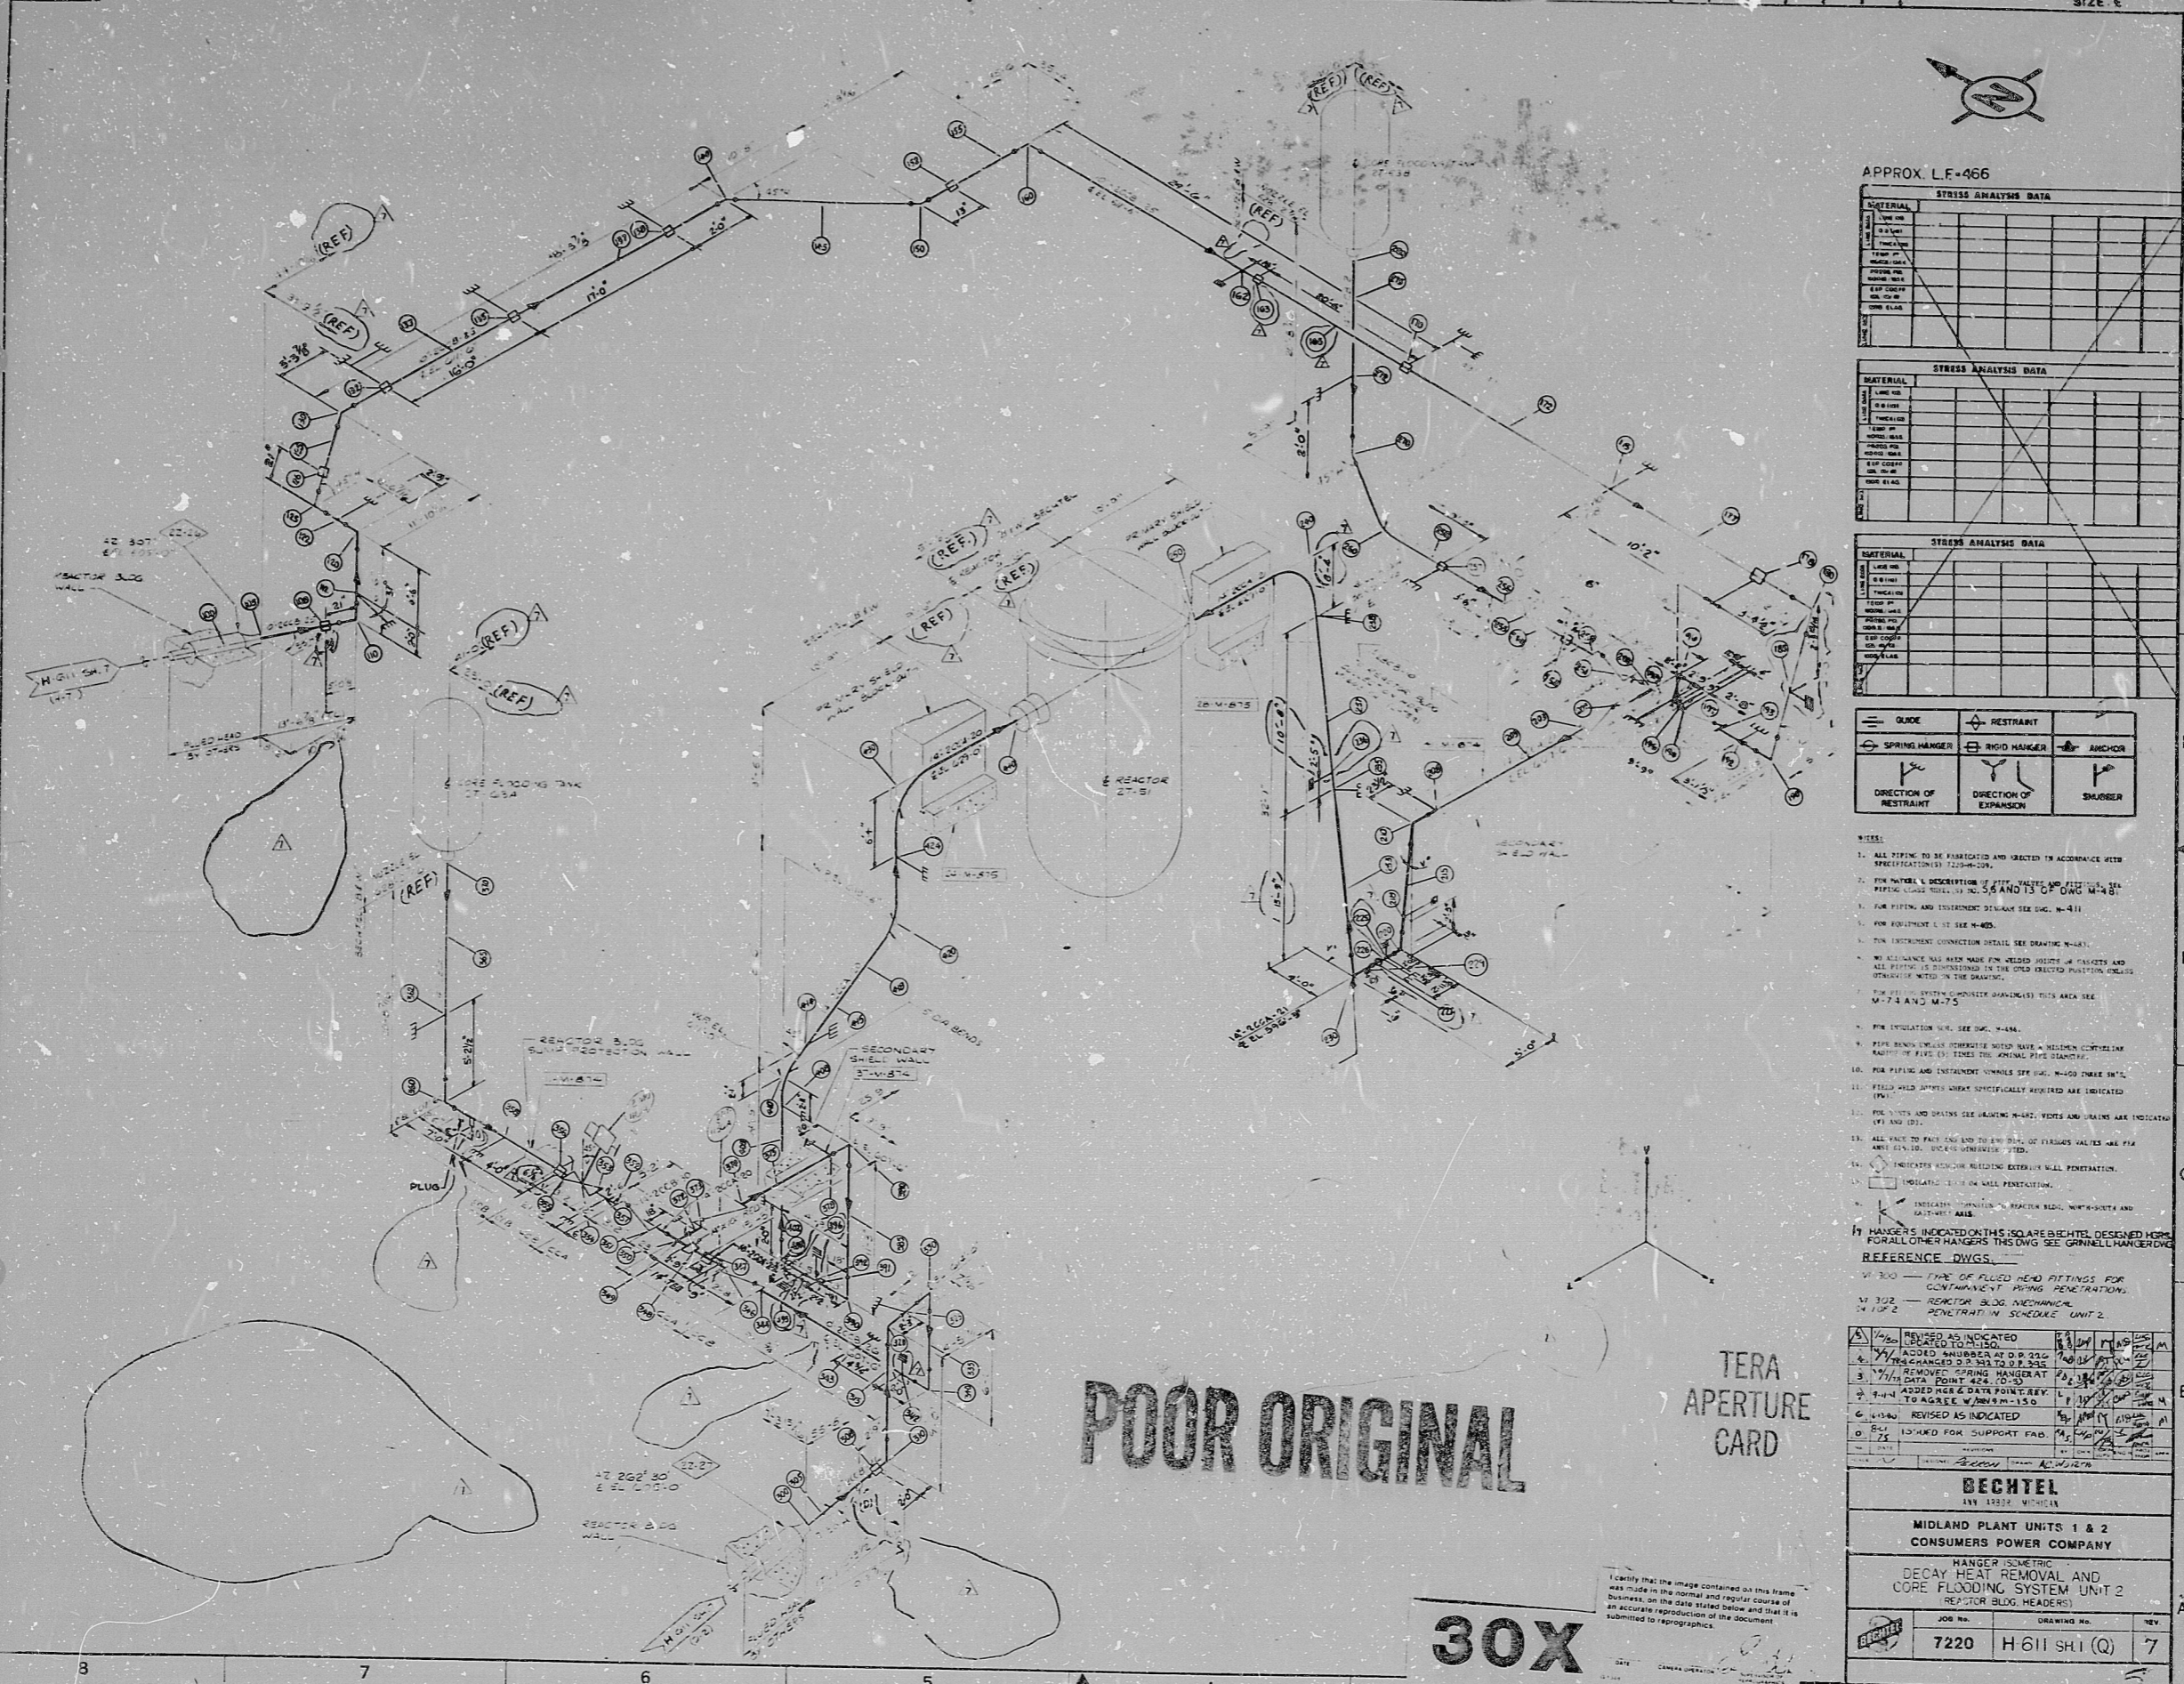

APPROX. LF-466

MATERIAL		STRESS ANALYSIS DATA	
MATERIAL		STRESS ANALYSIS DATA	
MATERIAL		STRESS ANALYSIS DATA	
RIDS

8/12220256

