



H612 SH 3

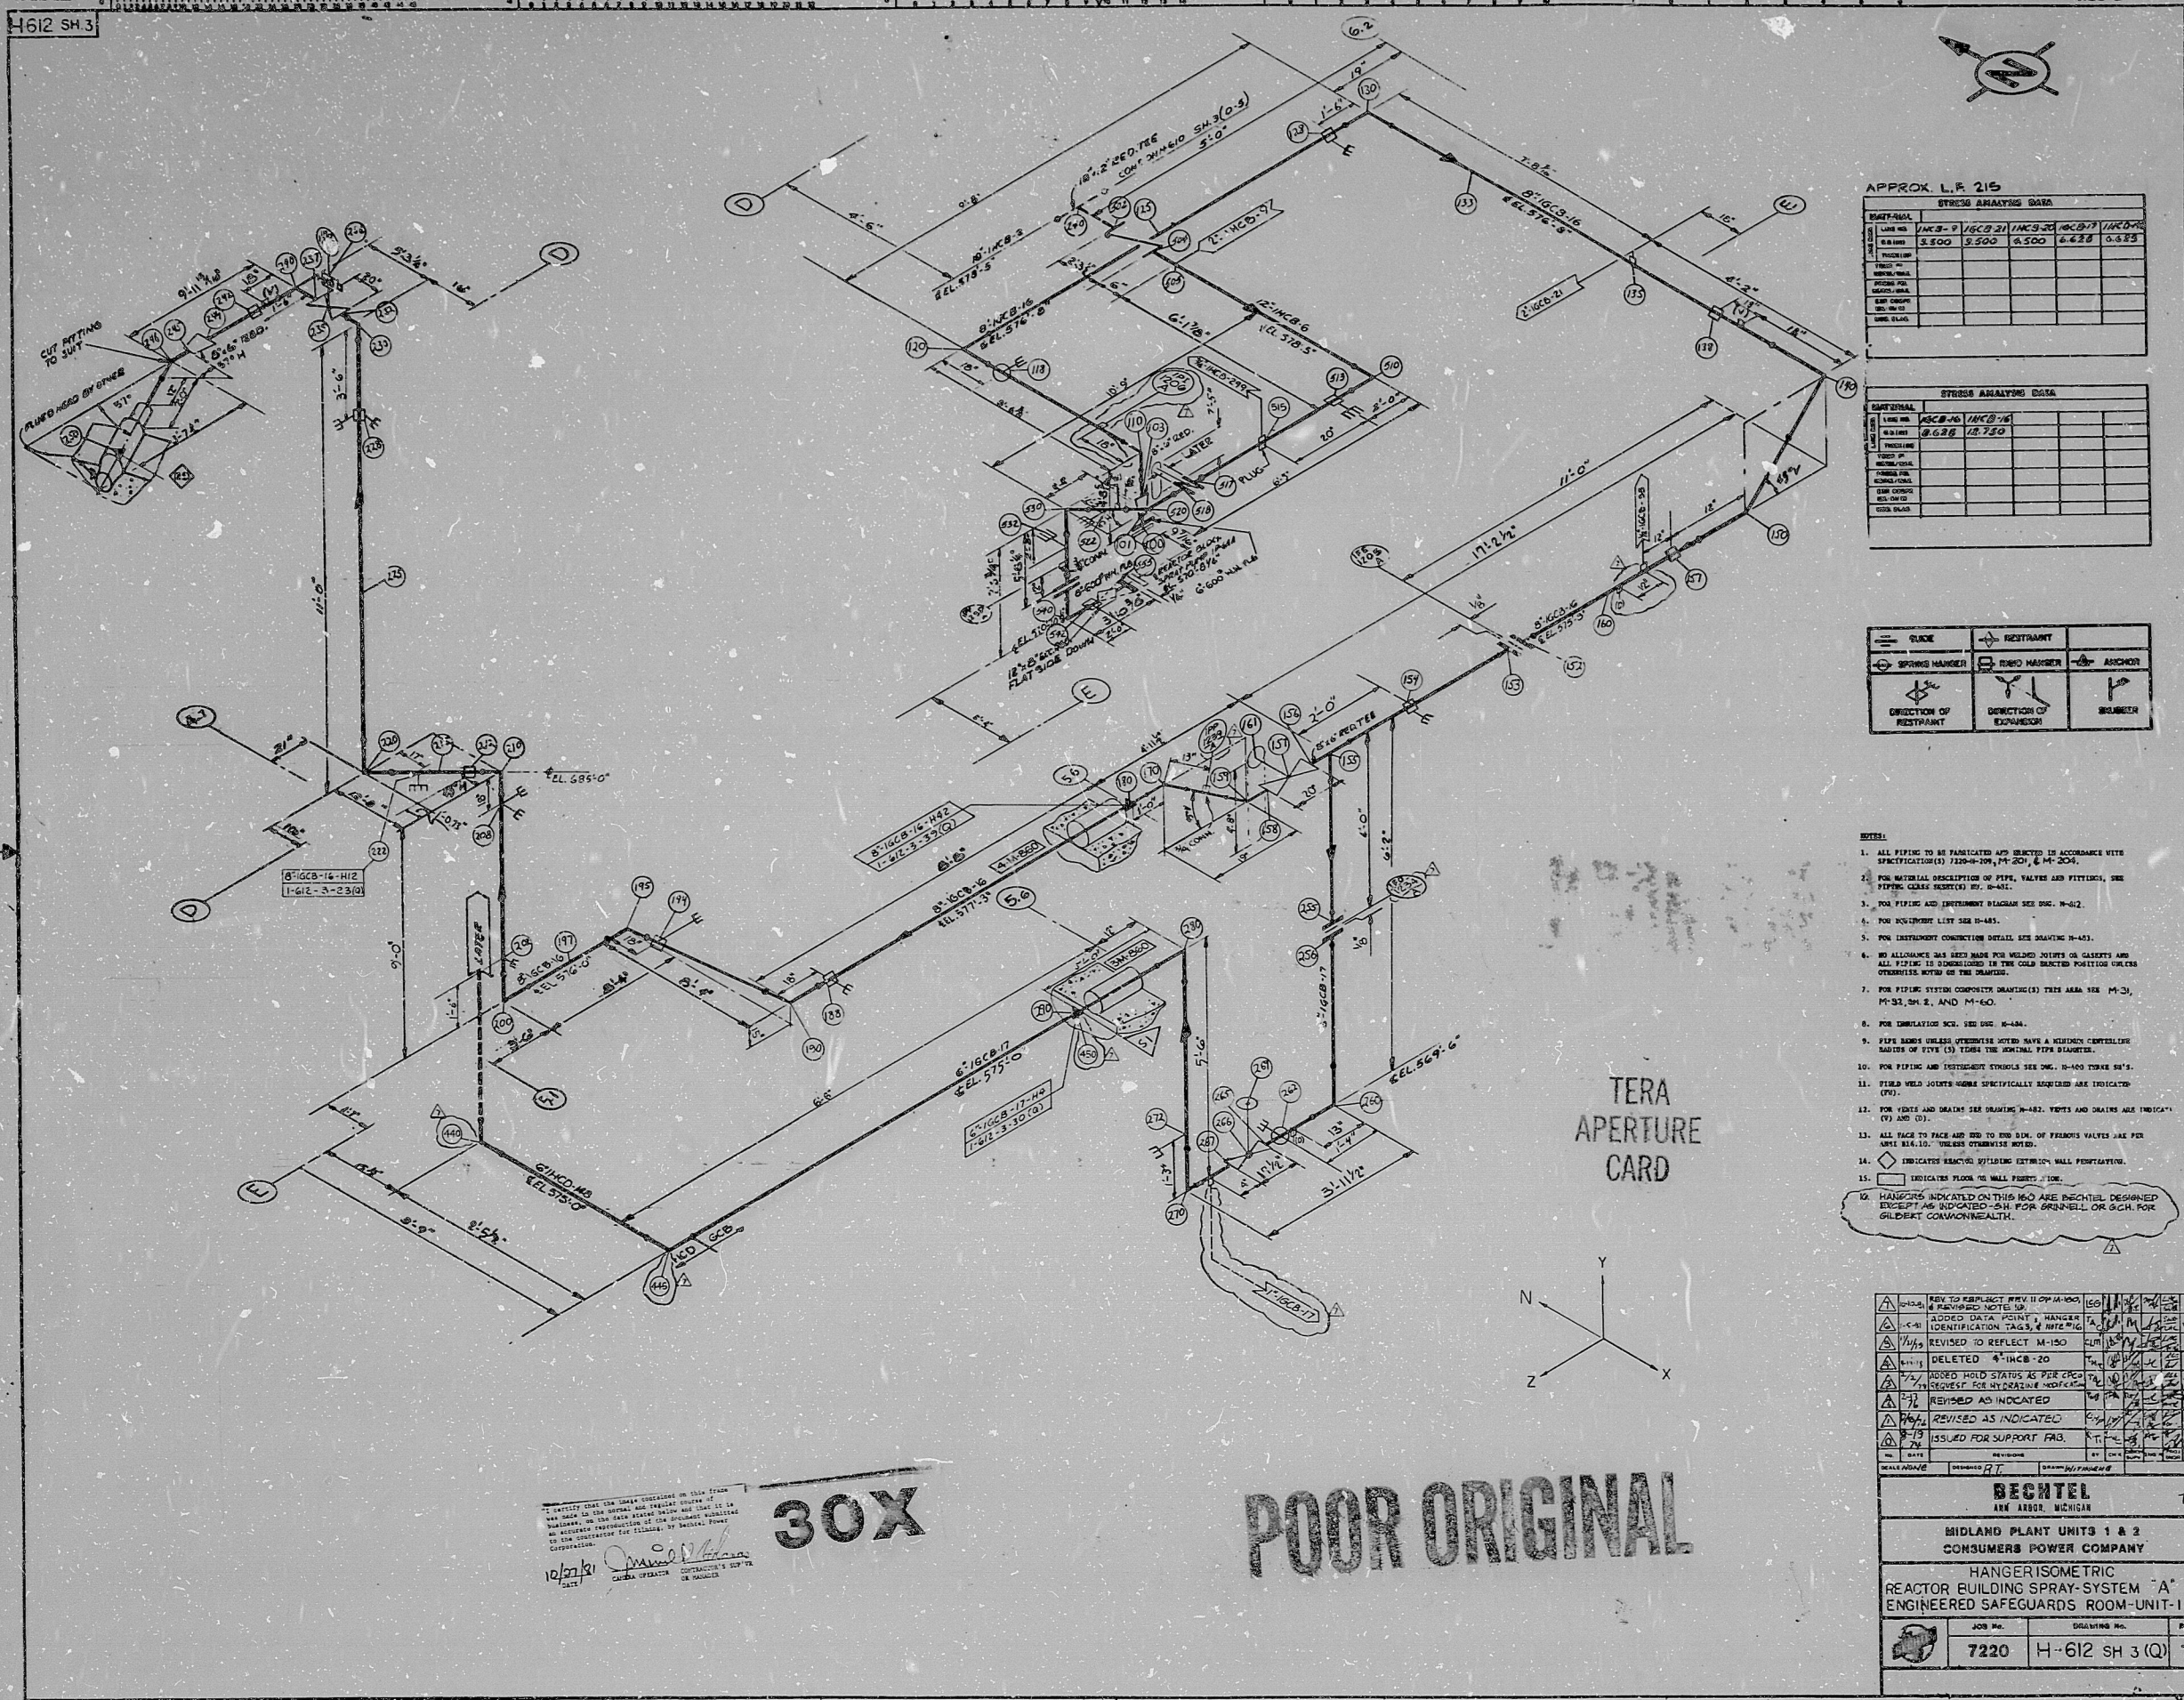

APPROX. L.F. 215

STRESS ANALYSIS DATA					


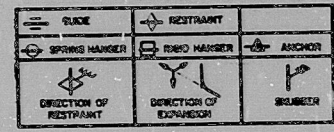

- NOTES:
1. ALL PIPING TO BE FABRICATED AND INSTALLED IN ACCORDANCE WITH SPECIFICATIONS (S) 7100-109, M-201, & M-204.
 2. FOR MATERIAL DESCRIPTION OF PIPE, VALVES AND FITTINGS, SEE TYPE CODE SCHEDULES (S) 7100-109.
 3. FOR FITTING AND INSTRUMENT DIAGRAMS SEE ENG. W-612.
 4. FOR INSTRUMENT LIST SEE W-485.
 5. FOR INSTRUMENT CONNECTIONS SEE ENG. W-485.
 6. NO ALLOWANCE HAS BEEN MADE FOR WELDED JOINTS OR GASKETS AND ALL PIPING IS DIMENSIONED TO THE CENTER LINE UNLESS OTHERWISE NOTED.
 7. FOR PIPE SYSTEM COMPONENTS (SCHEDULES) TYPE AREA SEE M-31, M-31.2, AND M-60.
 8. FOR DIMENSIONS SEE ENG. W-484.
 9. PIPE HANGERS UNLESS OTHERWISE NOTED HAVE A MINIMUM CARRIER SPACING OF FIVE (5) FEET FROM THE TERMINAL PIPE DIAMETER.
 10. FOR PIPING AND INSTRUMENT SYMBOLS SEE ENG. W-485 TUBE SHEET.
 11. FIELD WELD JOINTS UNLESS SPECIFICALLY NOTED ARE INDICATED (W).
 12. FOR VENTS AND DRAINS SEE DRAWING W-482. VENTS AND DRAINS ARE INDICATED (V) AND (D).
 13. ALL FACE TO FACE AND END TO END DIM. OF VALVES AND FITTINGS ARE PER ANSI B16.10. THESE DIMENSIONS APPLY.
 15. INDICATED FLOOR TO WALL HEIGHTS (F).
 16. HANGERS INDICATED ON THIS DRAWING ARE BEING DESIGNED EXCEPT AS INDICATED - SH FOR SH-ROCKWELL OR SGH FOR GLEBEK COMMONWEALTH.

NO.	DESCRIPTION	DATE	BY	CHKD.

BECHTEL
ANN ARBOR, MICHIGAN

BIDLAND PLANT UNITS 1 & 2
CONSUMERS POWER COMPANY

HANGER ISOMETRIC
REACTOR BUILDING SPRAY-SYSTEM "A"
ENGINEERED SAFEGUARDS ROOM-UNIT-1

JOB NO.	DRAWING NO.	REV.
7220	H-612 SH 3 (Q)	7

30X

POOR ORIGINAL

8.5"
11"
17"

8.5"
11"
17"

RIPS

8112220273

