


H-616 SH.3 (G)

POOR ORIGINAL

APPROX. L.F. 405'

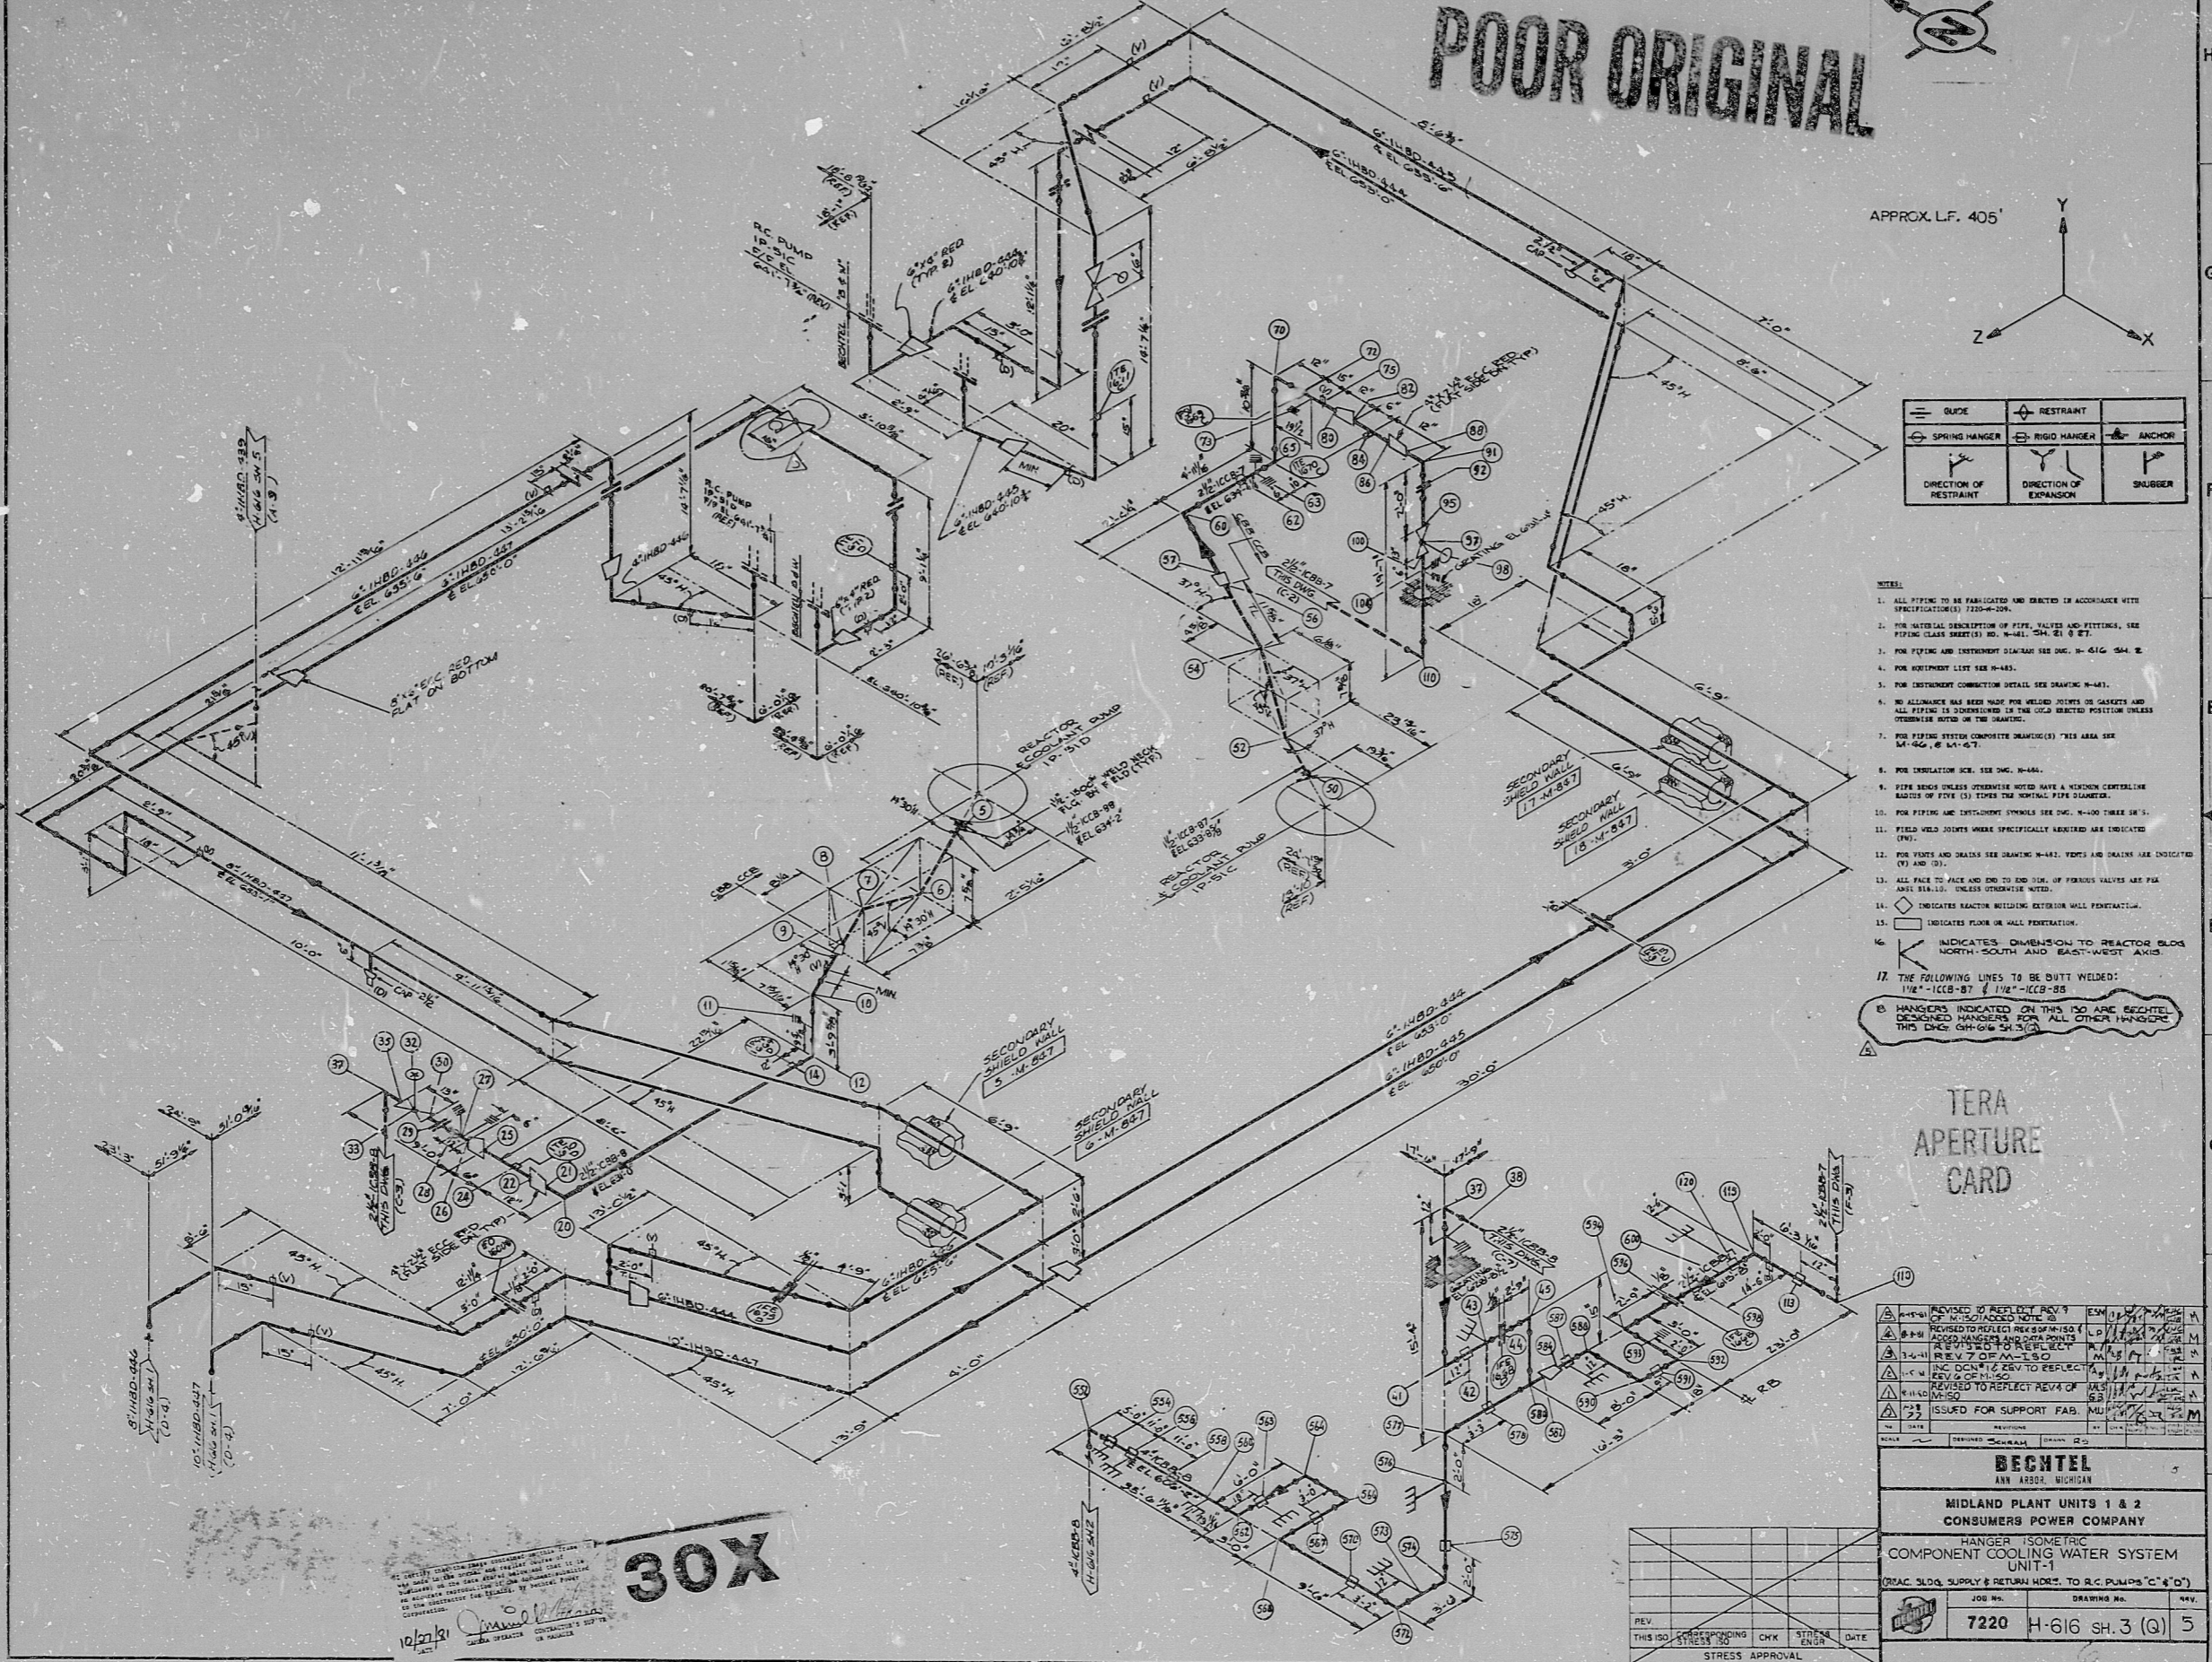


- NOTES:
1. ALL PIPING TO BE FABRICATED AND ERRECTED IN ACCORDANCE WITH SPECIFICATIONS 7200-200.
  2. FOR MATERIAL DESCRIPTION OF PIPE, VALVES AND FITTINGS, SEE PIPING CLASS SHEET(S) NO. W-441, 304, 21 & 27.
  4. FOR EQUIPMENT LIST SEE H-485.
  5. FOR INSTRUMENT CONNECTION DETAIL SEE DRAWING H-481.
  6. NO ALLOWANCE HAS BEEN MADE FOR WELDED JOINTS OR SAFETY AND ALL PIPING IS DIMENSIONED IN THE LOCAL DIRECTED POSITION UNLESS OTHERWISE NOTED ON THE DRAWING.
  9. PIPE BRACKS UNLESS OTHERWISE NOTED HAVE A VERTICAL CENTERLINE MATCHES OF PIPE (S) TYPE OR PORTAL PIPE DIMENSIONS.
  10. FOR PIPING AND INSTRUMENT SYMBOLS SEE DWG. H-400 THREE SETS.
  11. FIELD WELD JOINTS UNLESS SPECIFICALLY INDICATED ARE INDICATED (W).
  12. FOR WELDS AND GRADES SEE DRAWING H-481. WELDS AND GRADES ARE INDICATED (W) AND (G).
  13. ALL FACE TO FACE AND END TO END JOINTS, IF PERMISSIBLE, ARE FACE AND BEVEL UNLESS OTHERWISE NOTED.
  14. INDICATES REACTOR BUILDING EXTERIOR WALL PENETRATION.
  15. INDICATES FLUORINE WALL PENETRATION.
  16. INDICATES DIMENSION TO REACTOR BLOC NORTH-SOUTH AND EAST-WEST AXES.
  17. THE FOLLOWING LINES TO BE BUTT WELDED: 1/2" - KCB-87 & 1/2" - KCB-85
- B. HANGERS INDICATED ON THIS DWG ARE BECTEL DESIGNED HANGERS FOR ALL OTHER HANGERS THIS DWG. 08/16/84 3/1/84

TERA APERTURE CARD


**BECTEL**  
ANN ARBOR, MICHIGAN

**MIDLAND PLANT UNITS 1 & 2**  
**CONSUMERS POWER COMPANY**

HANGER ISOMETRIC  
COMPONENT COOLING WATER SYSTEM  
UNIT-1

(ORAC, SLO, SUPPLY & RETURN MORE TO R.C. PUMPS "C" & "D")

JOB NO. **7220** DRAWING NO. **H-616 SH.3 (G)** REV. **5**

DESIGNED BY: \_\_\_\_\_ CHECKED BY: \_\_\_\_\_ DATE: \_\_\_\_\_

STRESS APPROVAL: \_\_\_\_\_

30X


8.5" 11" 17"

8.5" 11" 17"

RIDS

8112220297

