

66 11

66 11

66 59

8.5"

11"

17 99

66 11

66 11

66 58


8.5"

11"

17 99

APRM CHANNEL G
 ANALOG SECTION

ALL W660 IS (D3) UNLESS OTHERWISE INDICATED ON THIS SHEET

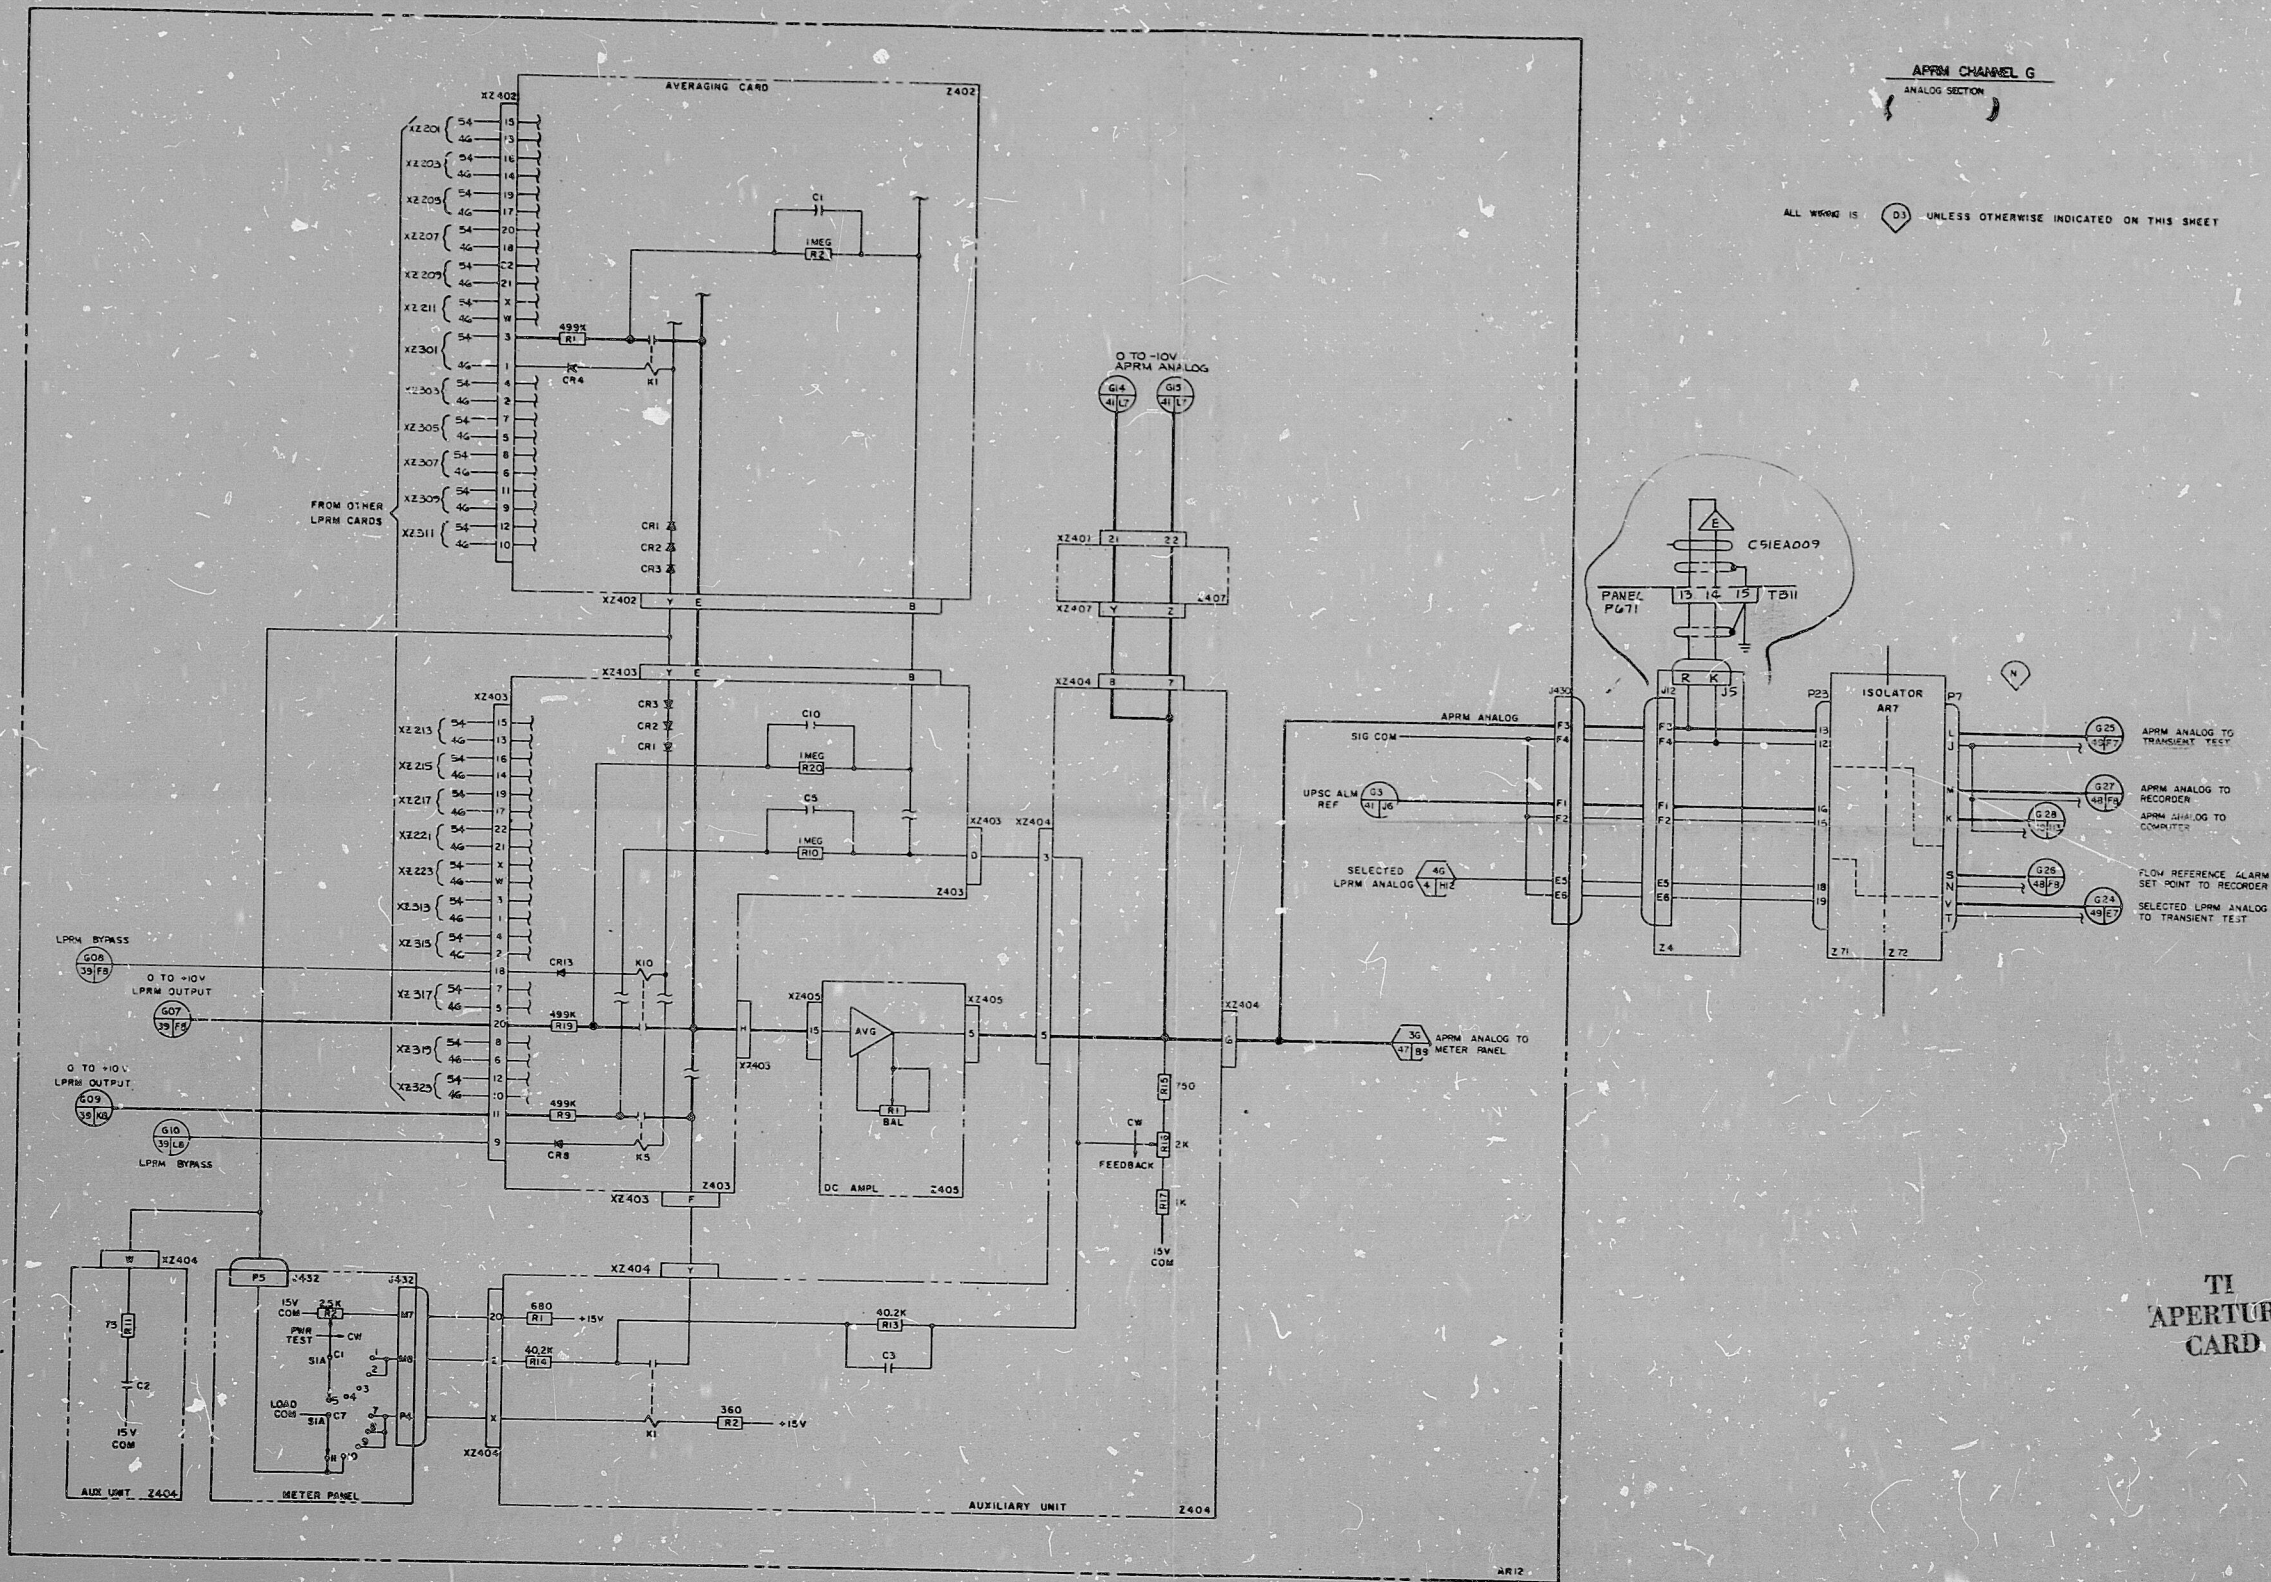

TI APERTURE CARD

LINE CODES NONE THIS SHEET

NO.	REV.	DATE	BY	CHKD.	DESCRIPTION
1					ISSUED FOR CONSTRUCTION
2					REVISION
3					REVISION
8412190062

PDR RIDS

