
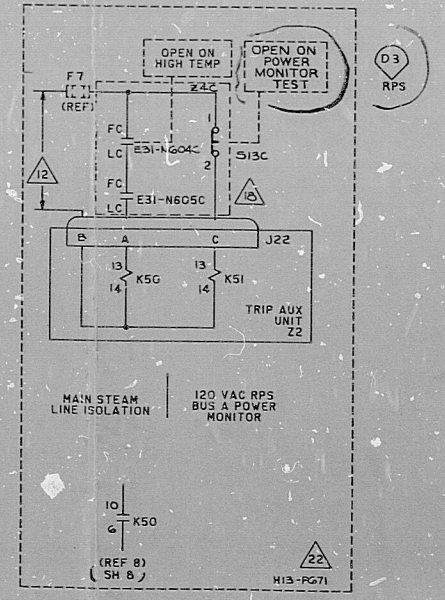


GENERAL ELECTRIC 85IE602AA  
 LEAK DETECTION SYSTEM  
 FIRST MADE FOR

UNLESS OTHERWISE INDICATED

RWCU ISOLATION    RHR R/C ISOLATION    MAIN STEAM LINE ISOLATION    120 VAC BUS A POWER MONITOR    RCIC ISOLATION    POWER DISCONNECT ON LOCA    INHIBIT RWCU ISOLATION ON POWER MONITOR TEST    RCIC MAIN STEAM TUNNEL ISOLATION DELAY

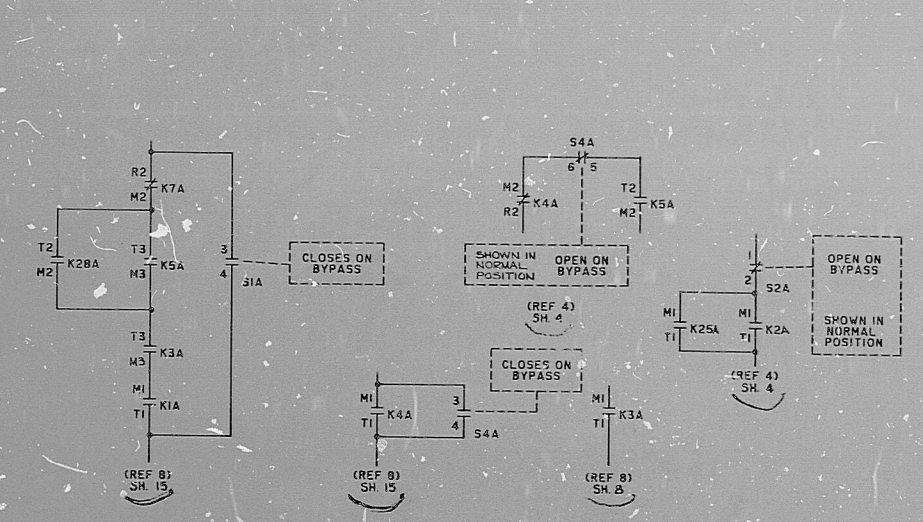

CABLE NO. 1E31A 0035    LINE CODE 50

TI APERTURE CARD

LINE CODES: 50, 22, 232

NO.	REV.	DATE	BY	CHKD.	DESCRIPTION
5	NJ25568	12-22-72	D. JOHNSON	E.L.E.	REVISION
2	NJ00000				DESIGNED BY
3	NJ16848				CHECKED BY
4	NJ24136				APPROVED BY

85IE602AA  
 SAN JOSE  
 4A

8412190091

PDR RIDS

