

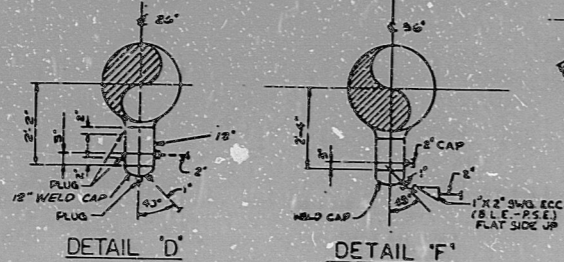


H-632 SH2 (G)

POOR ORIGINAL

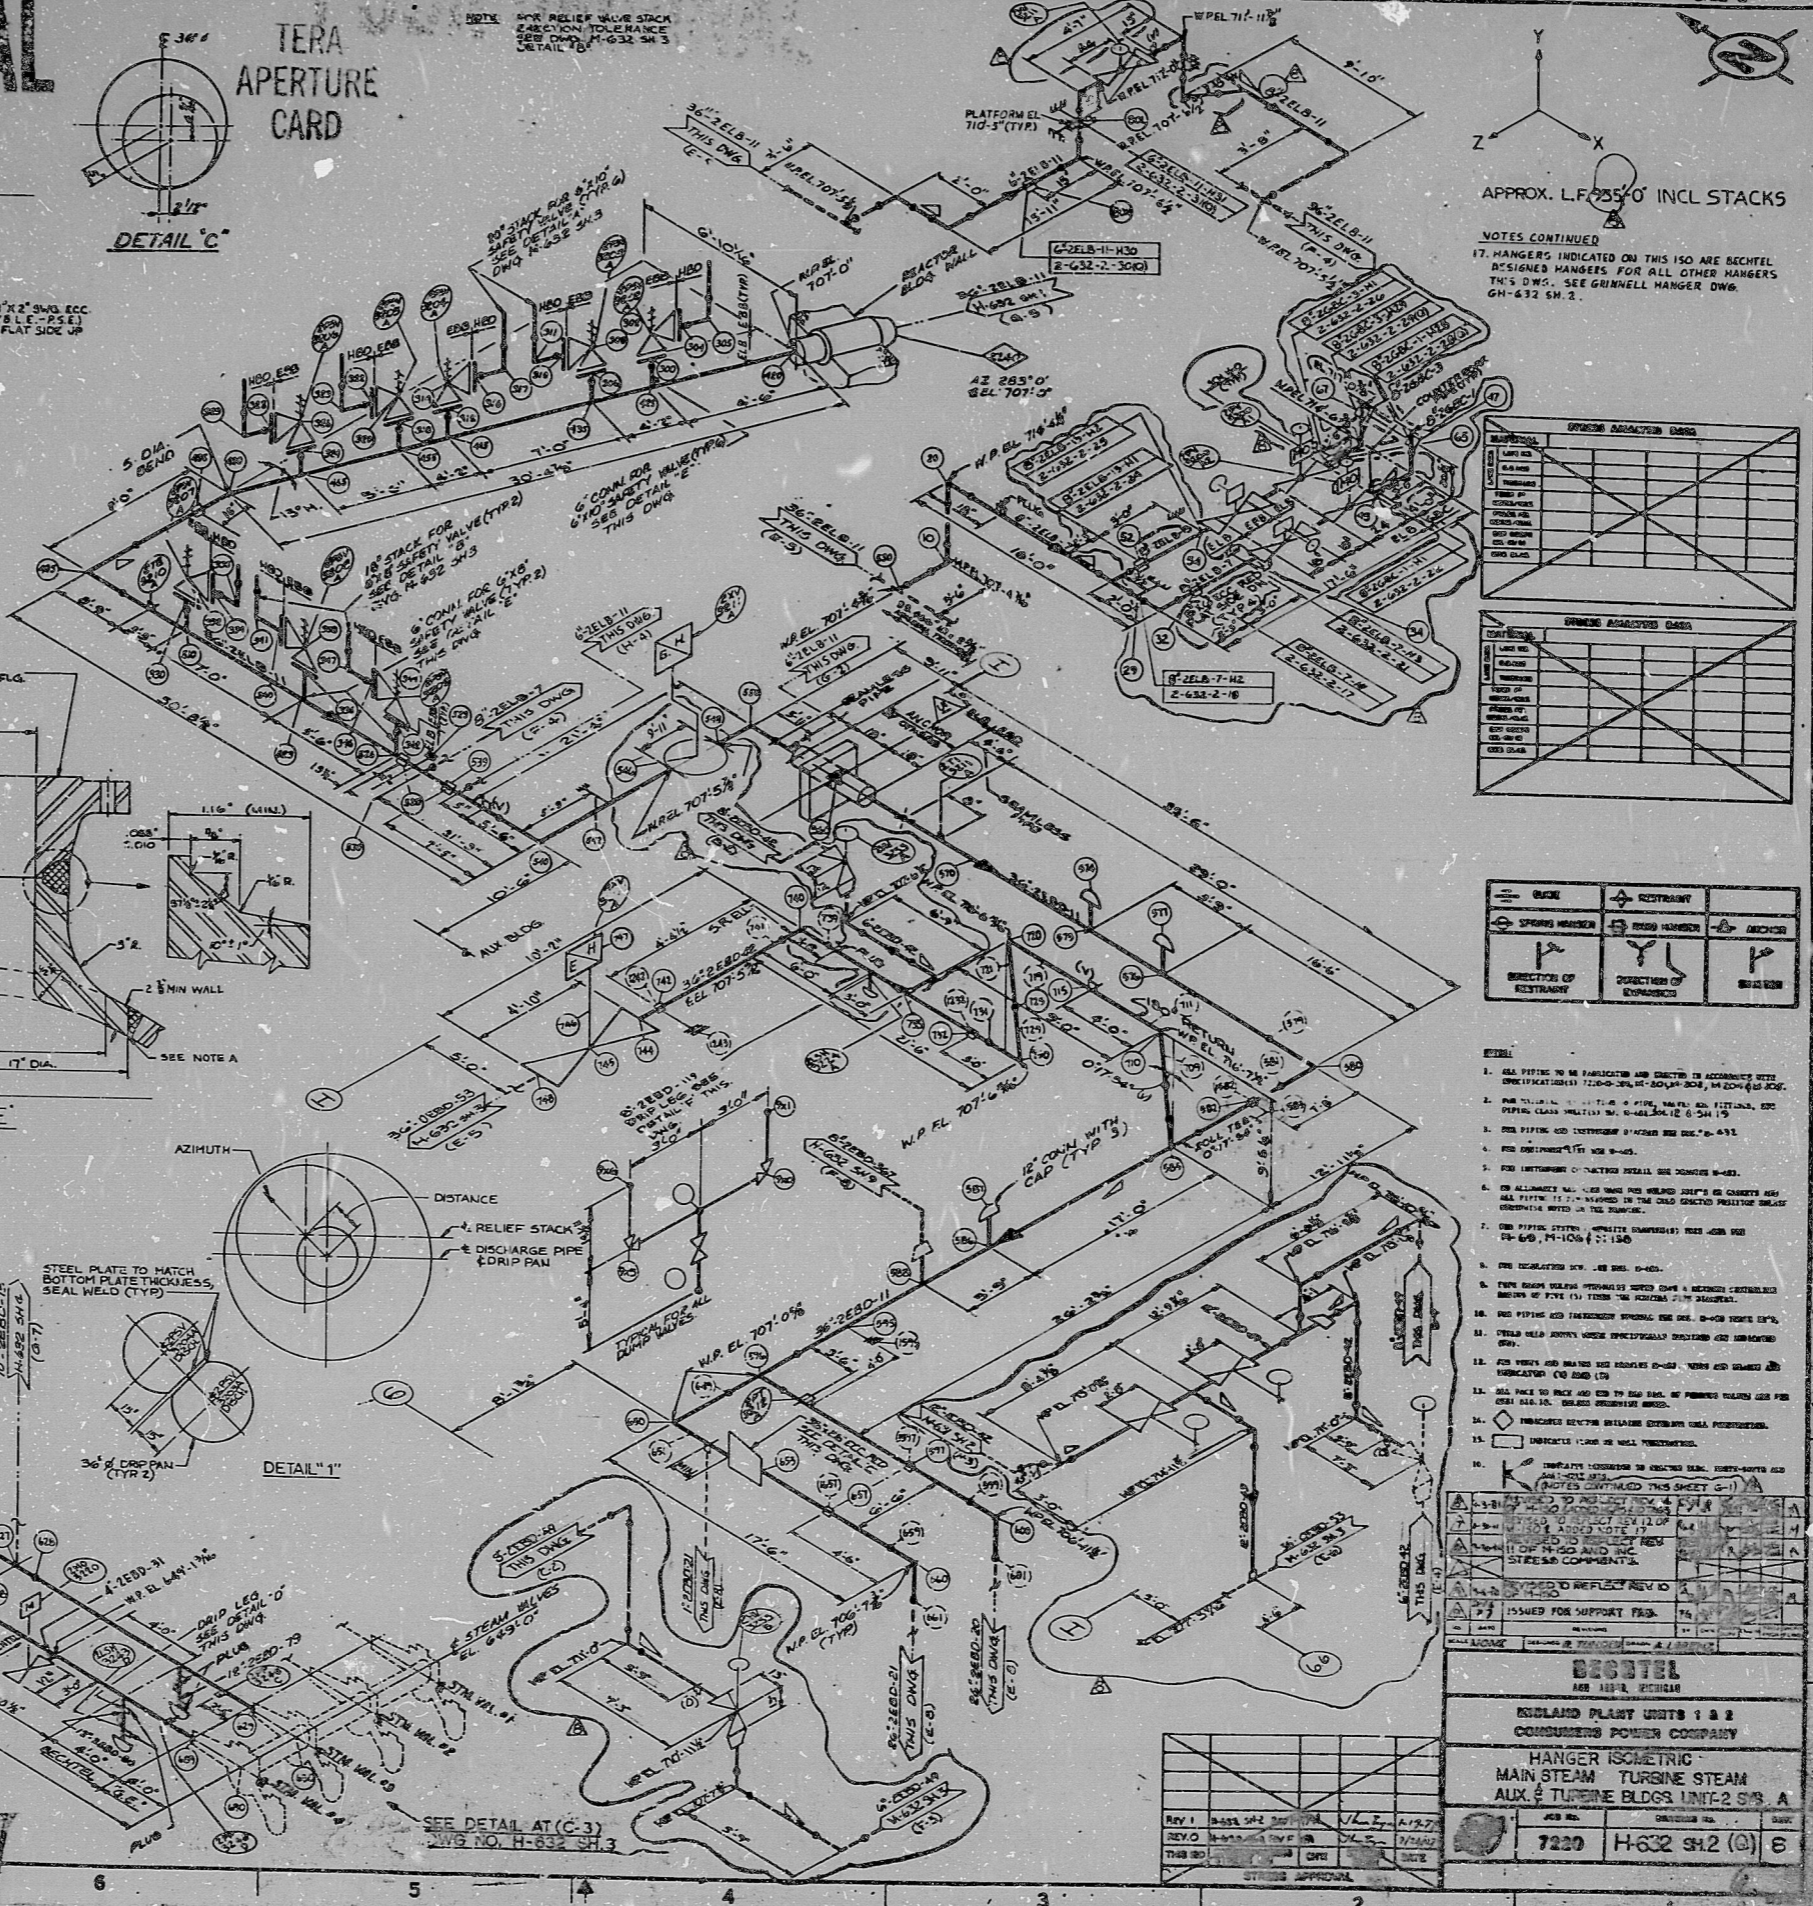


TERA APERTURE CARD

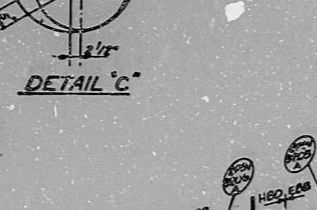




SECTION A-A

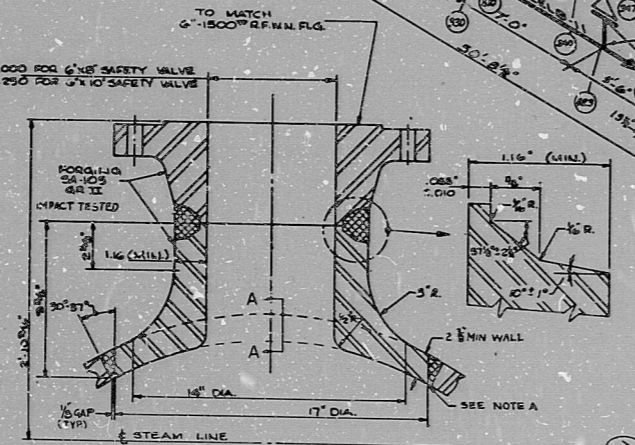

DETAIL 'E'

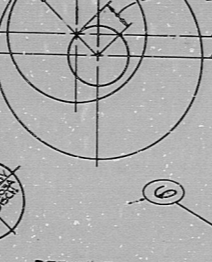

DETAIL 'I'

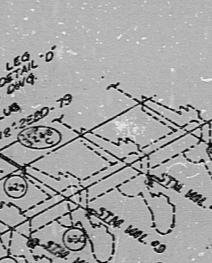






* SEE DRIP PAN DETAIL 'H' THIS DWG. (C-2)

30X

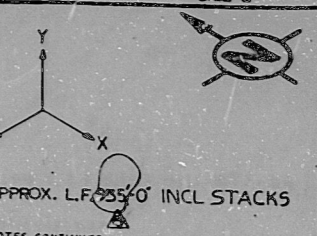

NOTES CONTINUED
17. HANGERS INDICATED ON THIS ISOMETRIC ARE BEchtel DESIGNED HANGERS FOR ALL OTHER HANGERS. T.Y. S.D.S. SEE GRINNELL HANGER DWG. C-4-632 SH. 2.




HANGER ISOMETRIC MAIN STEAM TURBINE STEAM AUX & TURBINE BLDGS. UNITS 2 S/S A	
7220	H-632 SH2 (G) B

RIPS

8112220359

