
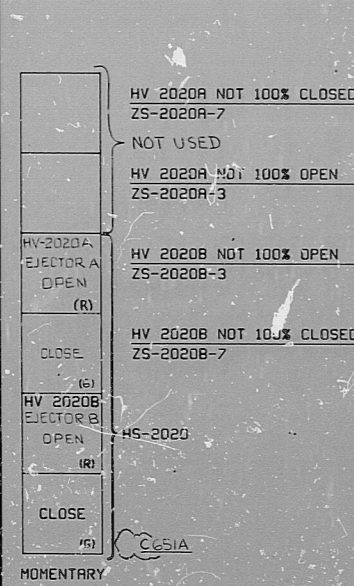


J-07-0 SHT. 4

LOGIC CABINET DC653

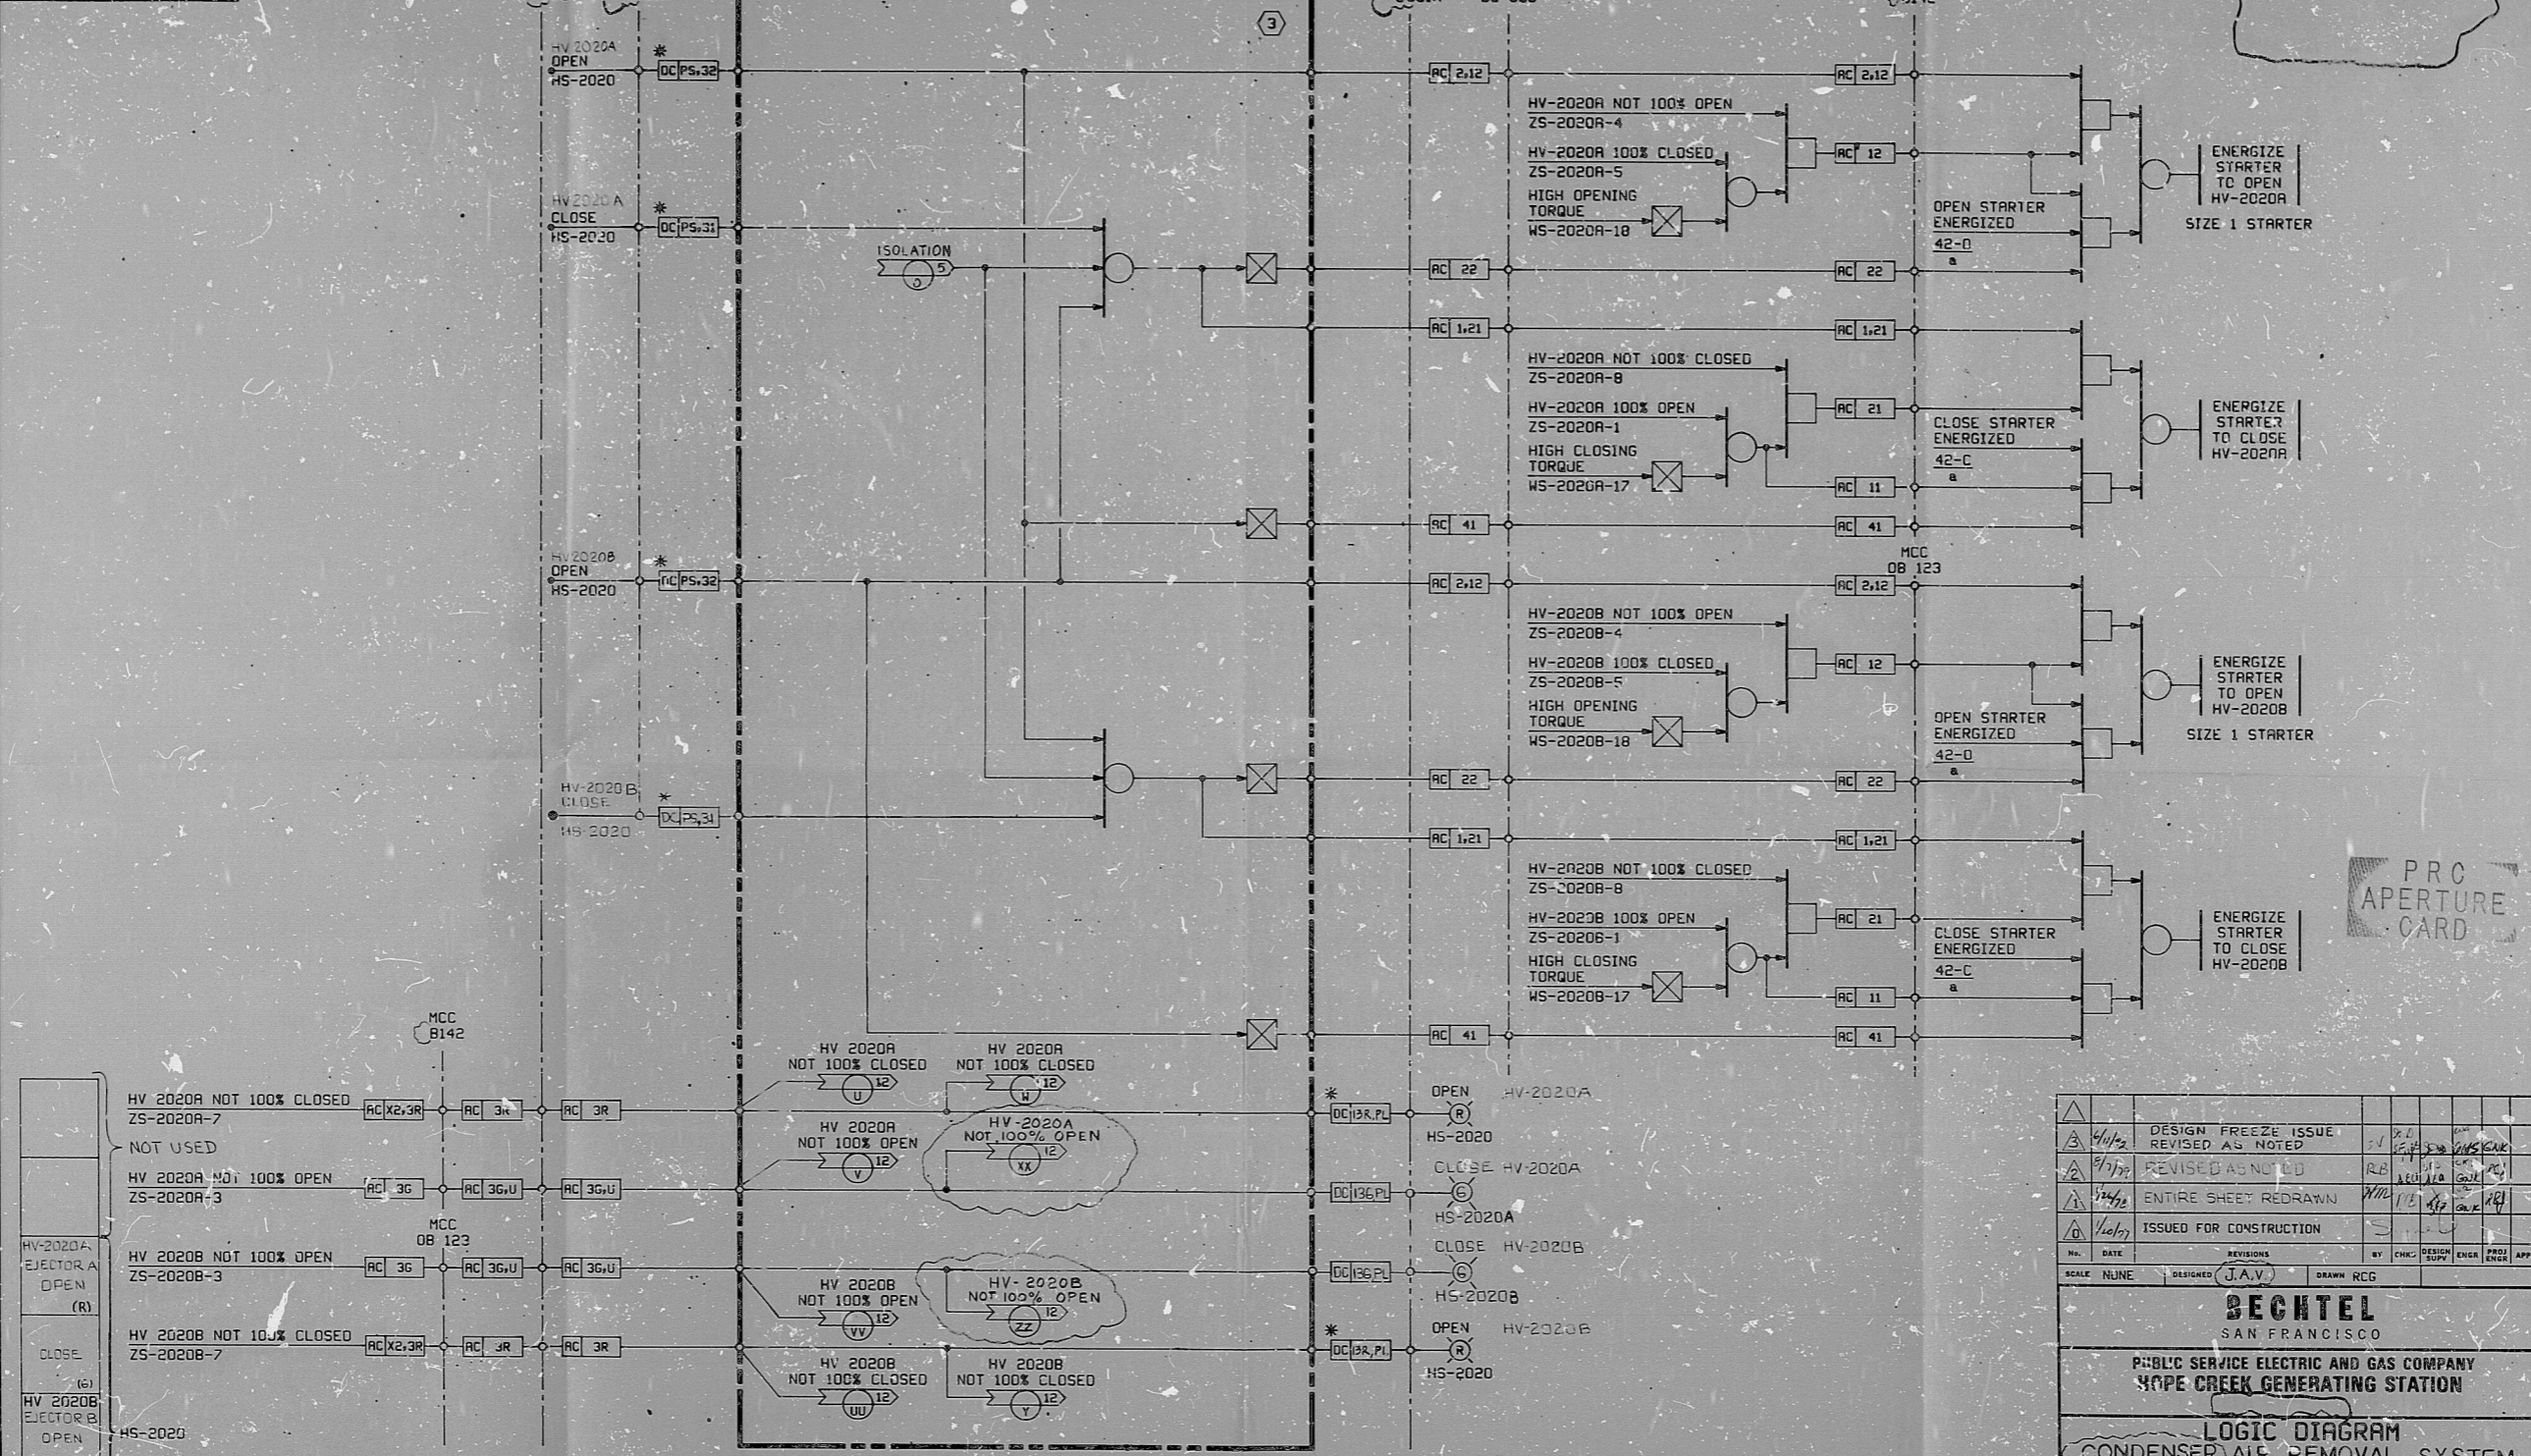

AUXILIARY STEAM DISTRIBUTION VALVES HV-2020A & B

No.	DATE	REVISIONS	BY	CHK.	DESIGN	ENGR.	PROJ.	APPR.

BECHTEL
SAN FRANCISCO

PUBLIC SERVICE ELECTRIC AND GAS COMPANY
HOPE CREEK GENERATING STATION

LOGIC DIAGRAM
CONDENSER AIR REMOVAL SYSTEM
AUXILIARY STEAM DISTRIBUTION VALVES

JOB No.	DRAWING No.	REV.
10855	J-07-0 SHT 4	3

This drawing and the design it covers are the property of BECHTEL. They are hereby loaned and on the borrower's express agreement that they will not be reproduced, copied, loaned, exhibited, nor used except in the limited way and private use permitted by any written consent given by the lender to the borrower.

S/U - CG

9777 K04-ANDOR-750 2ND

22 x 34 " D" SIZE

RIDS

8307770567

