


68 11

68 11

68 9.8

68 11

68 11

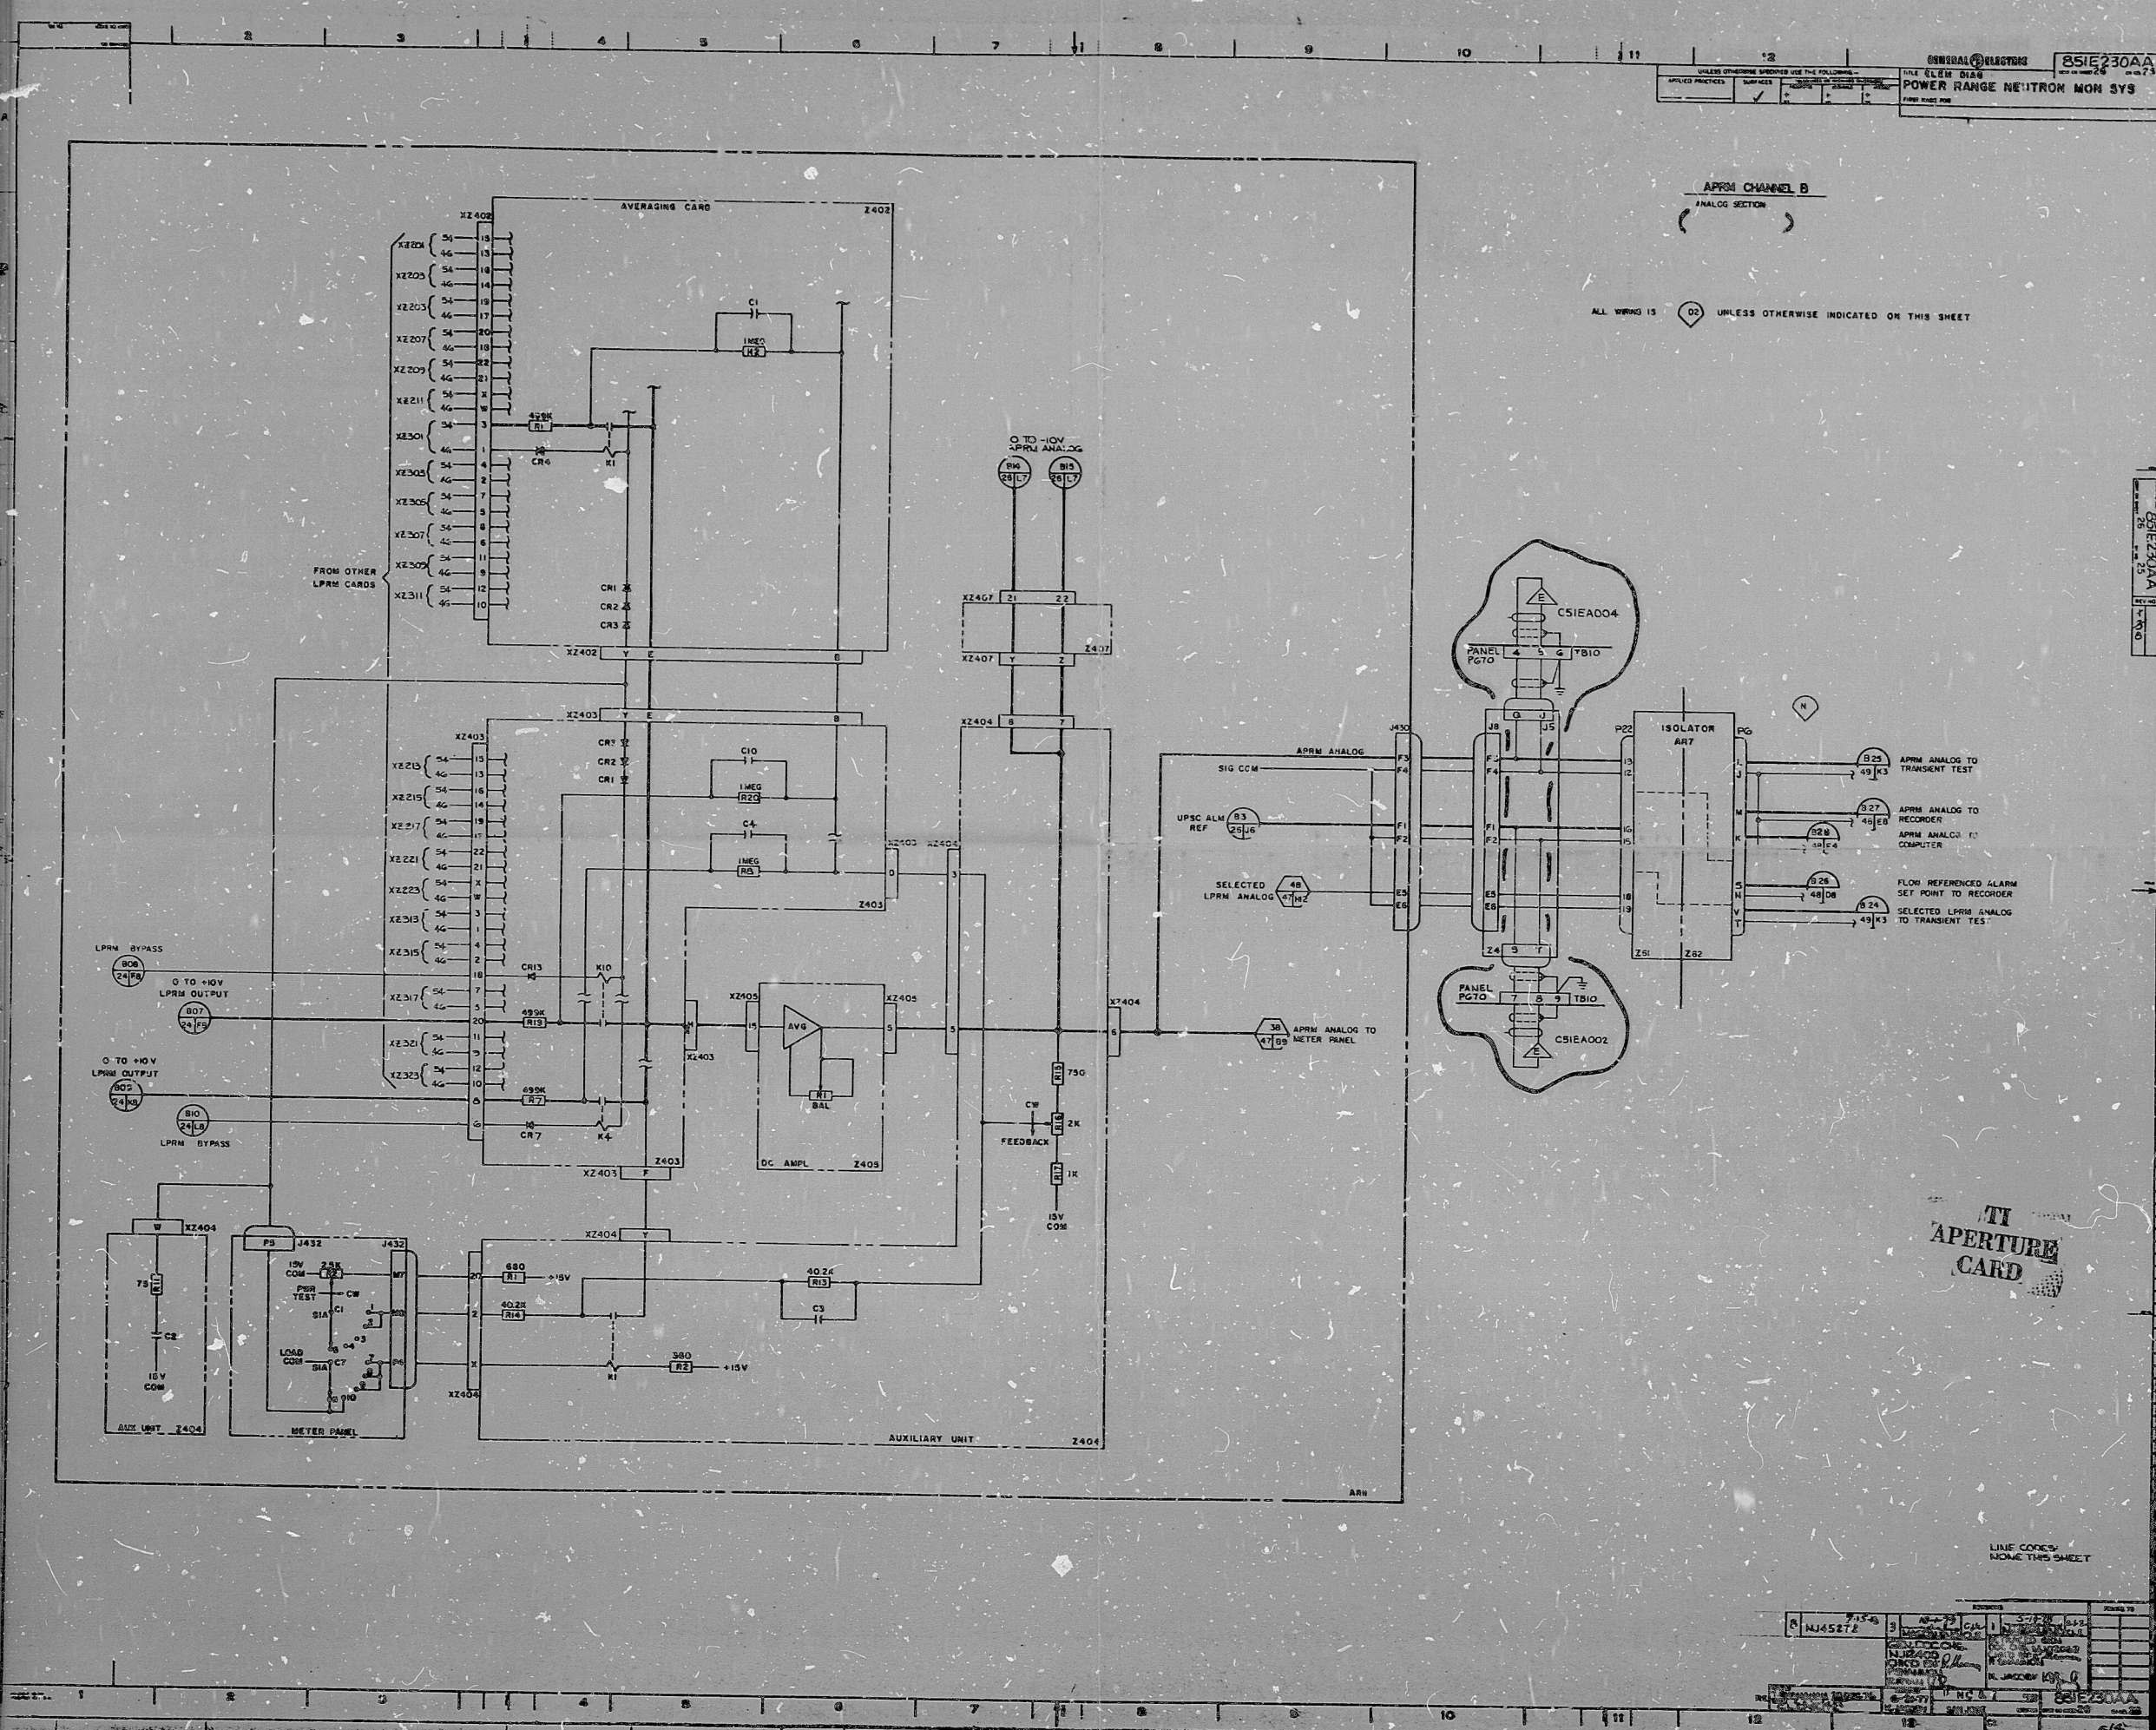

UNLESS OTHERWISE SPECIFIED USE THE FOLLOWING:
 APPLICABLE PRACTICES: []
 SURFACES: []
 DIMENSIONS: []
 FINISHES: []
 GENERAL ELECTRIC 85IE230AA
 FILE: 65EN 2128
 POWER RANGE NEUTRON MON SYS
 FORM 7000-100

APRM CHANNEL B
 ANALOG SECTION

ALL WIRING IS 22 UNLESS OTHERWISE INDICATED ON THIS SHEET

TI
 APERTURE
 CARD

LINE CODES
 NONE THIS SHEET

NO.	REV.	DATE	BY	CHKD.	APP'D.	REVISION
1	1	9-15-68	W. J. JACOB			INITIAL DESIGN

68 11

68 11

68 9.8

68 11

68 11

68 11

8412190119

PDR RIDS

