


UNLESS OTHERWISE SPECIFIED USE THE FOLLOWING:  
UNLESS OTHERWISE SPECIFIED USE THE FOLLOWING:  
FLOW CHANNEL D & H

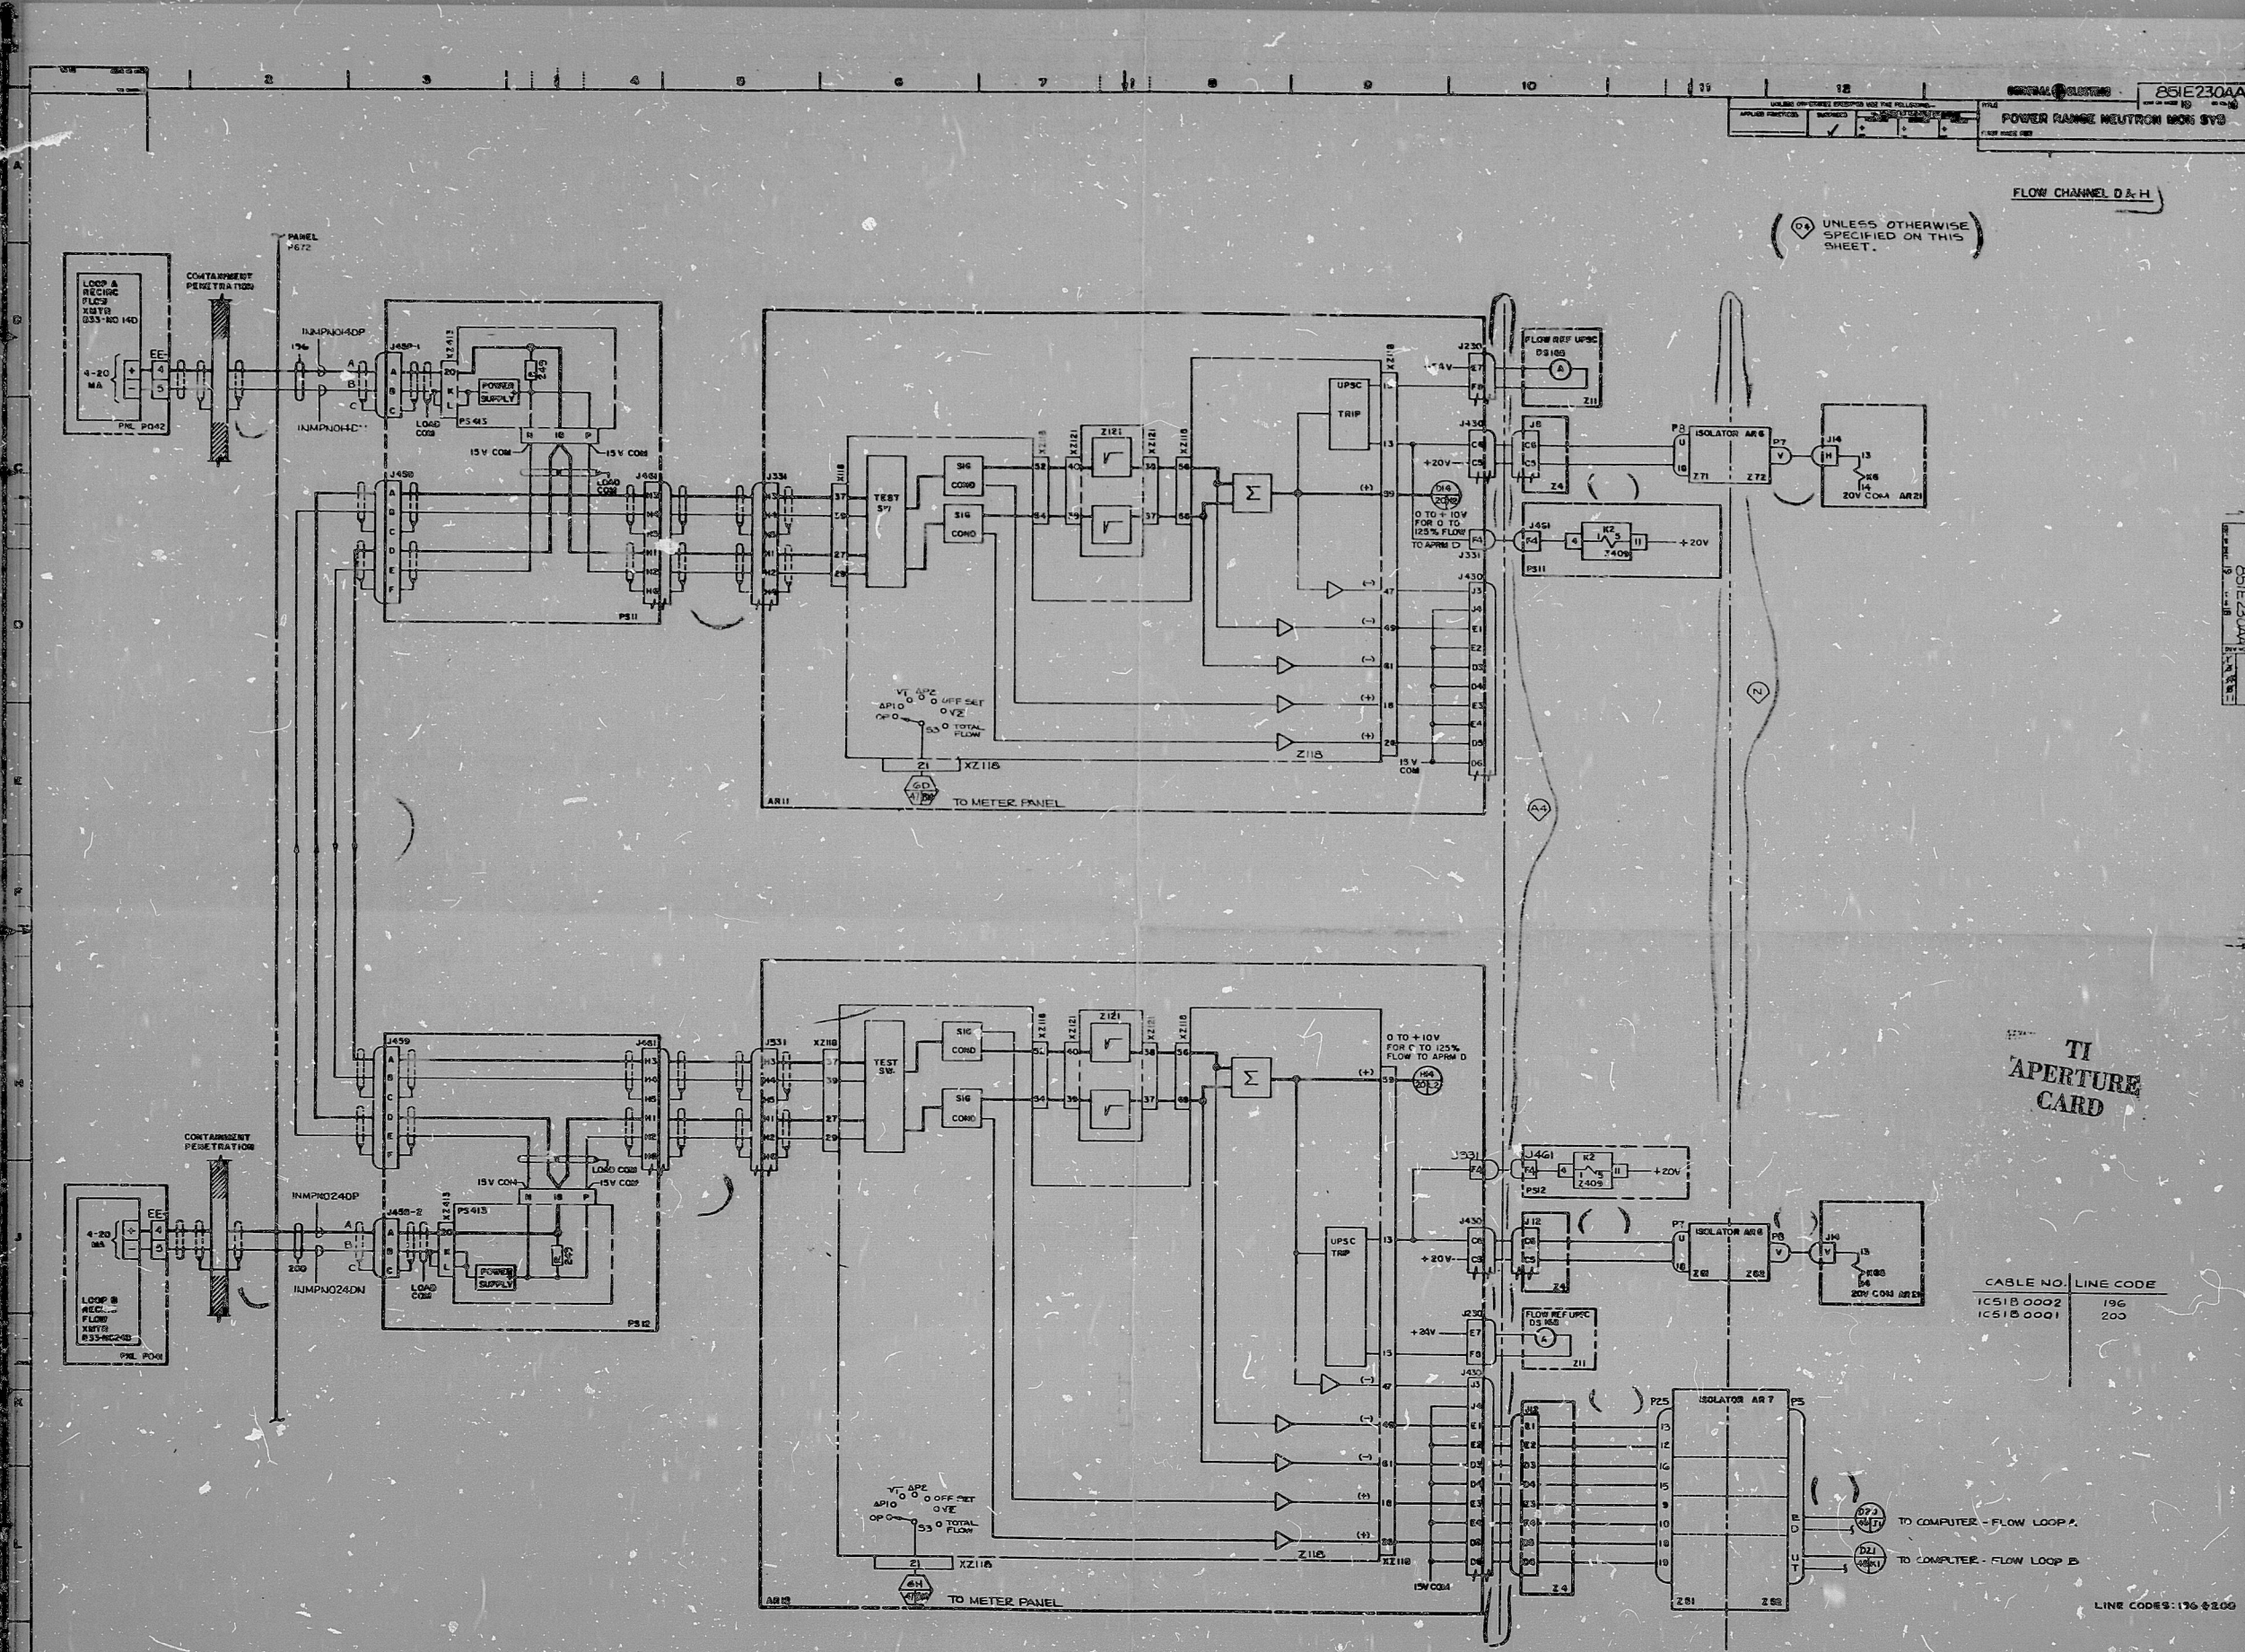

CABLE NO. LINE CODE

1C518 0002	196
1C518 0001	200

LINE CODES: 176-200

REV	NO.	BY	CHKD	DATE
1				
2				
3				
4				

85E230AA  
POWER RANGE NEUTRON MODS SYS  
SAN JOSE



8412190128

PDR RIDS

