


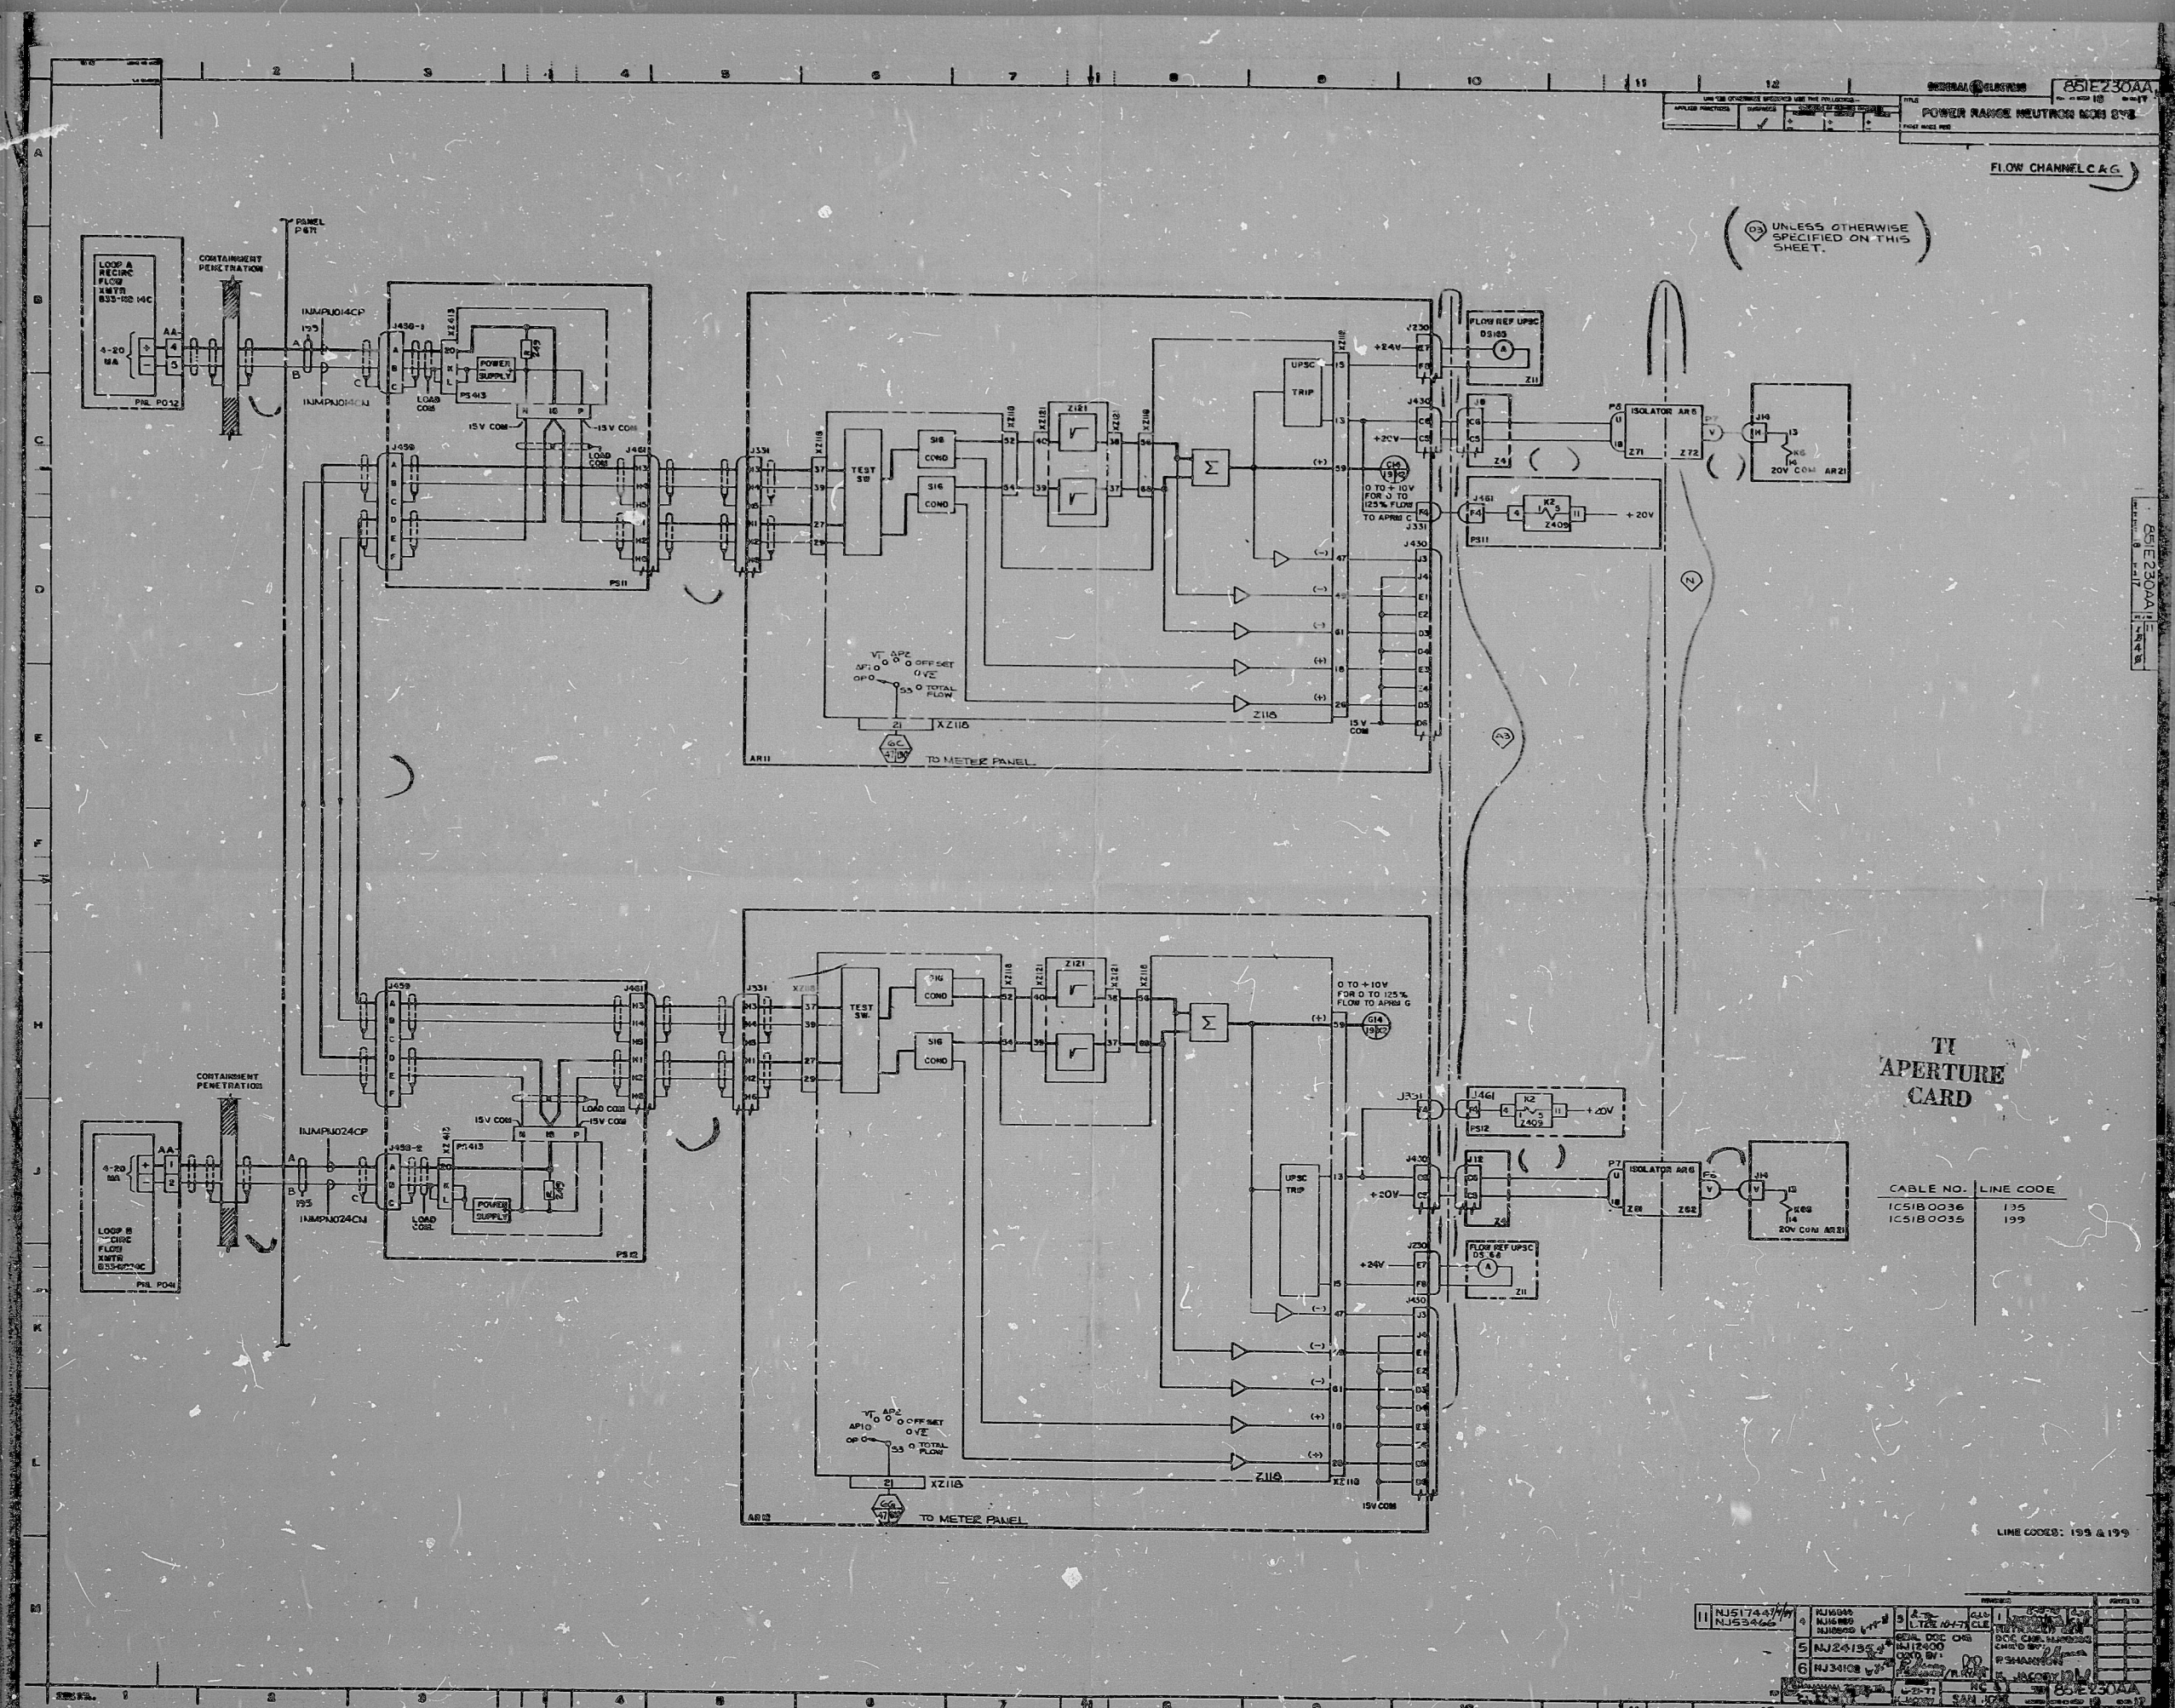


PDR RIDS

8412190131

