


ITEM NUMBERS

B.P. 051.004 SYSTEM

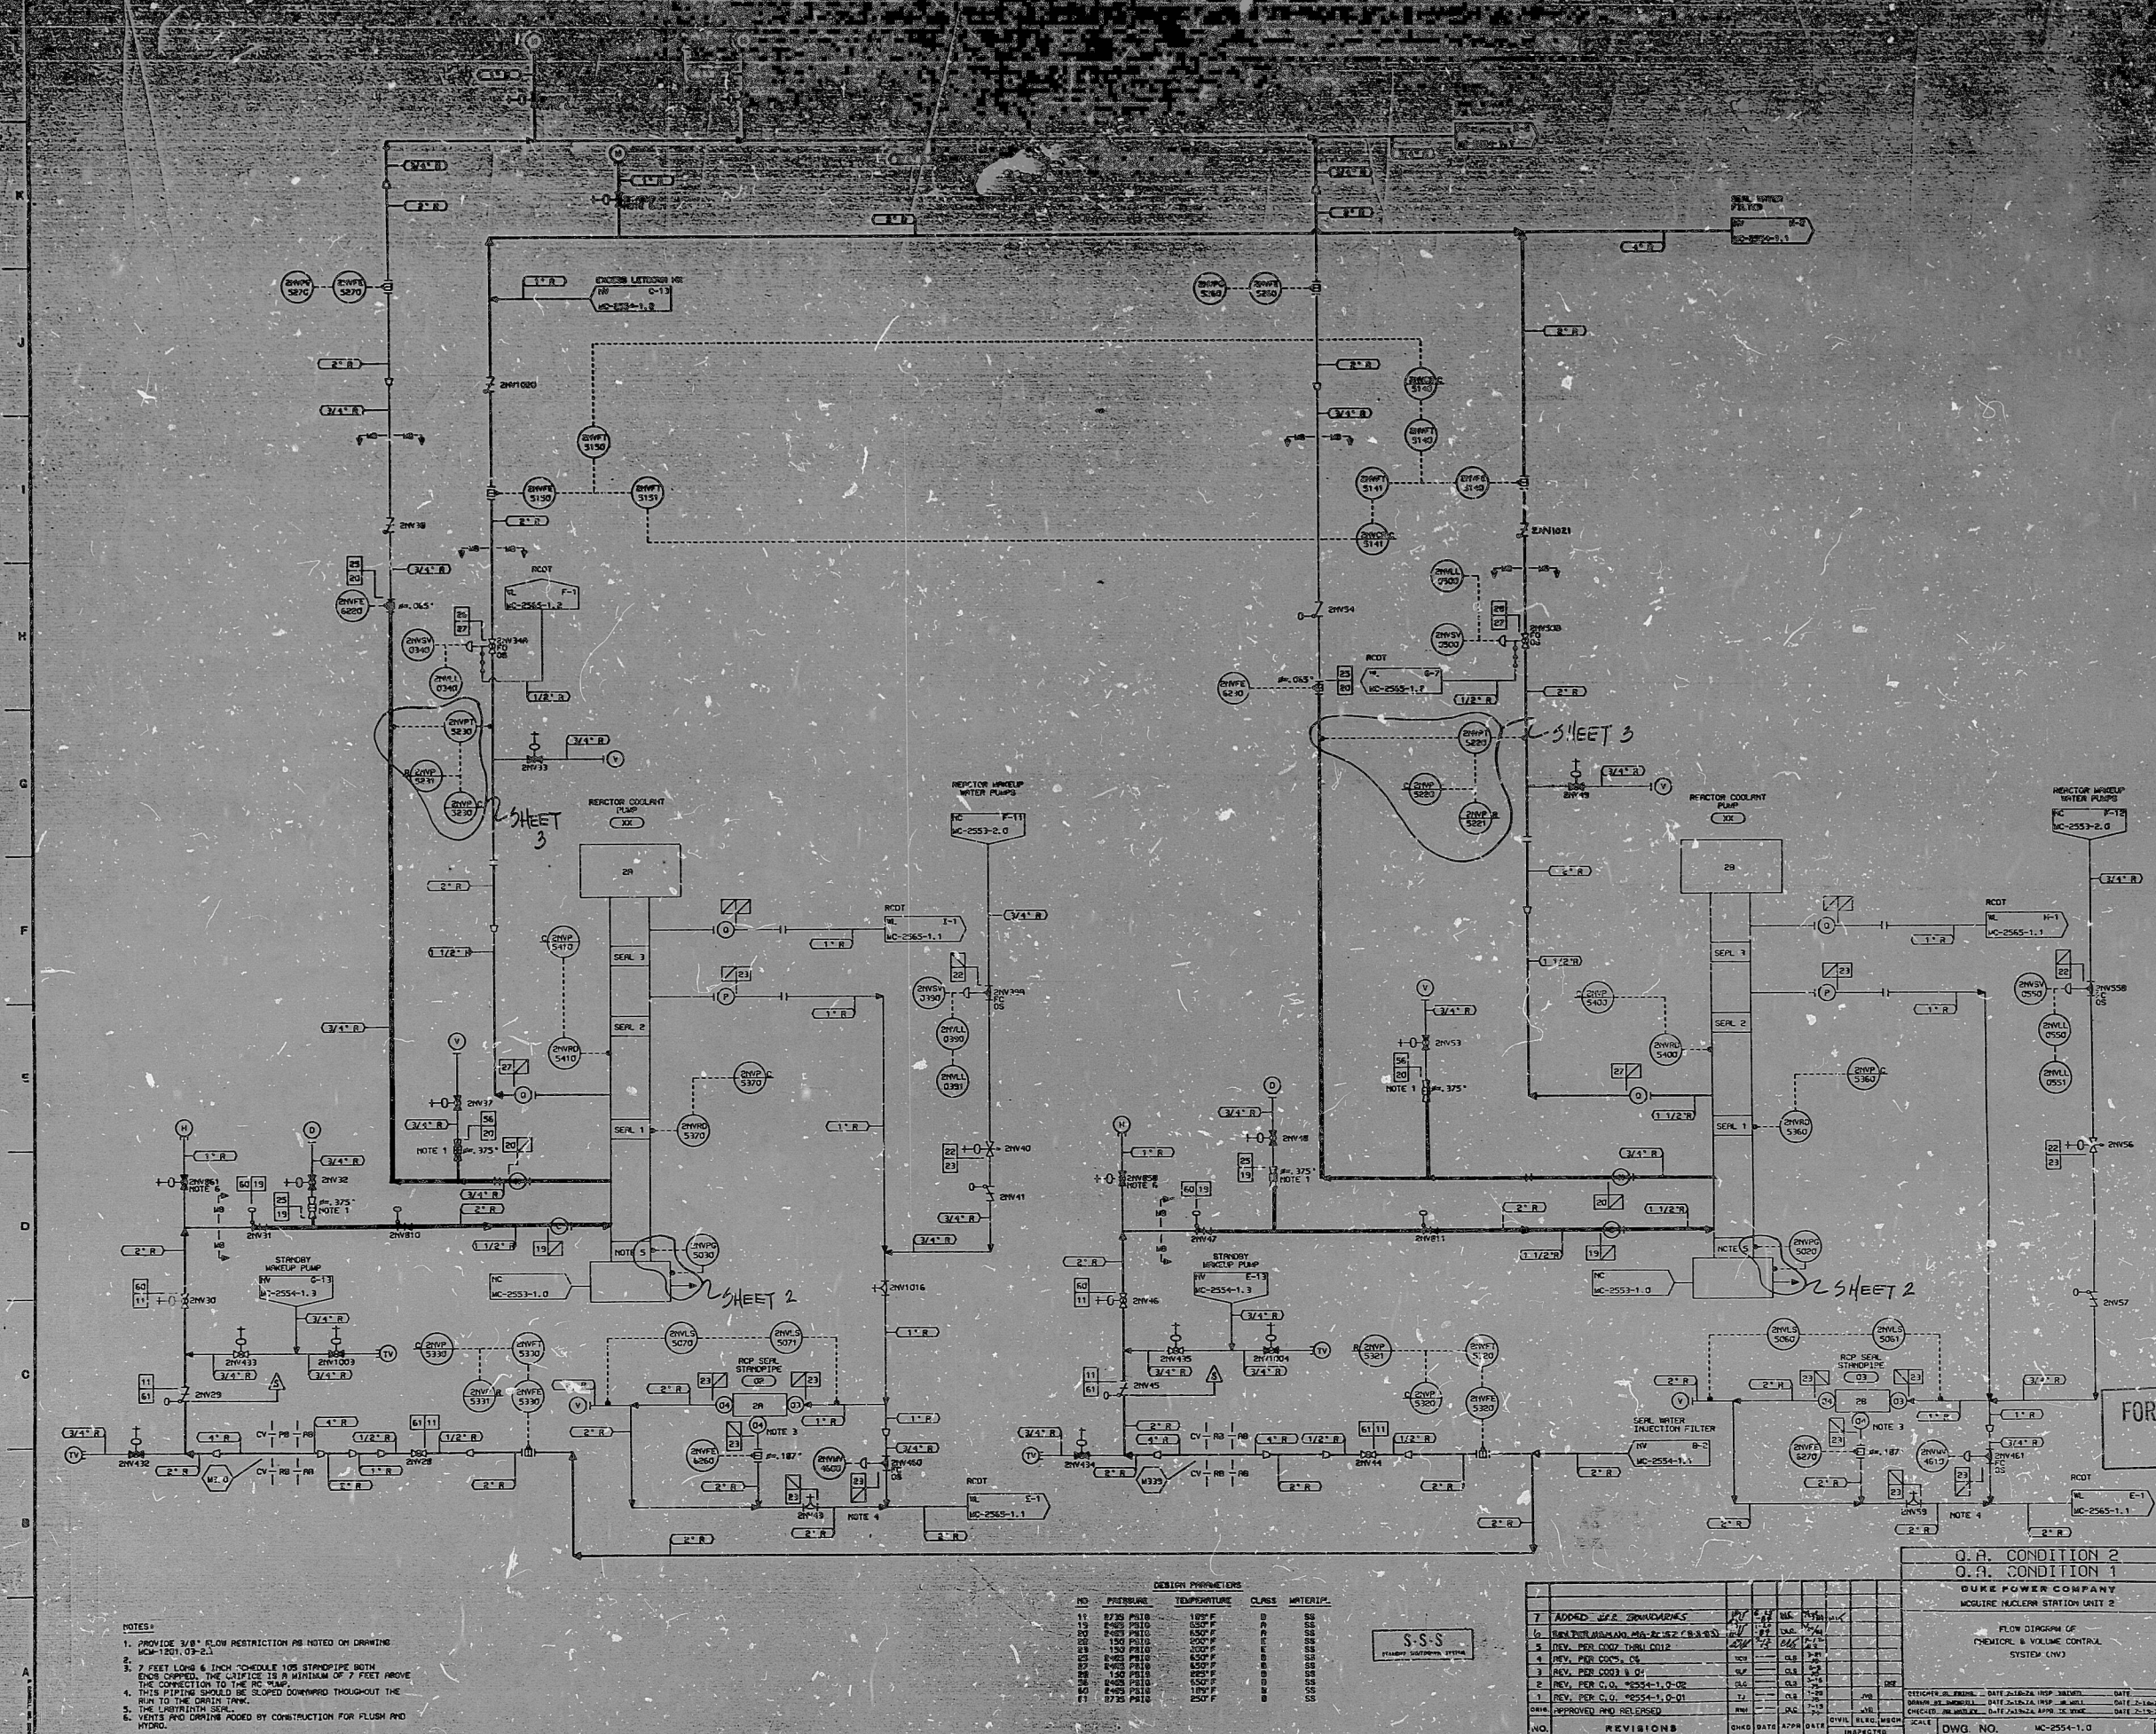

- NOTES:
1. PROVIDE 3/8" FLOW RESTRICTION AS NOTED ON DRAWING
 2. 1" FEED 03-21
 6. VENTS AND DRAINING ADDED BY CONSTRUCTION FOR FLUSH AND HYDRO.

DESIGN PARAMETERS

S-S

REVISIONS

NO.	REVISIONS	DATE	BY	CHKD

O.A. CONDITION 2
O.A. CONDITION 1
DUKE POWER COMPANY
MCURE NUCLEAR STATION UNIT 2
FLOW DIAGRAM OF

FOR INFORMATION ONLY

SI APERTURE CARD

CL: 1/4/80

3/11

8904060308

PDR RIDS

