



J-08-0 SHT. 6

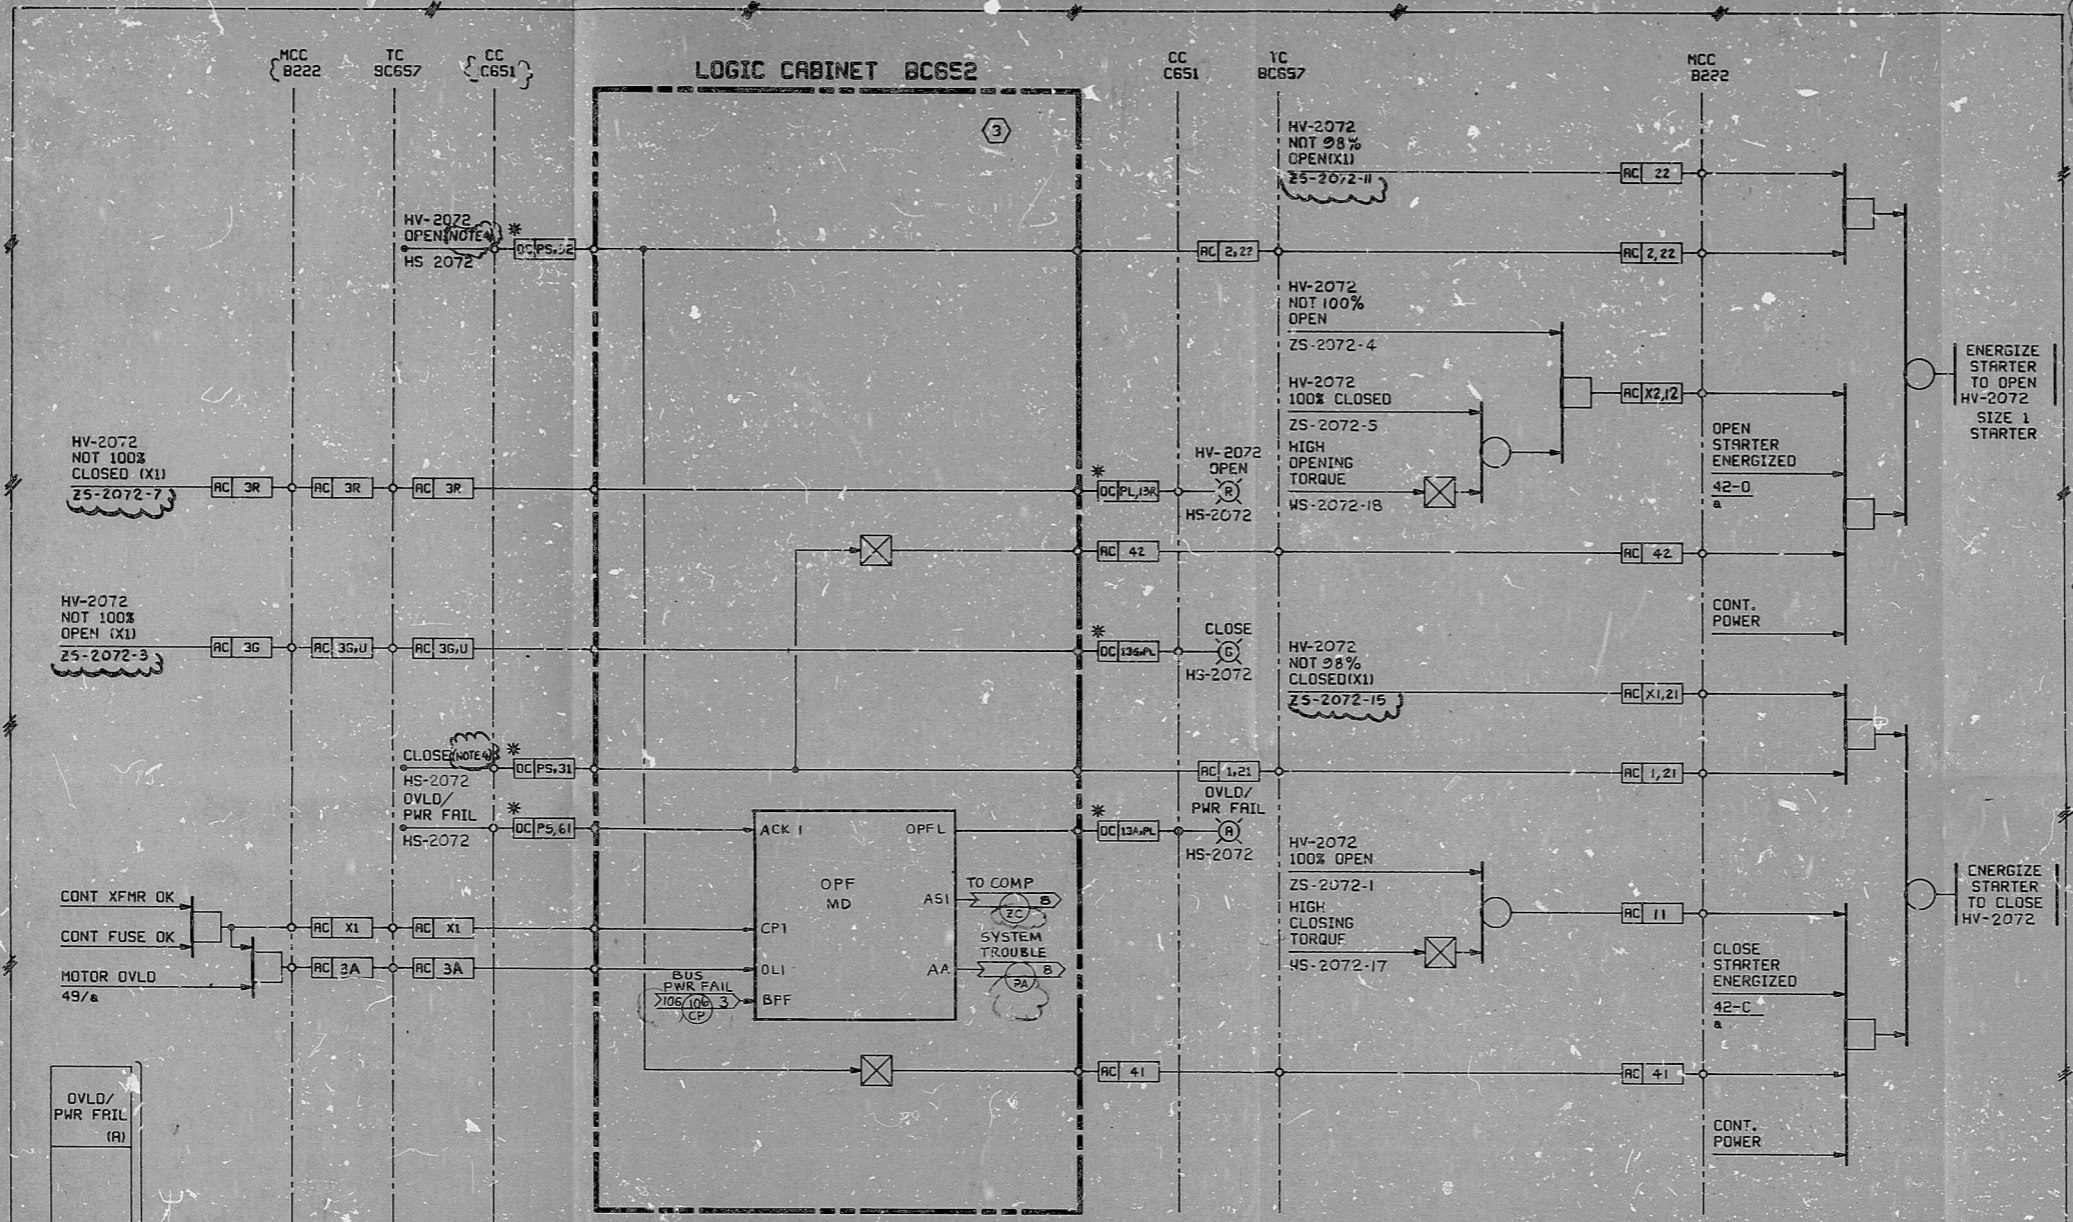

NOTES:  
 1. THE BASIC POSITION SWITCH AND TORQUE SWITCH NUMBERS FOR EACH VALVE ARE GIVEN IN THE TABLE. DASH NUMBERS TO IDENTIFY SPECIFIC SWITCHES SHALL BE ADDED AS SHOWN ON THE DIAGRAM.  
 2. DELETED.  
 3. RESETS FOLLOWING RESTORATION OF BUS POWER.  
 4. THE LOGIC ON THIS SHEET IS APPLICABLE TO HV-2072, HV-2073 AND FOR HV-2069 THE PUSHBUTTONS 'OPEN' AND 'CLOSE' POSITIONS ARE REPLACED BY KEY SWITCH POSITIONS.

PRO APERTURE CARD

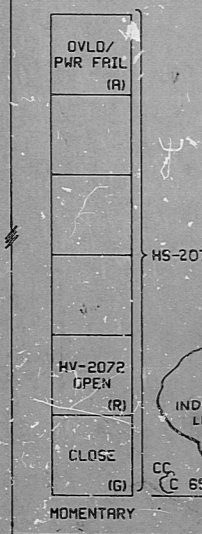

REACTOR BUILDING SERVICE SHUTOFF VALVE HV-2072  
 CLASS 1E CHANNEL B

CROSS REFERENCE TABLE

VALVE NO.	HAND SW.	POSITION SW. (NOTE 1)	TORQUE SW. (NOTE 1)	CKT. NO.	CC	LC	TC	MCC	CLASS 1E CHANNEL	START UP CODE	BUS POWER FAIL APPROV	COMPUTER INPUT APPROV	SYSTEM TROUBLE APPROV
HV-2072	HS-2072	ZS-2072	WS-2072	3	C651A	BC652	BC657	B222	B	AP	J-106, SHT. 2 CKT. 9, ARROW 01	2C, SHT. 8	PA, SHT. 8
HV-2073	HS-2073	ZS-2073	WS-2073	6	C651A	BC652	BC657	B223	B	AP	J-106, SHT. 2 CKT. 9, ARROW 01	2E, SHT. 8	PC, SHT. 8
HV-2069	HS-2069	ZS-2069	WS-2069	2	C650D	AC652	AC657	B242	A	BN	J-106, SHT. 2 CKT. 9, ARROW 01	2F, SHT. 8	PD, SHT. 8

NO.	DATE	REVISIONS	BY	CHKD	REVISD	ENGR	ENGR	APPR
1	6/1/82	DESIGN FREEZE ISSUE & UNIT 2 DELETION	...	...	...	...	...	...
2	7/1/81	REVISED PER DEN 1 & 3	...	...	...	...	...	...
3	9/21/80	REVISED BAILEY INTERFACE AS NOTED	...	...	...	...	...	...
4	7/2/79	REVISED AS NOTED	...	...	...	...	...	...
5	11/7/78	REVISED AS NOTED	...	...	...	...	...	...
6	11/7/78	REVISED AND REDRAWN	...	...	...	...	...	...
7	10/20/76	ISSUED FOR CONSTRUCTION	...	...	...	...	...	...

**BECHTEL**  
 SAN FRANCISCO

PUBLIC SERVICE ELECTRIC AND GAS COMPANY  
 HOPE CREEK GENERATING STATION

**LOGIC DIAGRAM**  
 CONDENSATE RECEIVING WATER STORAGE & TRANSFER  
 REACTOR BLDG SERVICE SHUTOFF VALVE HV-2072

SCALE: NONE  
 DESIGNED: P. WONG  
 DRAWN: RCG

JOB NO. 18855  
 DRAWING NO. J-08-0 SHT. 6  
 REV. 6

This drawing and the design it covers are the property of BECHTEL. They are hereby leased and on the borrower's express agreement that they will not be reproduced, copied, loaned, exhibited, or used except in the limited way and under the conditions set forth in the schedule to this agreement.

RIDS

8307270990

