M-467 SH.1

SIZE E

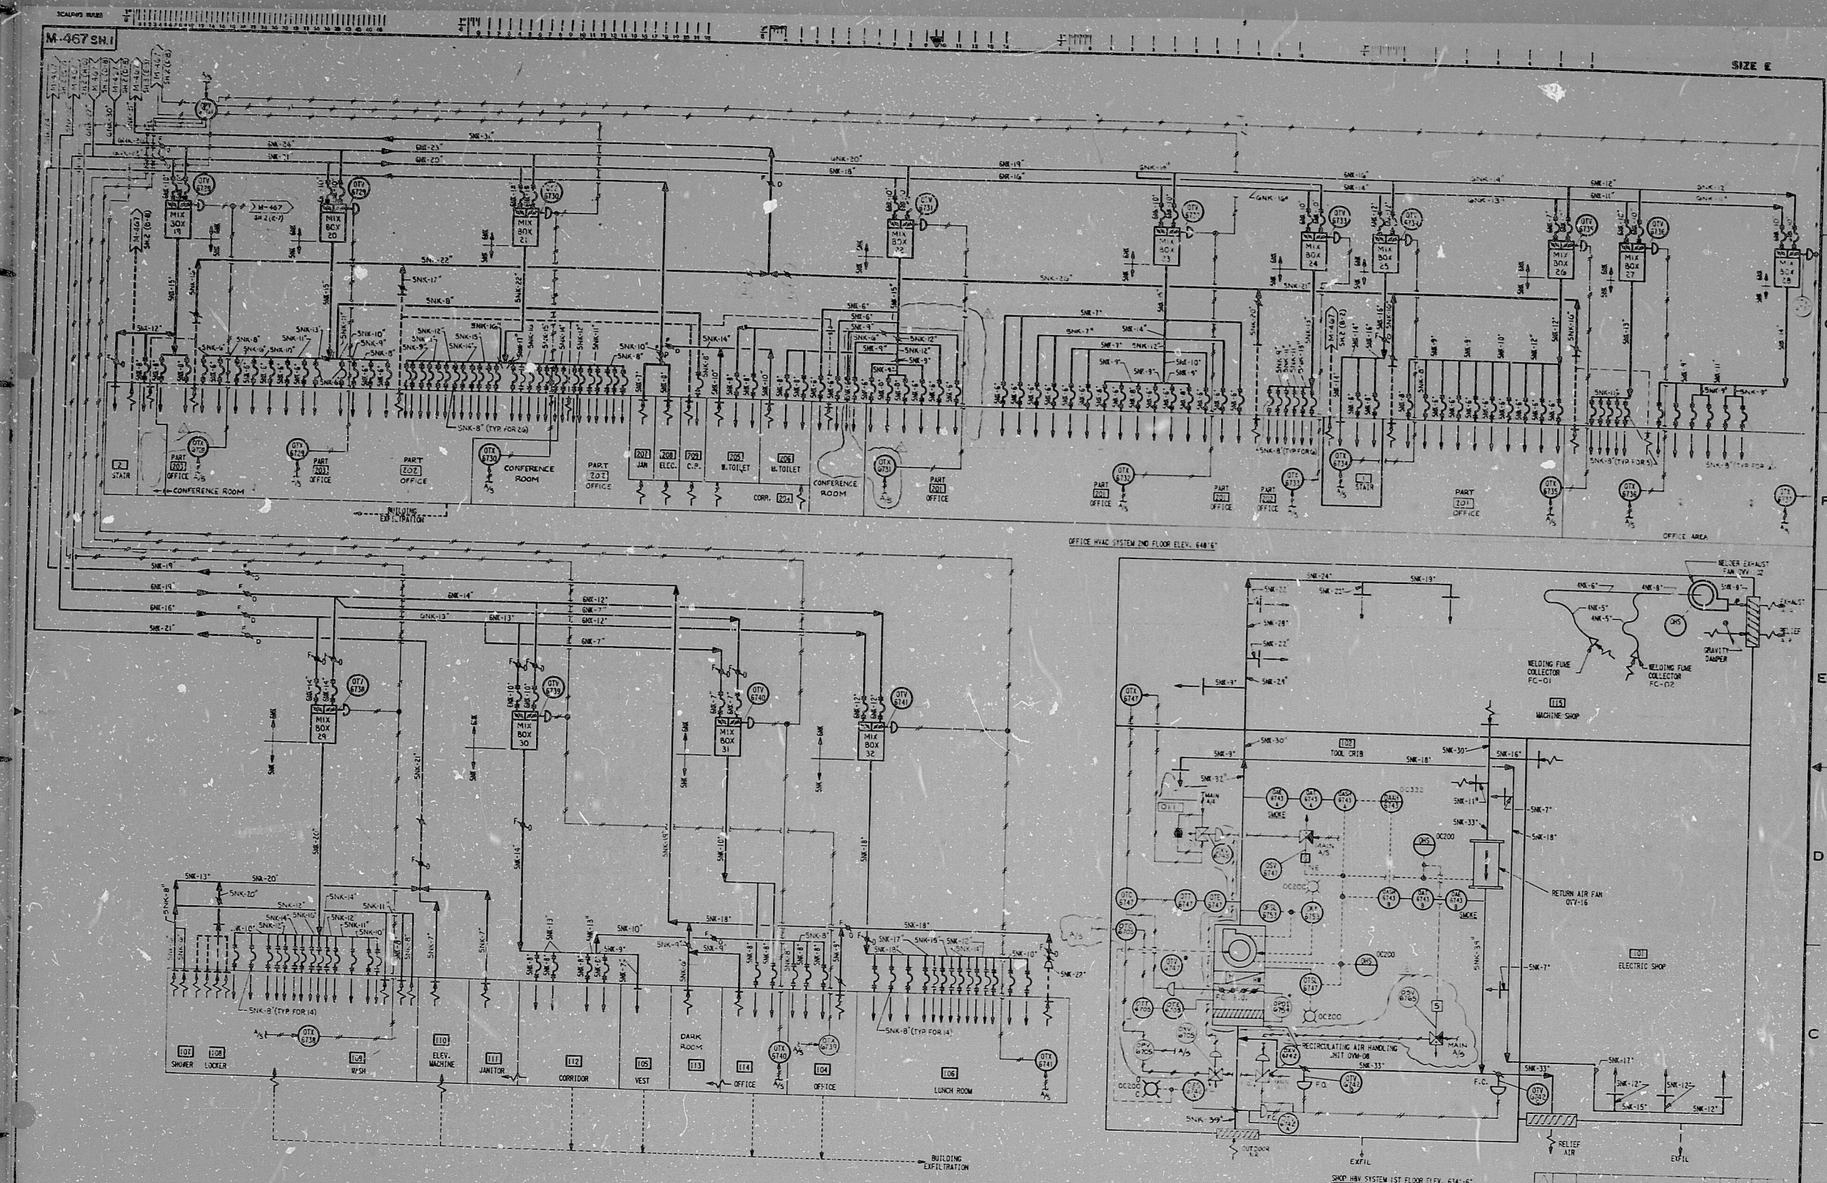

NOTES:

1. SYMBOL INDICATES FLEXIBLE CONNECTION.
2. ALL BRANCH DUCTWORK TO LIGHT TROFFER DIFFUSERS CONTAIN BALANCING DAMPERS.

NO.	DATE	REVISION	BY	CHK'D
3	12-6-67	REVISED AND REISSUED		
2	10-6-67	REVISED AND REDRAWN, INCORP DCN #3 (MODIFIED)		
1	7-21-67	REVISED AND REDRAWN, WAS TWO SHEETS, ISSUED FOR CONSTRUCTION		
0	5-19-67	ISSUED FOR CONSTRUCTION		

DES. NONE | DR. W.D. APPEL | TRACED ITIL

BECHTEL
ANN ARBOR, MICHIGAN

MIDLAND PLANT UNITS 1 & 2
CONSUMERS POWER COMPANY

PIPING AND INSTRUMENT DIAGRAM
HEATING VENTILATING & AIR CONDITION'G
OFFICE & SERVICE BUILDING

JOB No.	DRAWING No.	REV
7220	M-467 SH.1	2

POOR ORIGINAL

TERA APERTURE CARD

30X

R:DS

8112230074

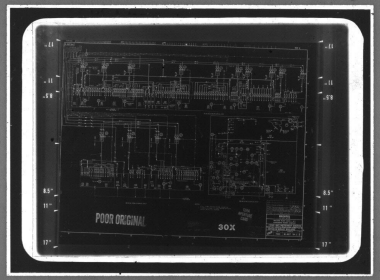

MMM 5824 — FILMSORT® Brand Aperture & Camera Cards and DUPLICARD® Brand Copy Cards — Product of 3M Company, St. Paul, Minn.