

66 11


66 11

66 8.5

66 8.5

66 11

66 17

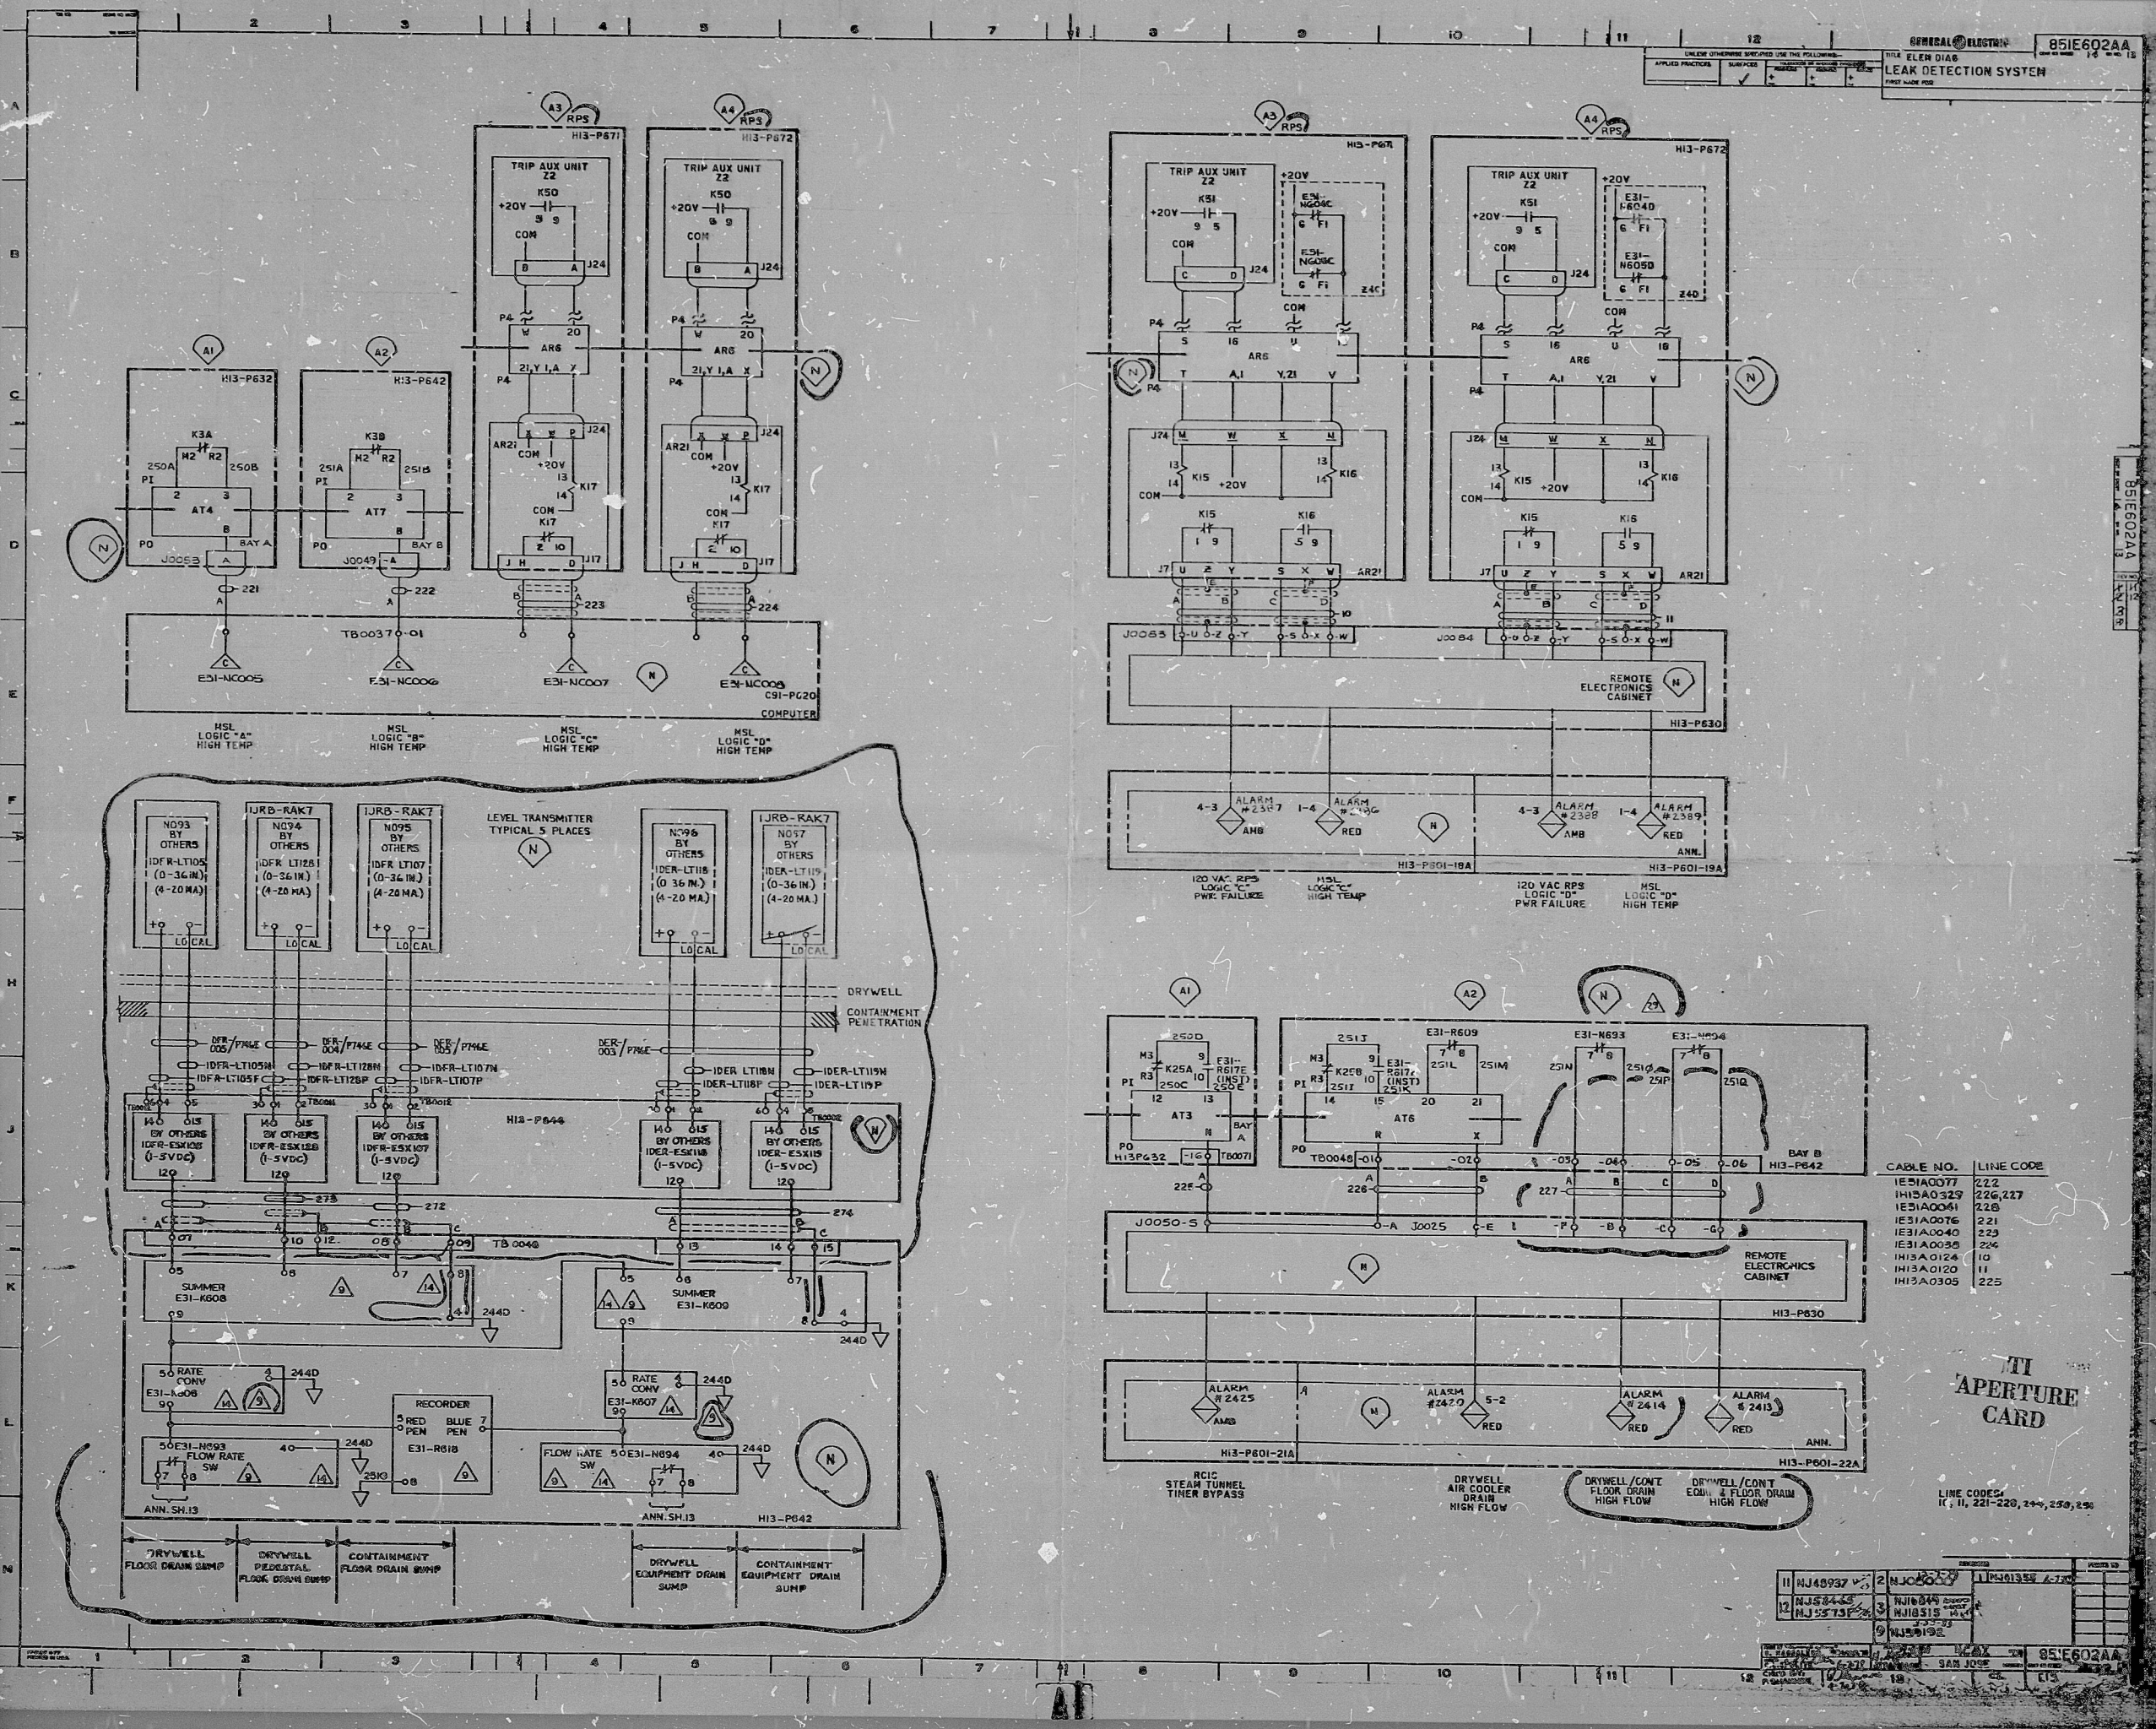

GENERAL ELECTRIC 851E602AA
 TITLE ELEM DIAG
 LEAK DETECTION SYSTEM
 FIRST MADE FOR

CABLE NO.	LINE CODE
IE31A0077	222
IE31A0329	226, 227
IE31A0041	228
IE31A0076	221
IE31A0040	229
IE31A0035	224
IE31A0305	225

TI
 APERTURE
 CARD

LINE CODES


851E602AA
 851E602AA
 851E602AA

66 11

66 11

66 8.5

66 8.5

66 11

66 17

8412190156

PDR RIDS

