

11

11


8.5

8.5

11

17


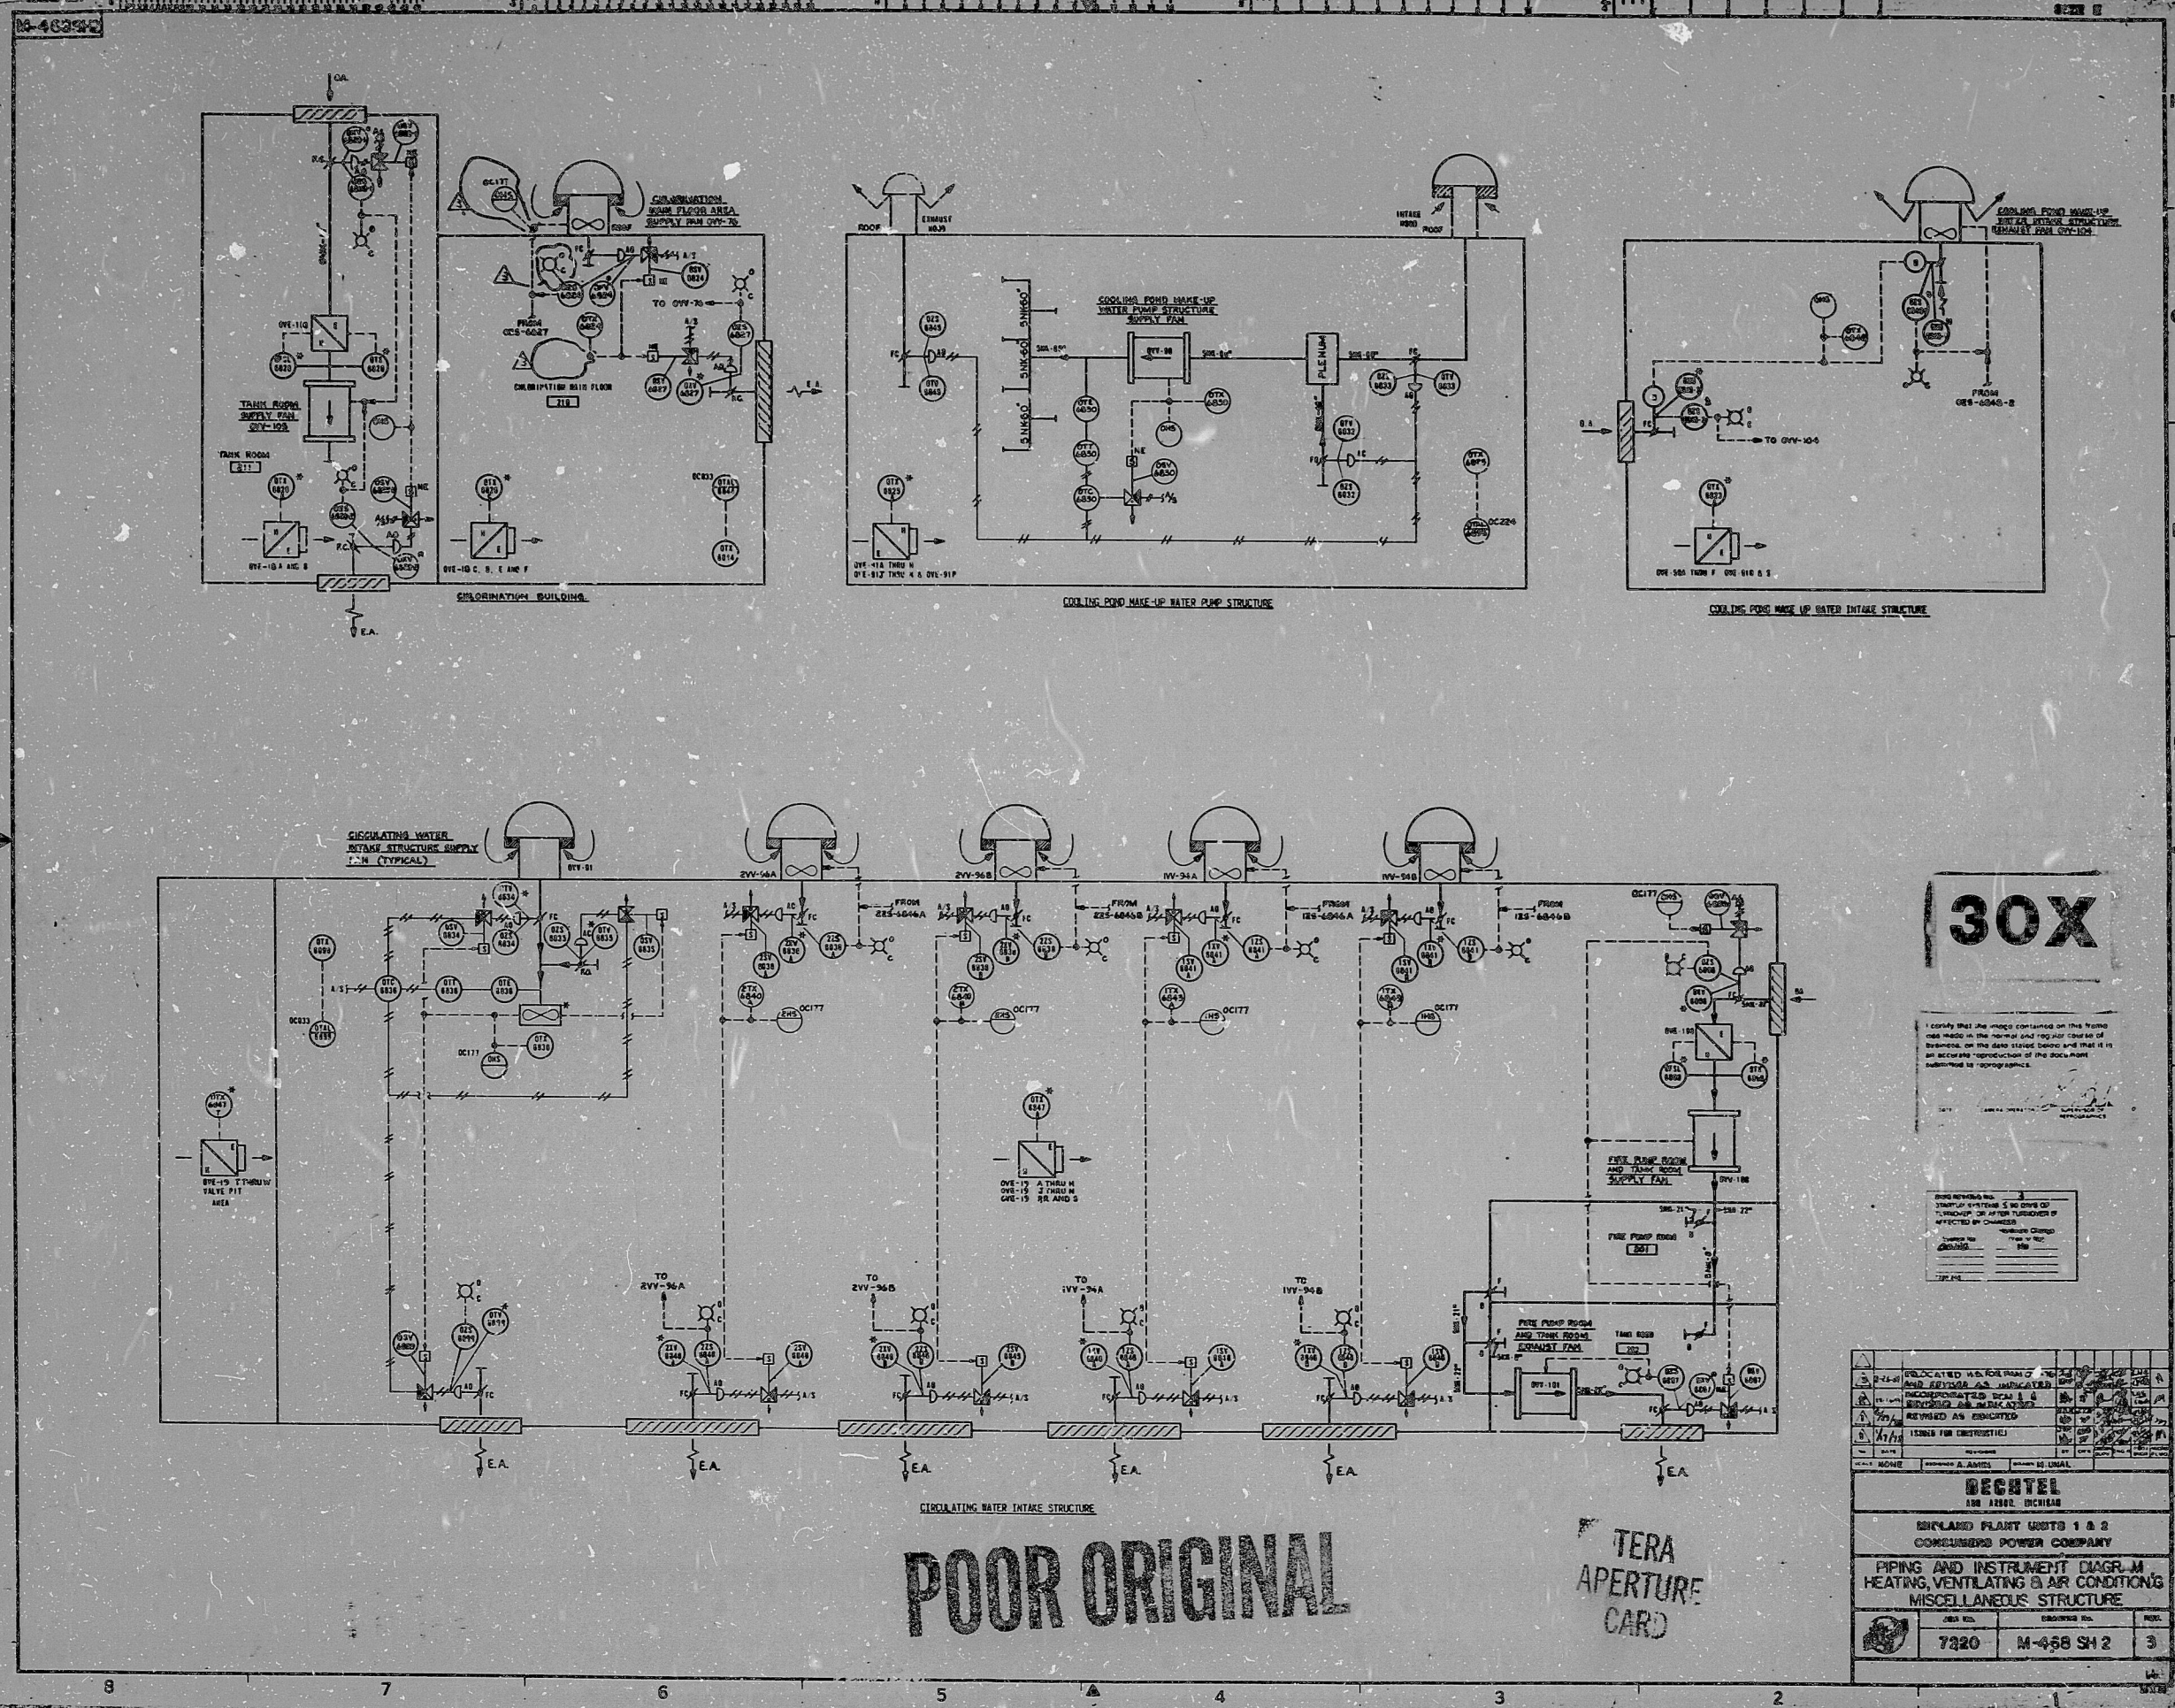

POOR ORIGINAL

TERA APERTURE CARD

30X

I certify that the design contained on this drawing was made in the normal and proper course of business, on the date stated herein, and that it is an accurate representation of the work actually performed by me or under my direct supervision.

DESIGNED BY: [Signature]
CHECKED BY: [Signature]
DATE: [Date]

NO.	DATE	BY	REVISION


CONSUMERS POWER COMPANY

PIPING AND INSTRUMENT DIAGRAM
HEATING, VENTILATING & AIR CONDITIONING
MISCELLANEOUS STRUCTURE

JOB NO.	ENGINEER NO.	REV.
7320	M-458 SH2	3

11

11

8.5

8.5

11

17

RIDS

8112230079

