

11


11

9.9

8.5"

11"

17"

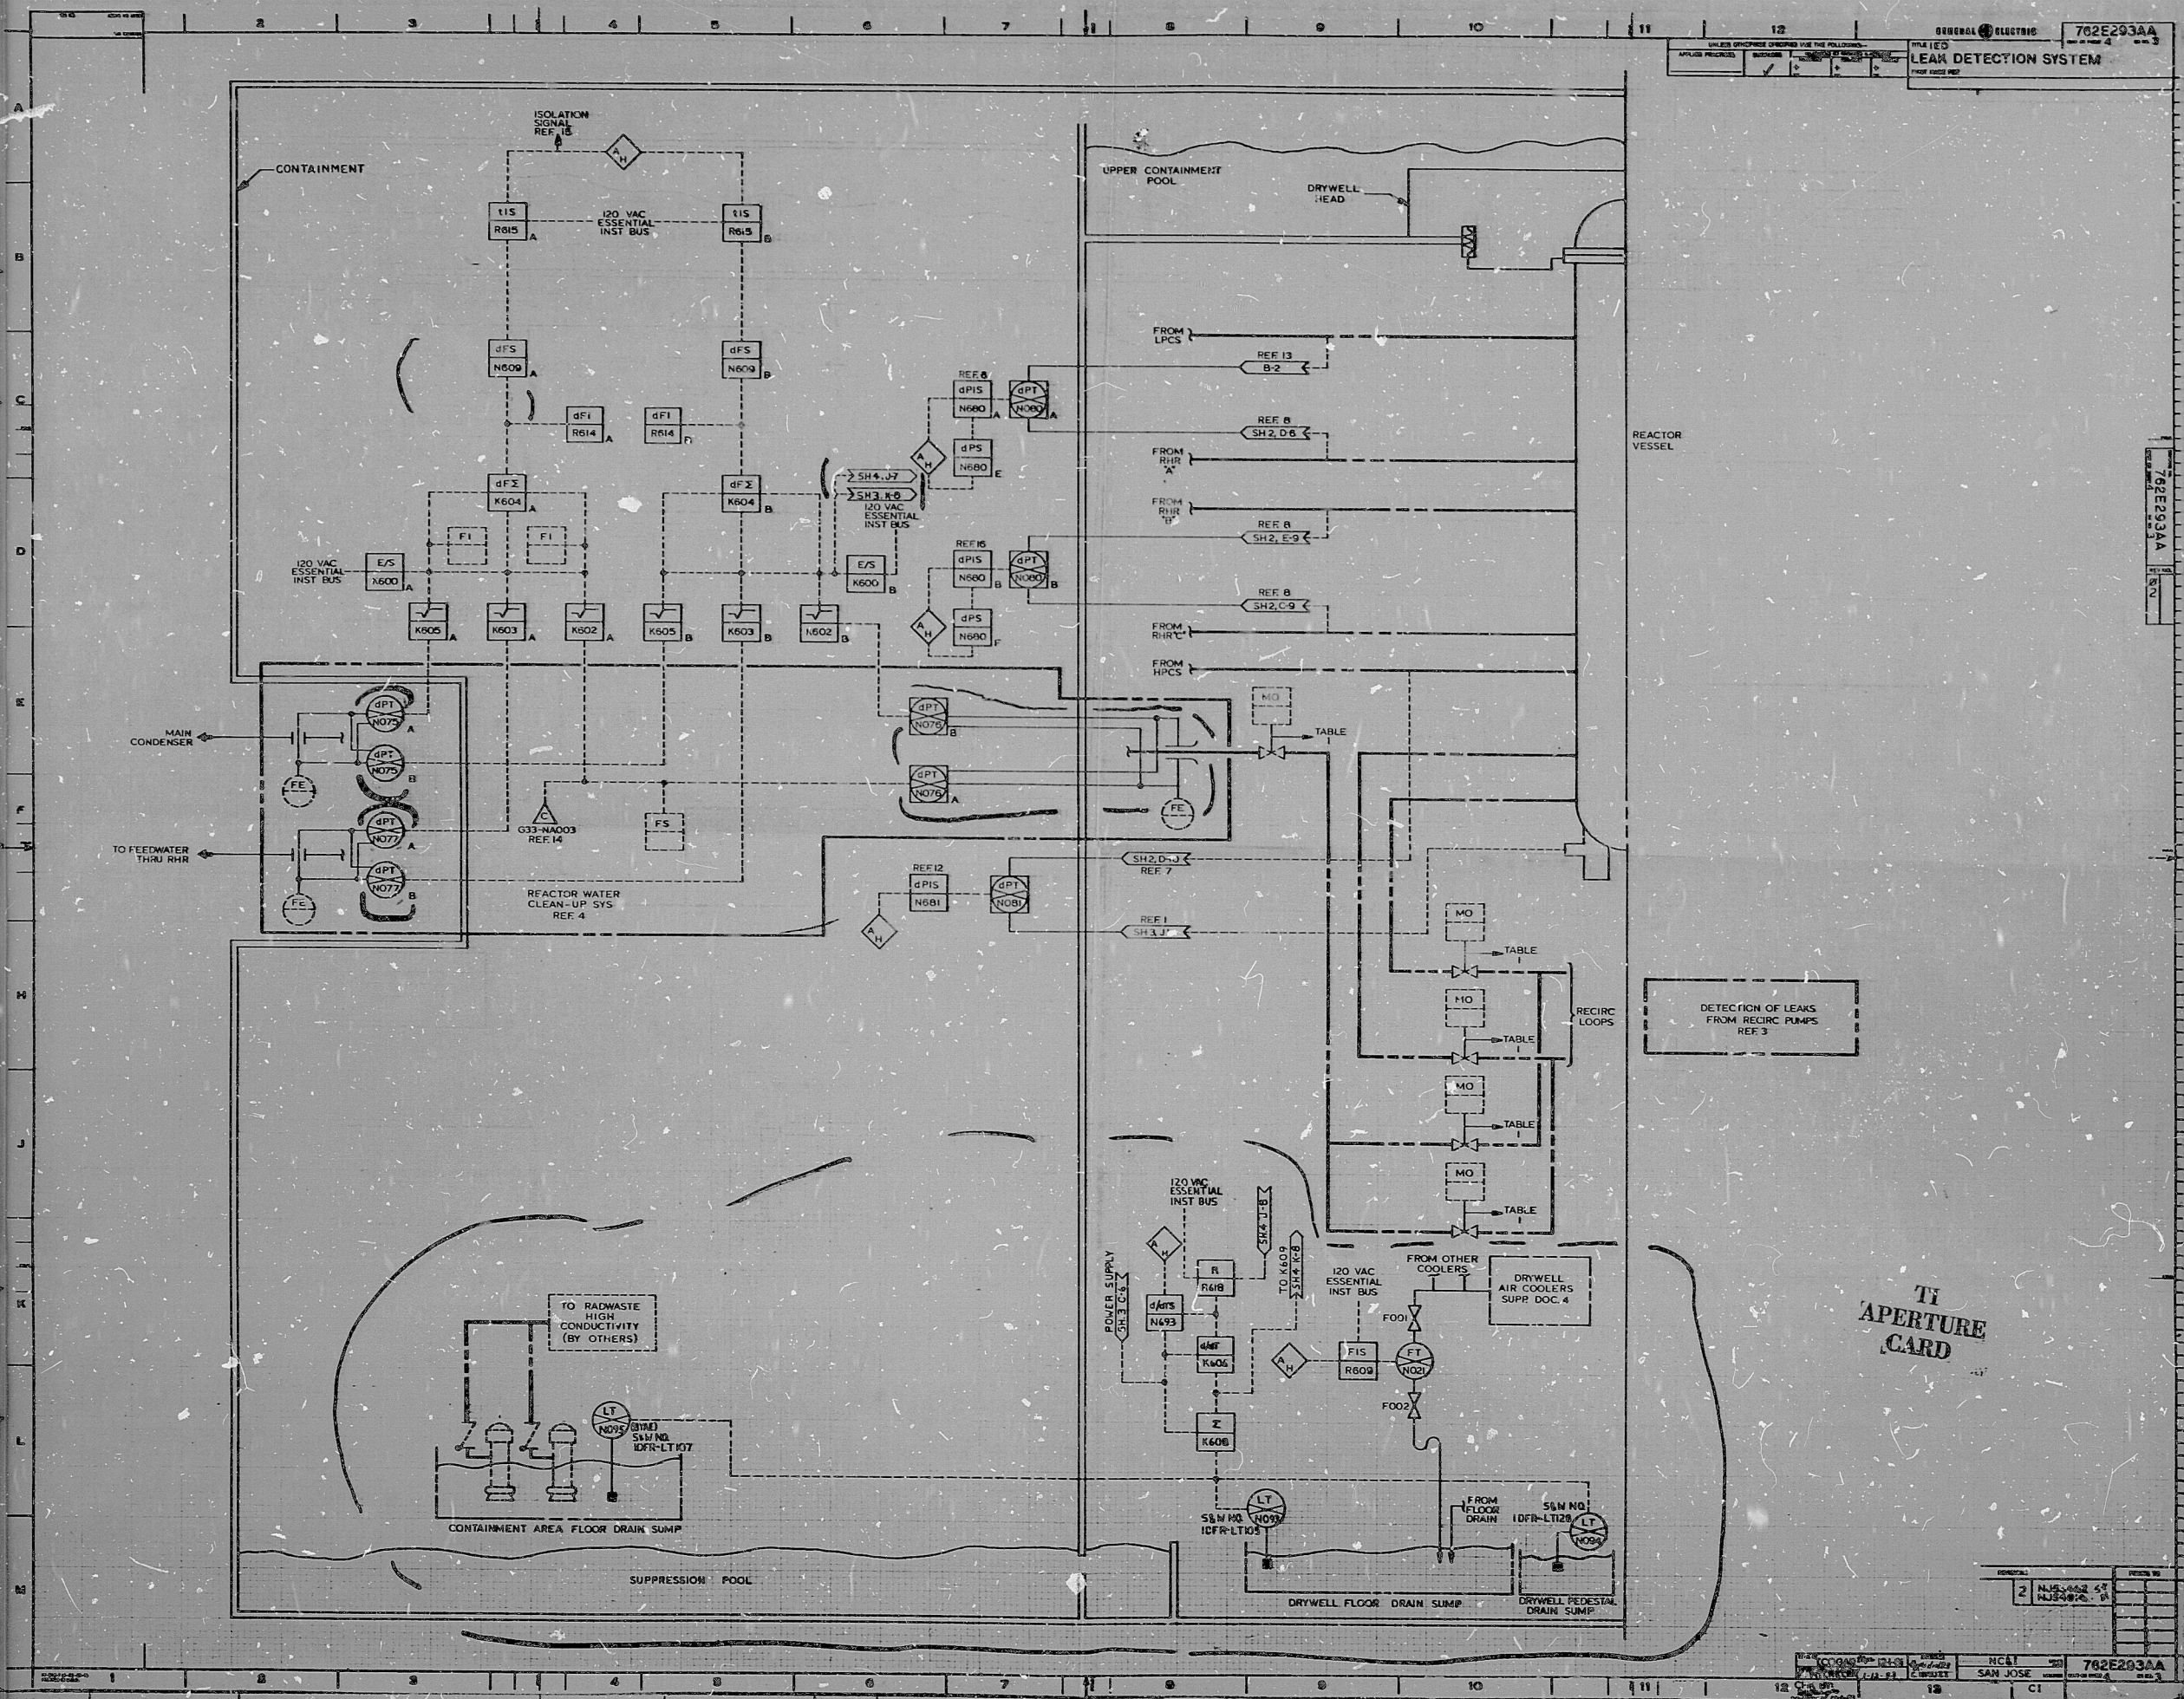

GENERAL ELECTRIC 762E293AA  
 LEAK DETECTION SYSTEM  
 762E293AA

762E293AA

11

11

9.8

8.5"

11"

17"

REV	NO	DATE	BY	CHKD
2				

762E293AA

8412190/65

PDR RIDS

