

41

5.8

8.5

10

17

41


5.8

8.5

8.5

11

17

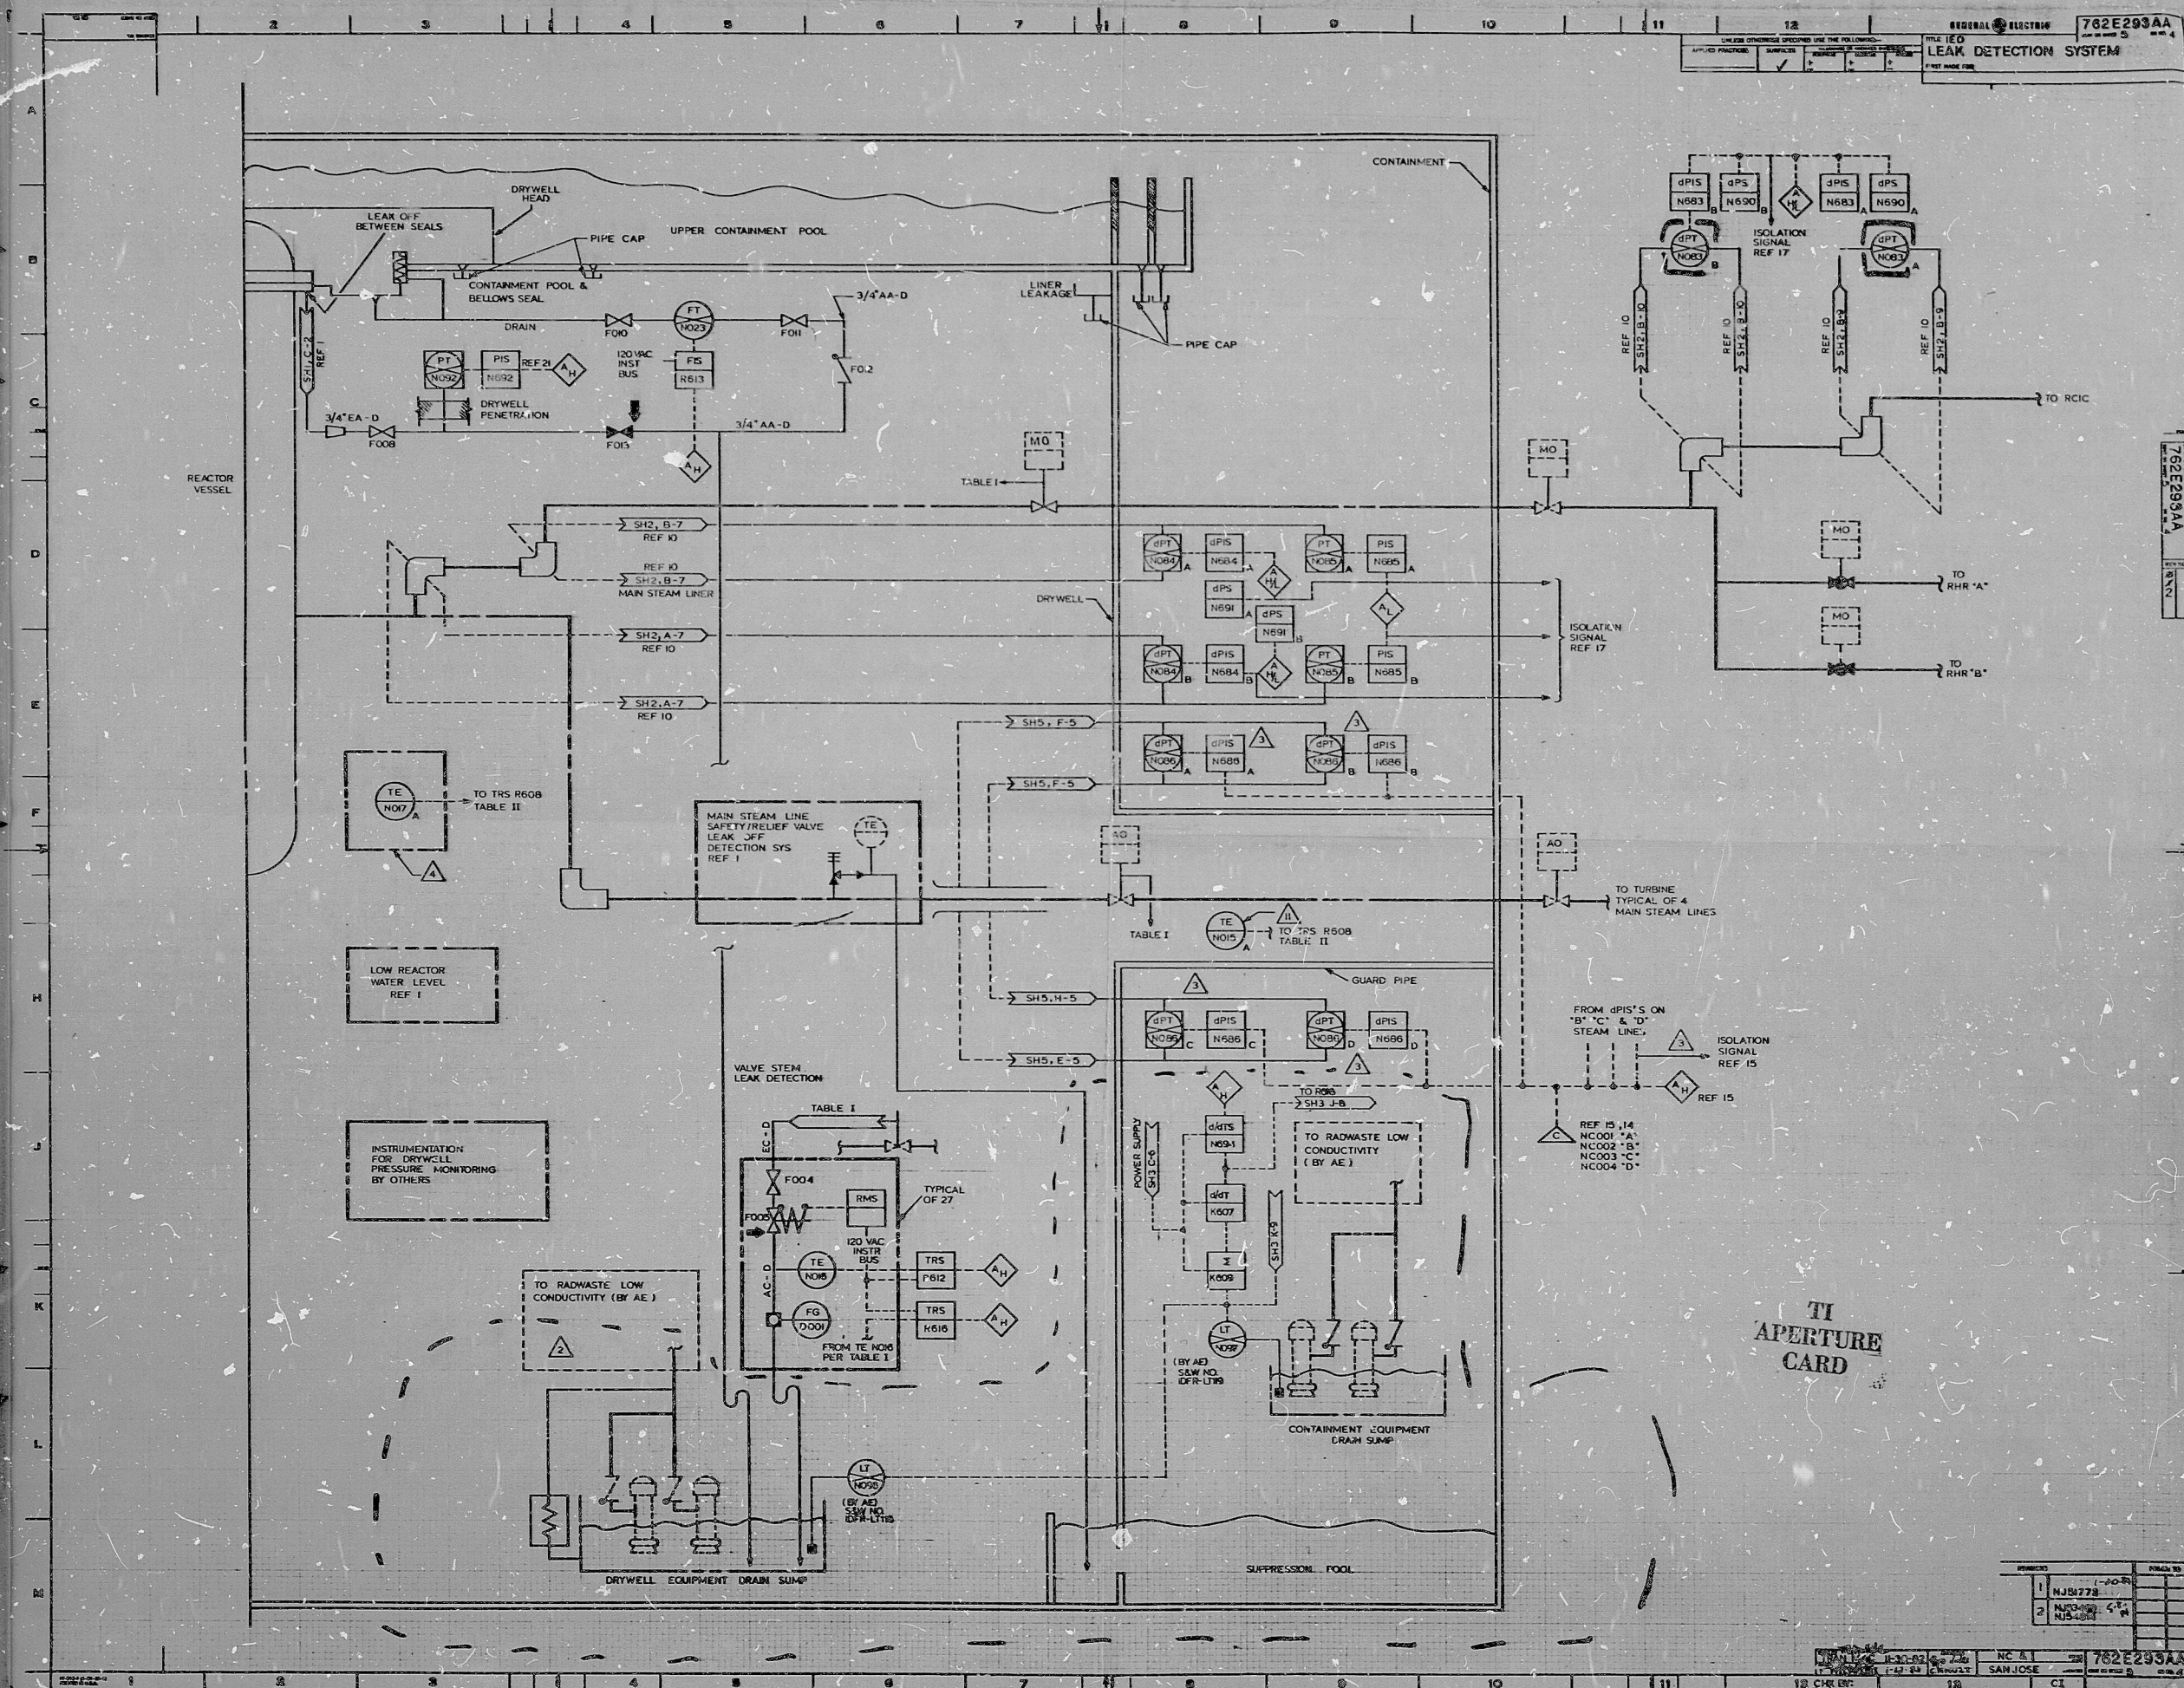

GENERAL ELECTRIC 762E293AA
LEAK DETECTION SYSTEM
FIRST ISSUE FOR

762E293AA

TI
APERTURE
CARD

1	NJS1778
2	NJS1779

762E293AA
SAN JOSE

PDR RIDS

8412190169

