


22"
17"
11"
8.5"
11"
17"
22"

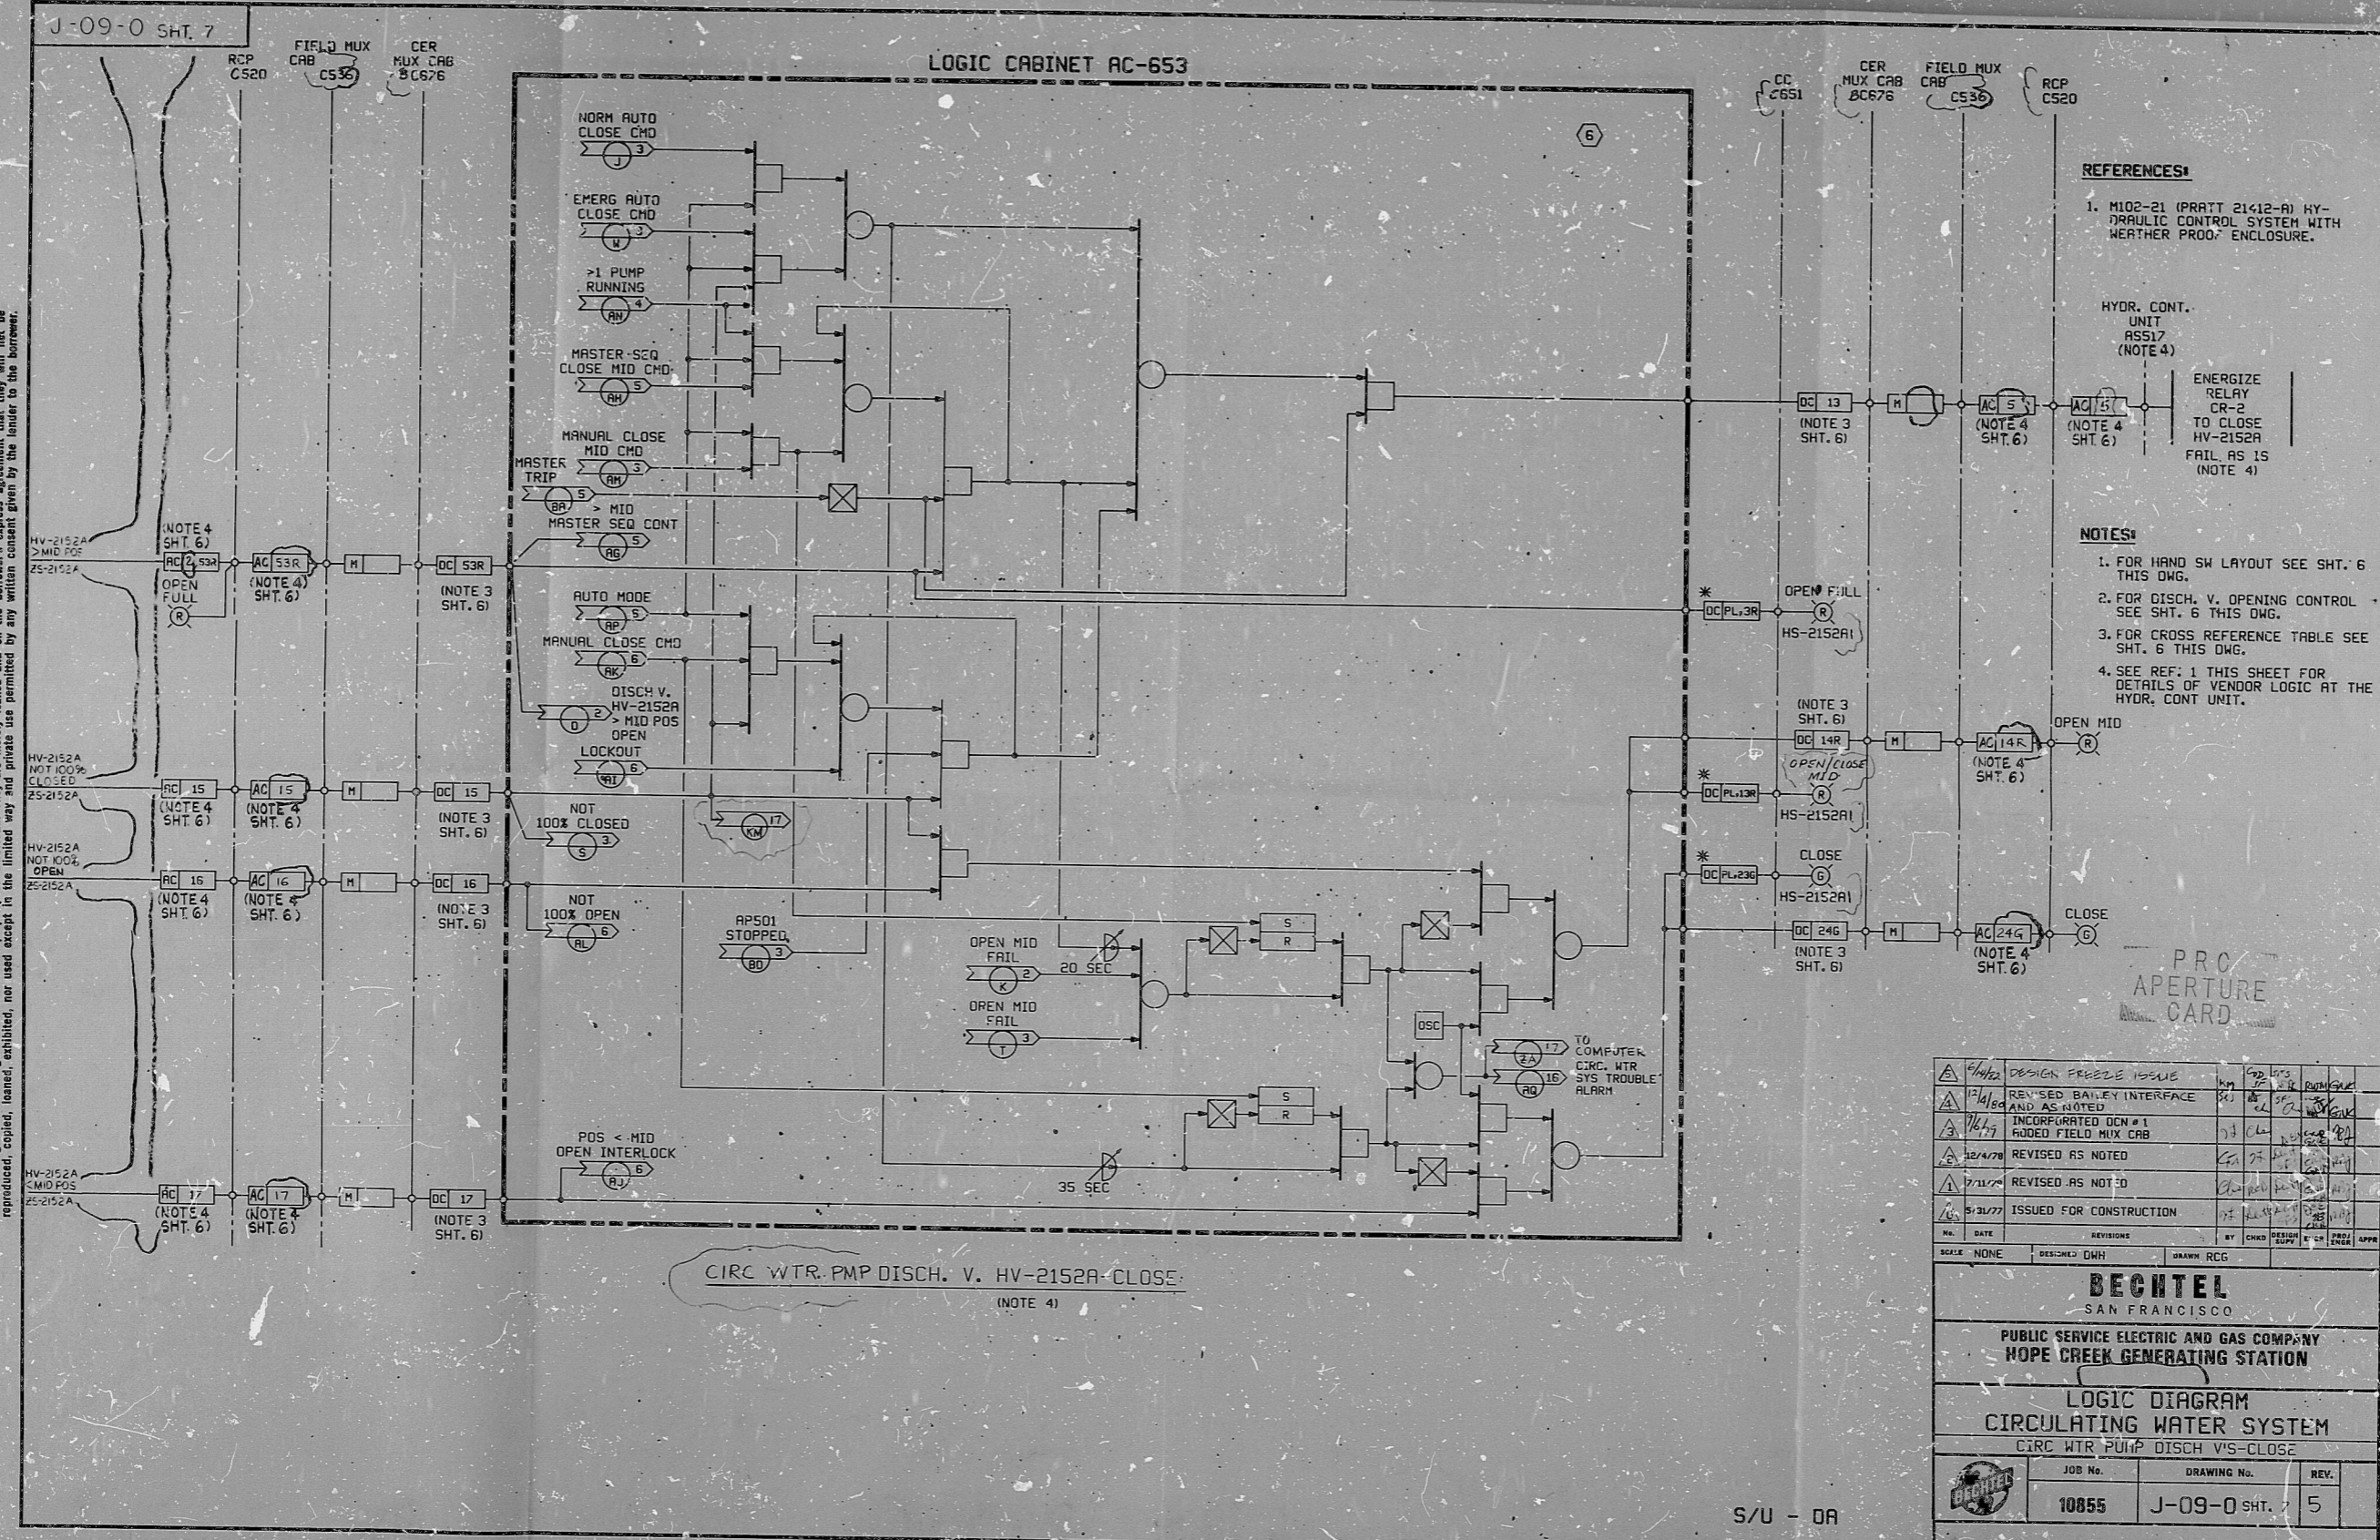

22"
17"
11"
8.5"
11"
17"
22"

RIDS

8307280017

