


17"  
11"  
8.5"  
8.5"  
11"  
17"

17"  
11"  
8.5"  
8.5"  
11"  
17"

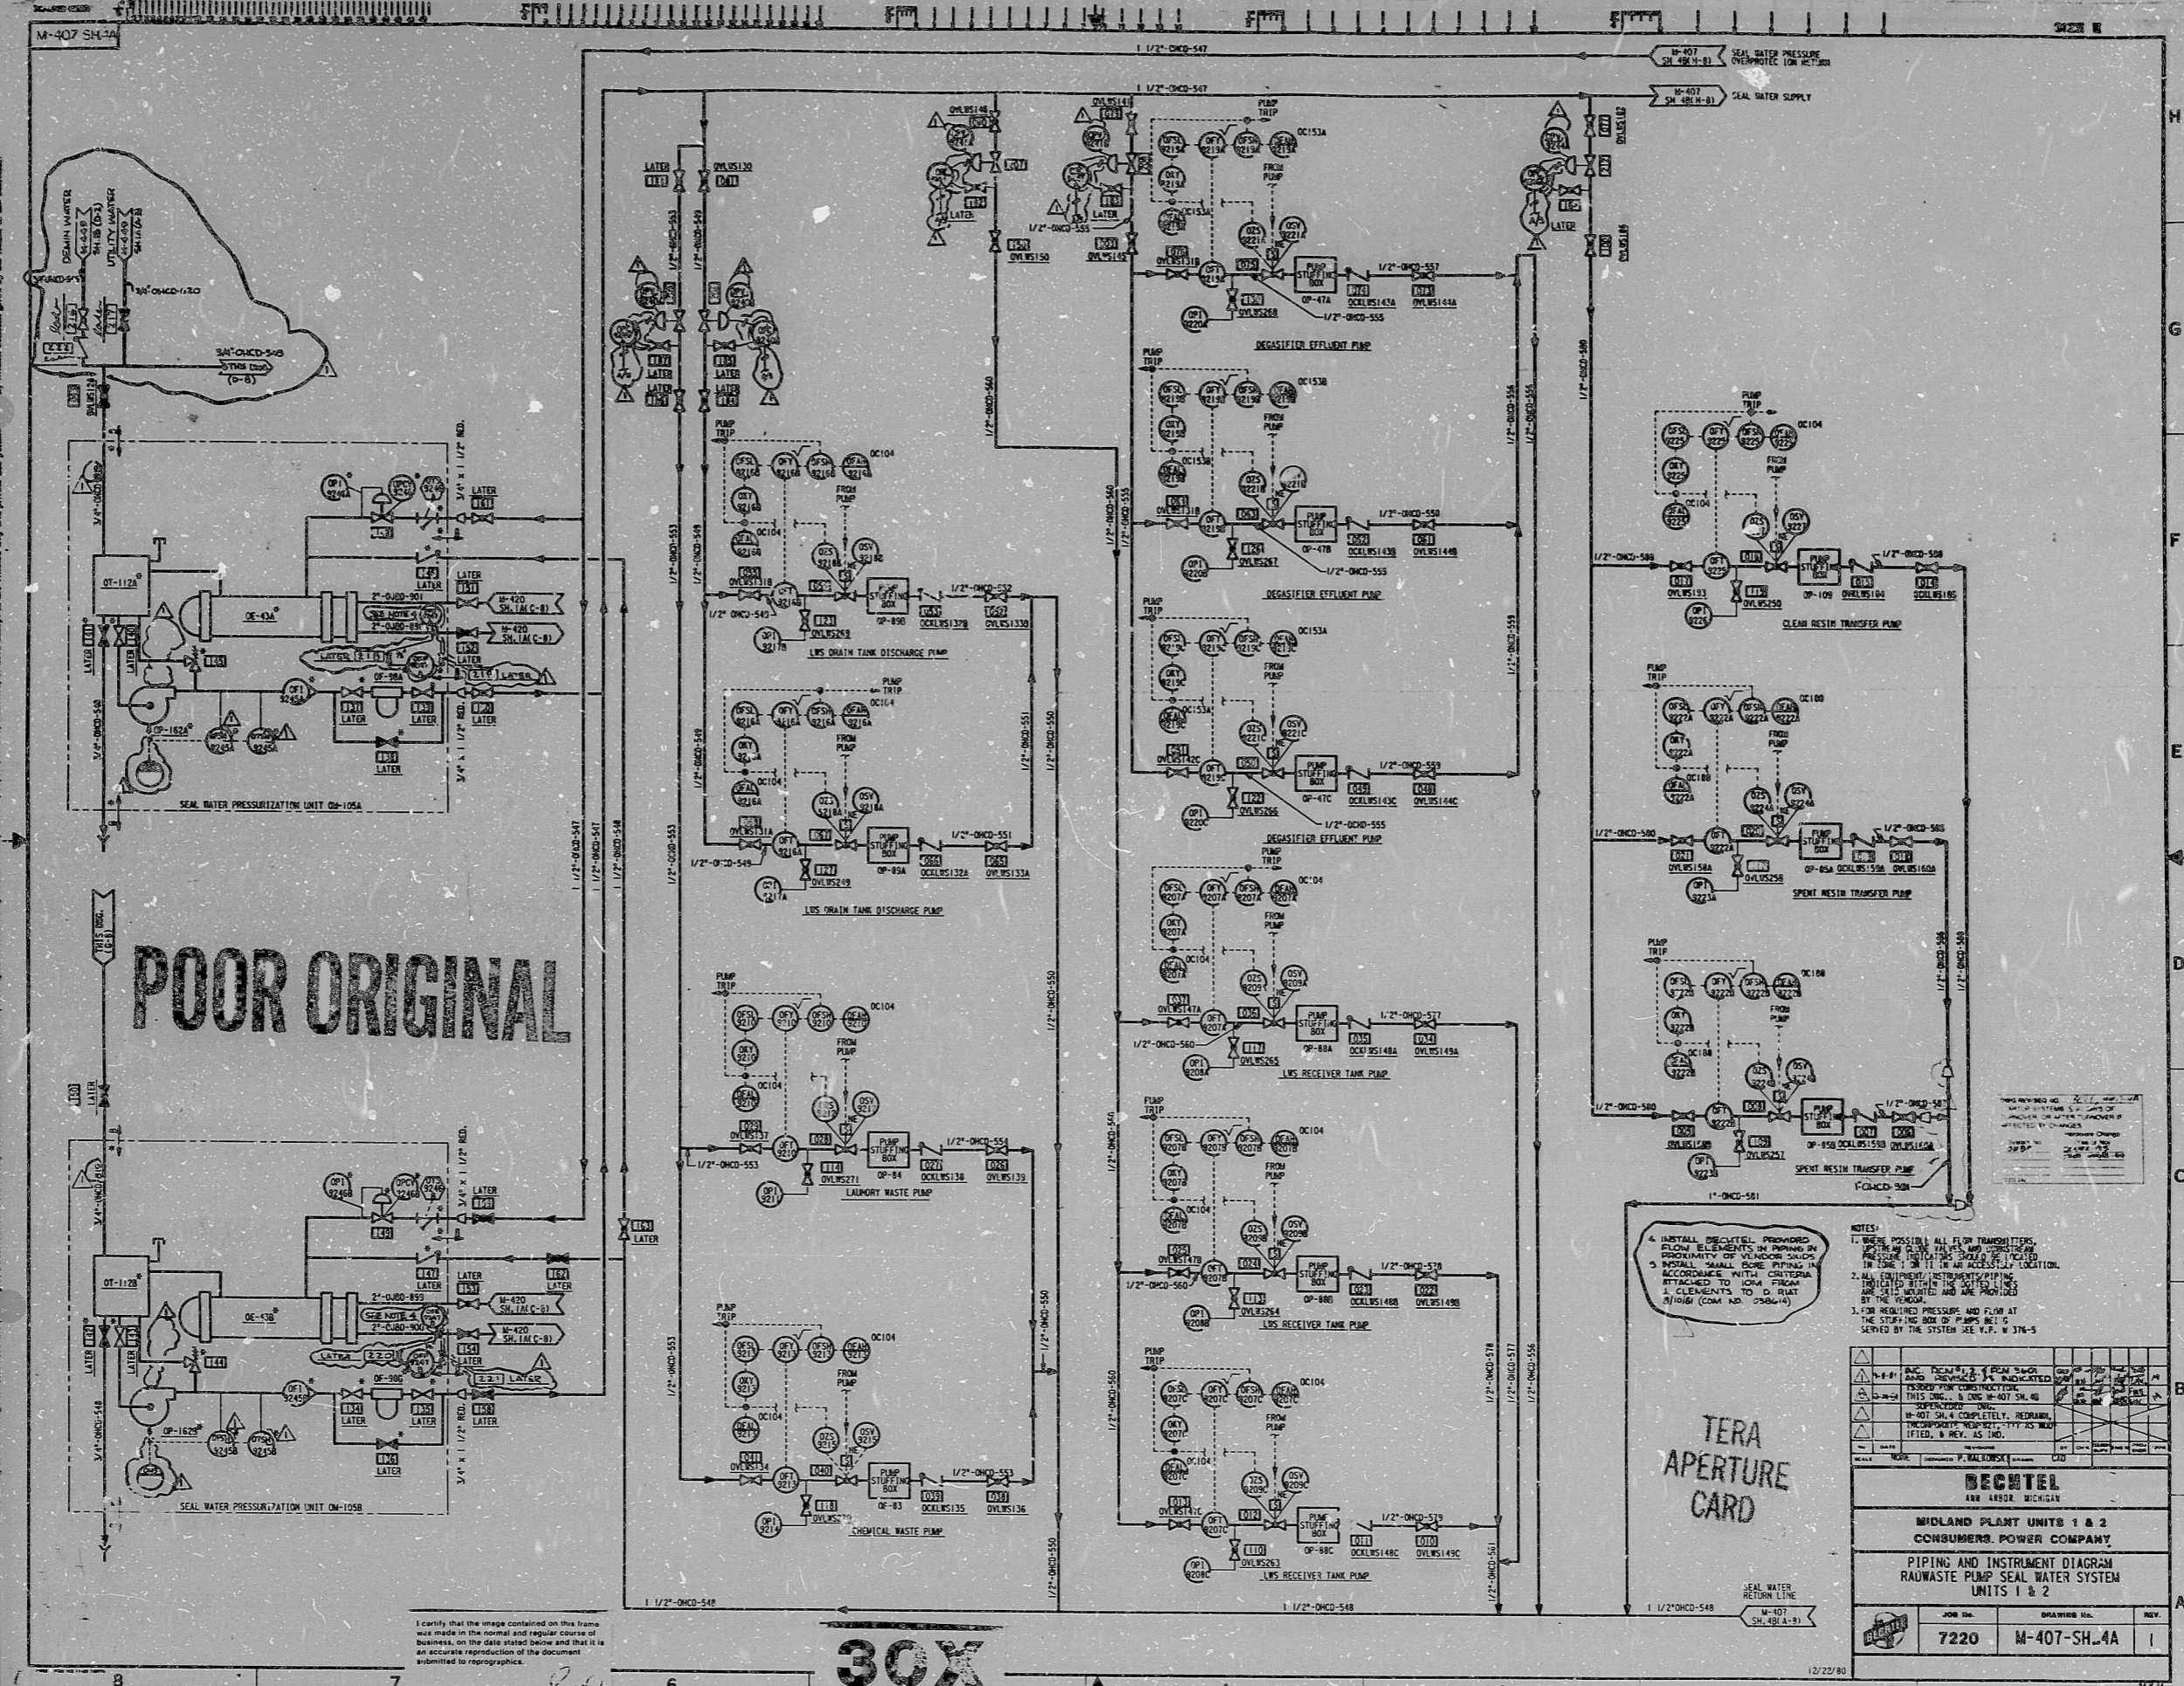

POOR ORIGINAL

TERA APERTURE CARD

- NOTES:
  3. FOR REQUIRED PRESSURE AND FLOW AT THE STOPPING BOX OF PUMPS BEING SERVED BY THE SYSTEM SEE P.P. M-376-5

NO.	DESCRIPTION	DATE	BY	CHKD.
1	ISSUED FOR CONSTRUCTION	12/22/80	P. MALINOWSKI	C.D.
2	REVISION			
<b>MIDLAND PLANT UNITS 1 &amp; 2</b> <b>CONSUMERS POWER COMPANY</b>				
PIPING AND INSTRUMENT DIAGRAM RAW WASTE PUMP SEAL WATER SYSTEM UNITS 1 & 2				
JOB NO.	DRAWING NO.	REV.		
7220	M-407-SH.4A	1		

I certify that the image contained on this frame was made in the normal and regular course of business, on the date stated below and that it is an accurate reproduction of the document submitted to reprographics.

30X

12/22/80

RIDS

8112230114

