
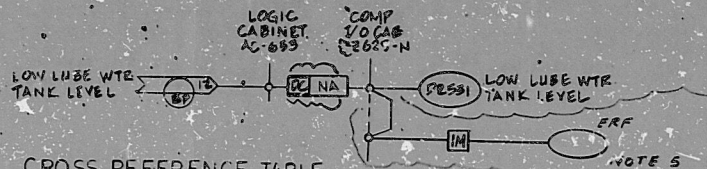


J-09-0 SHT. 17



RCP C-520

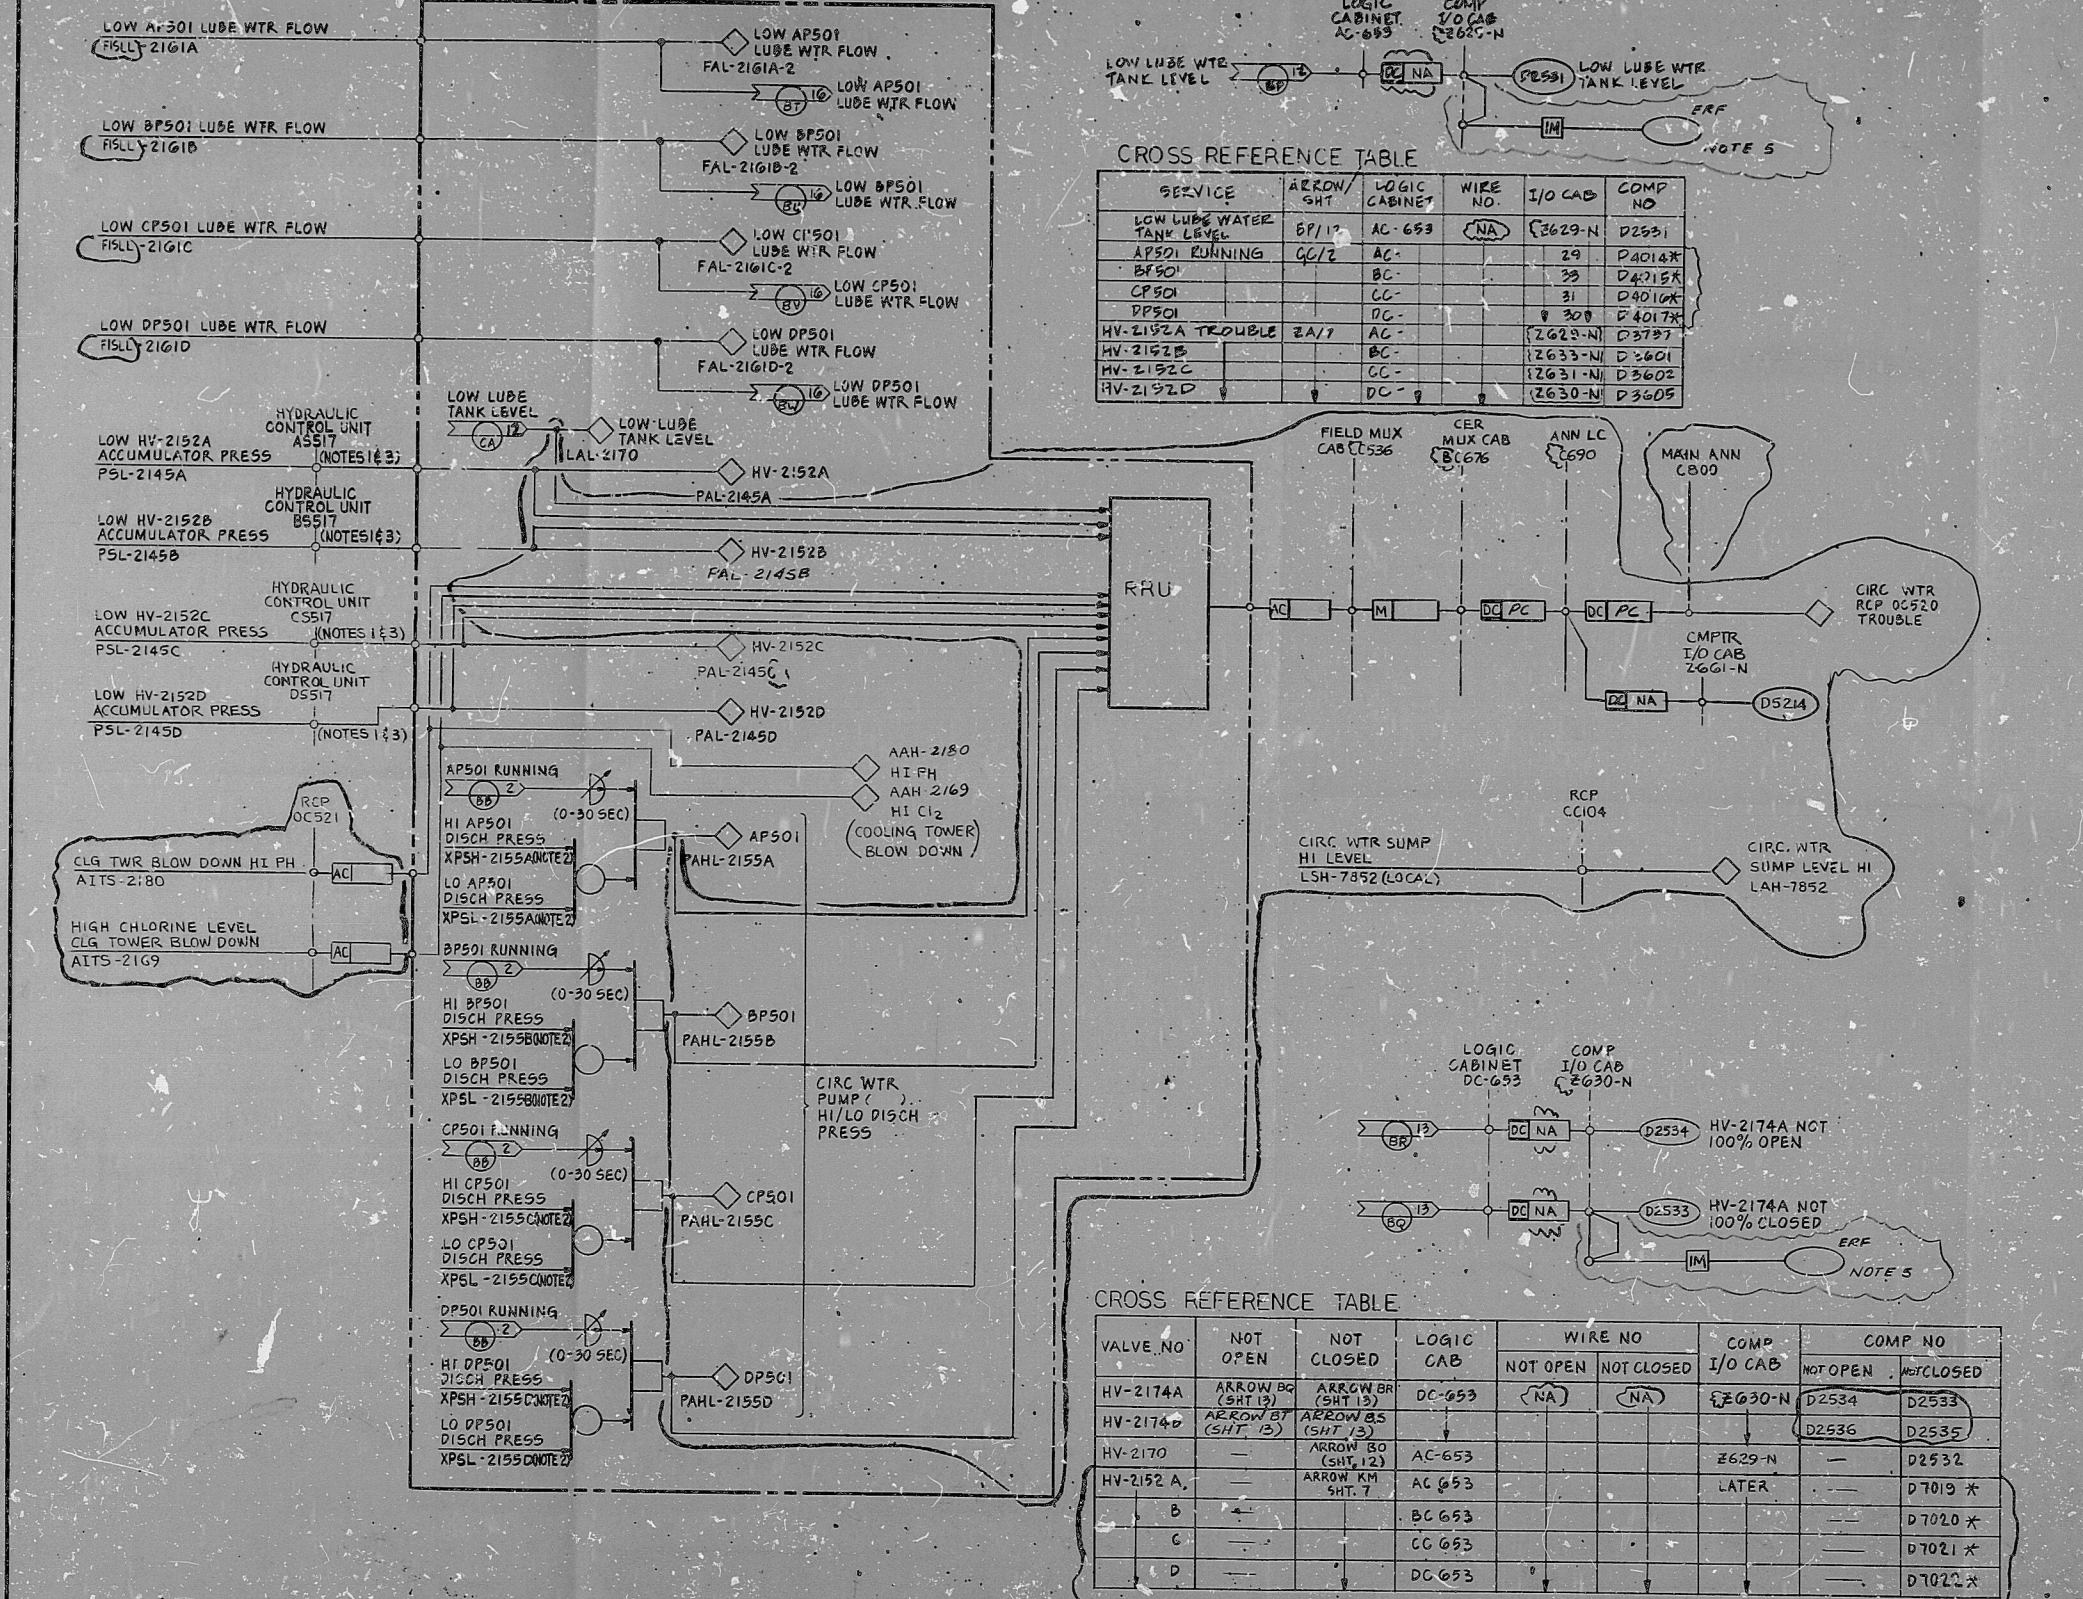

CROSS REFERENCE TABLE

SERVICE	ARROW SHT	LOGIC CABINET	WIRE NO.	I/O CAB	COMP NO
LOW LUBE WATER TANK LEVEL	BF/12	AC-653	NA	#2629-N	D2531
AP501 RUNNING	CC/2	AC-		29	D4014*
BP501		BC-		39	D4015*
CP501		CC-		31	D4016*
DP501		DC-		30	D4017*
HV-2152A TROUBLE	EA/7	AC-		(2629-N)	D3797
HV-2152B		BC-		(2633-N)	D3801
HV-2152C		CC-		(2631-N)	D3602
HV-2152D		DC-		(2630-N)	D3605

- NOTES:
1. HYDRAULIC CONTROL UNITS AS517, BS517, CS517 & DS517 ARE WIRED AND FURNISHED BY CIRC WATER PUMP DISCHARGE VALVE SUPPLIER. FOR INTERNAL WIRINGS SEE VENDOR PRINT 10855-MIO2-21.
 2. CONTACT OPENS ON CONDITION STATED.
 3. 120VAC POWER SUPPLY IS FROM THE ASSOCIATED HYDRAULIC CONTROL UNIT.
 4. DELETED
 5. ERF COMPUTER INPUT APPLICABLE TO POINTS AS INDICATED BY (*) IN REFERENCE TABLE.

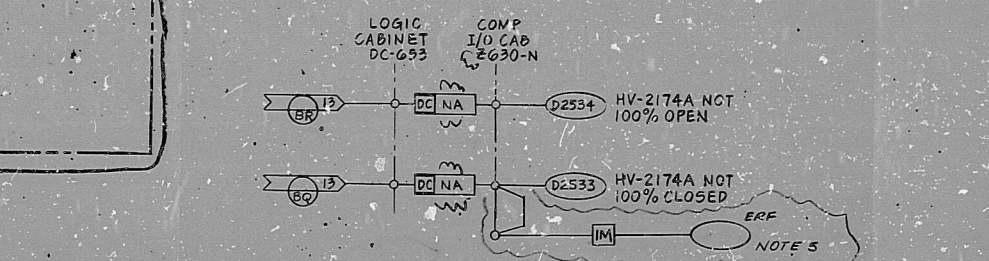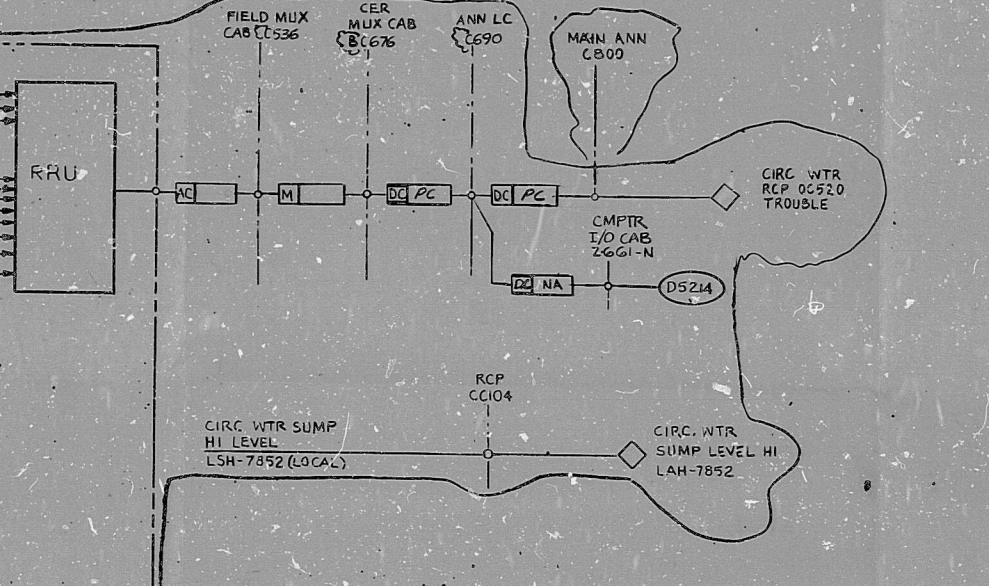

CROSS REFERENCE TABLE

VALVE NO	NOT OPEN		LOGIC CAB	WIRE NO		COMP I/O CAB	COMP NO	
	ARROW BC (SHT. 13)	ARROW BR (SHT. 13)		NOT OPEN	NOT CLOSED		NOT OPEN	NOT CLOSED
HV-2174A	ARROW BC (SHT. 13)	ARROW BR (SHT. 13)	DC-653	NA	NA	#2630-N	D2534	D2533
HV-2174B	ARROW BY (SHT. 13)	ARROW BS (SHT. 13)					D2536	D2535
HV-2170	---	ARROW BO (SHT. 12)	AC-653			#2629-N		D2532
HV-2152 A	---	ARROW KM (SHT. 7)	AC-653			LATER		D7019 *
B	---		BC-653					D7020 *
C	---		CC-653					D7021 *
D	---		DC-653					D7022 *

PRC APERTURE GARD

5-31-77	ISSUED FOR CONSTRUCTION	S I G N E D							

SCALE NONE

BECHTEL
SAN FRANCISCO

PUBLIC SERVICE ELECTRIC AND GAS COMPANY
HOPE CREEK GENERATING STATION

LOGIC DIAGRAM
CIRCULATING WATER SYSTEM
ALARMS & COMPUTER INPUTS

JOB No.	DRAWING No.	REV.
10855	J-09-0 SHT. 17	5

This drawing and the design it covers are the property of BECHTEL. They are hereby loaned and on the borrower's express agreement shall not be reproduced, copied, traced, exhibited, nor used except in the limited way and private use permitted by any written consent given by the lender to the borrower.

22
11
11
58
11
8.5
11
17
22

22
11
11
58
11
8.5
11
17
22

S/U-DA, DB

RIDS

8307280040

