



J-09-0 SHT. 18

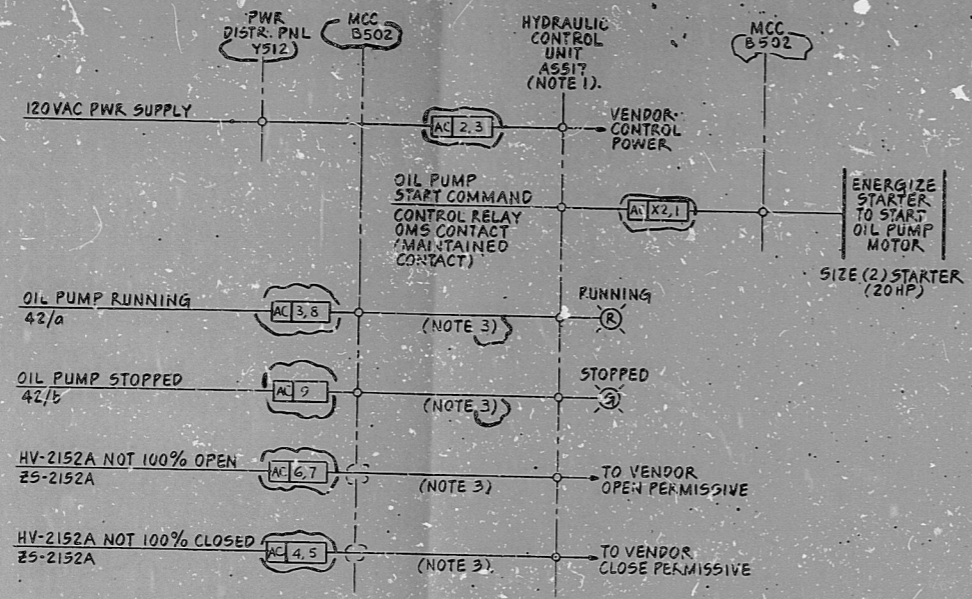

PMP DISCH V HV-2152A HYDR CONT UNIT OIL PMP

CROSS REFERENCE TABLE

DISCH V NO	HYDRAULIC CONTROL UNIT	MCC	POWER DISTR PNL
HV-2152A	A5517	B502023	Y512
HV-2152 B	B5517	B502062	
HV-2152 C	C5517	B503033	
HV-2152 D	D5517	B504034	

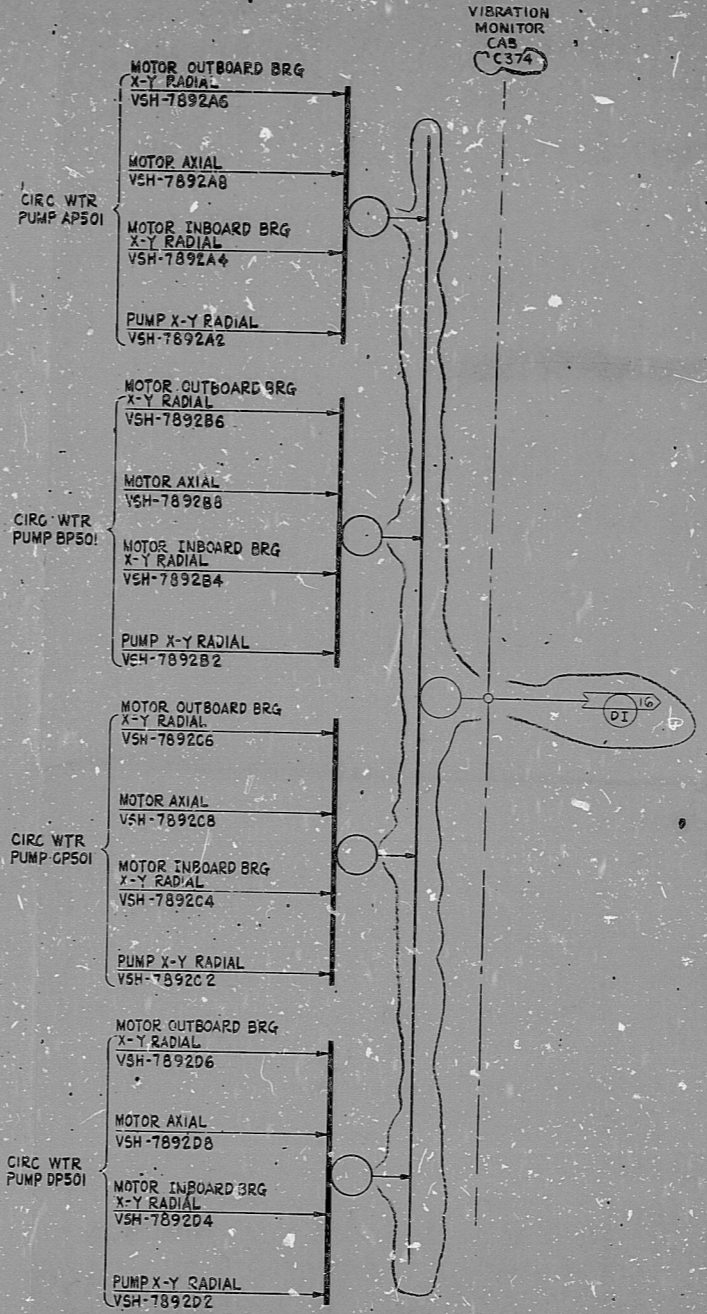

- NOTES:
1. HYDRAULIC CONTROL UNITS A5517, B5517, C5517 & D5517 ARE WIRED AND FURNISHED BY CIRC WATER PUMP DISCH VALVE SUPPLIER. FOR INTERNAL WIRINGS SEE VENDOR PRINT 10855-M102-21.
 2. 120VAC POWER SUPPLY SHALL BE FROM OIL PUMP MOTOR STARTER.
 3. 120VAC POWER SUPPLY SHALL BE FROM HYDRAULIC CONTROL UNIT.

PROC APERTURE CARD

NO.	DATE	REVISIONS	BY	CHECK	DESIGN	SCALE	DRWG	APPD
SCALE NONE								
BECHTEL SAN FRANCISCO								
PUBLIC SERVICE ELECTRIC AND GAS COMPANY HOPE CREEK GENERATING STATION								
LOGIC DIAGRAM CIRCULATING WATER SYSTEM								
PMP DISCH V HYDR CONT UNIT OIL PMP/VIBRATION ALARMS								
JOB No.	DRAWING No.	REV.						
10855	J-09-0 SHT 18	2						

S/U-DA

This drawing and the design it covers are the property of BECHTEL. They are hereby loaned to the borrower's express agreement that they will not be reproduced, copied, loaned, exhibited, nor used except in the limited way and private use permitted by any written consent given by the lender to the borrower.

RIDS

8307280041

