

17


11

8.5

8.5

11

17

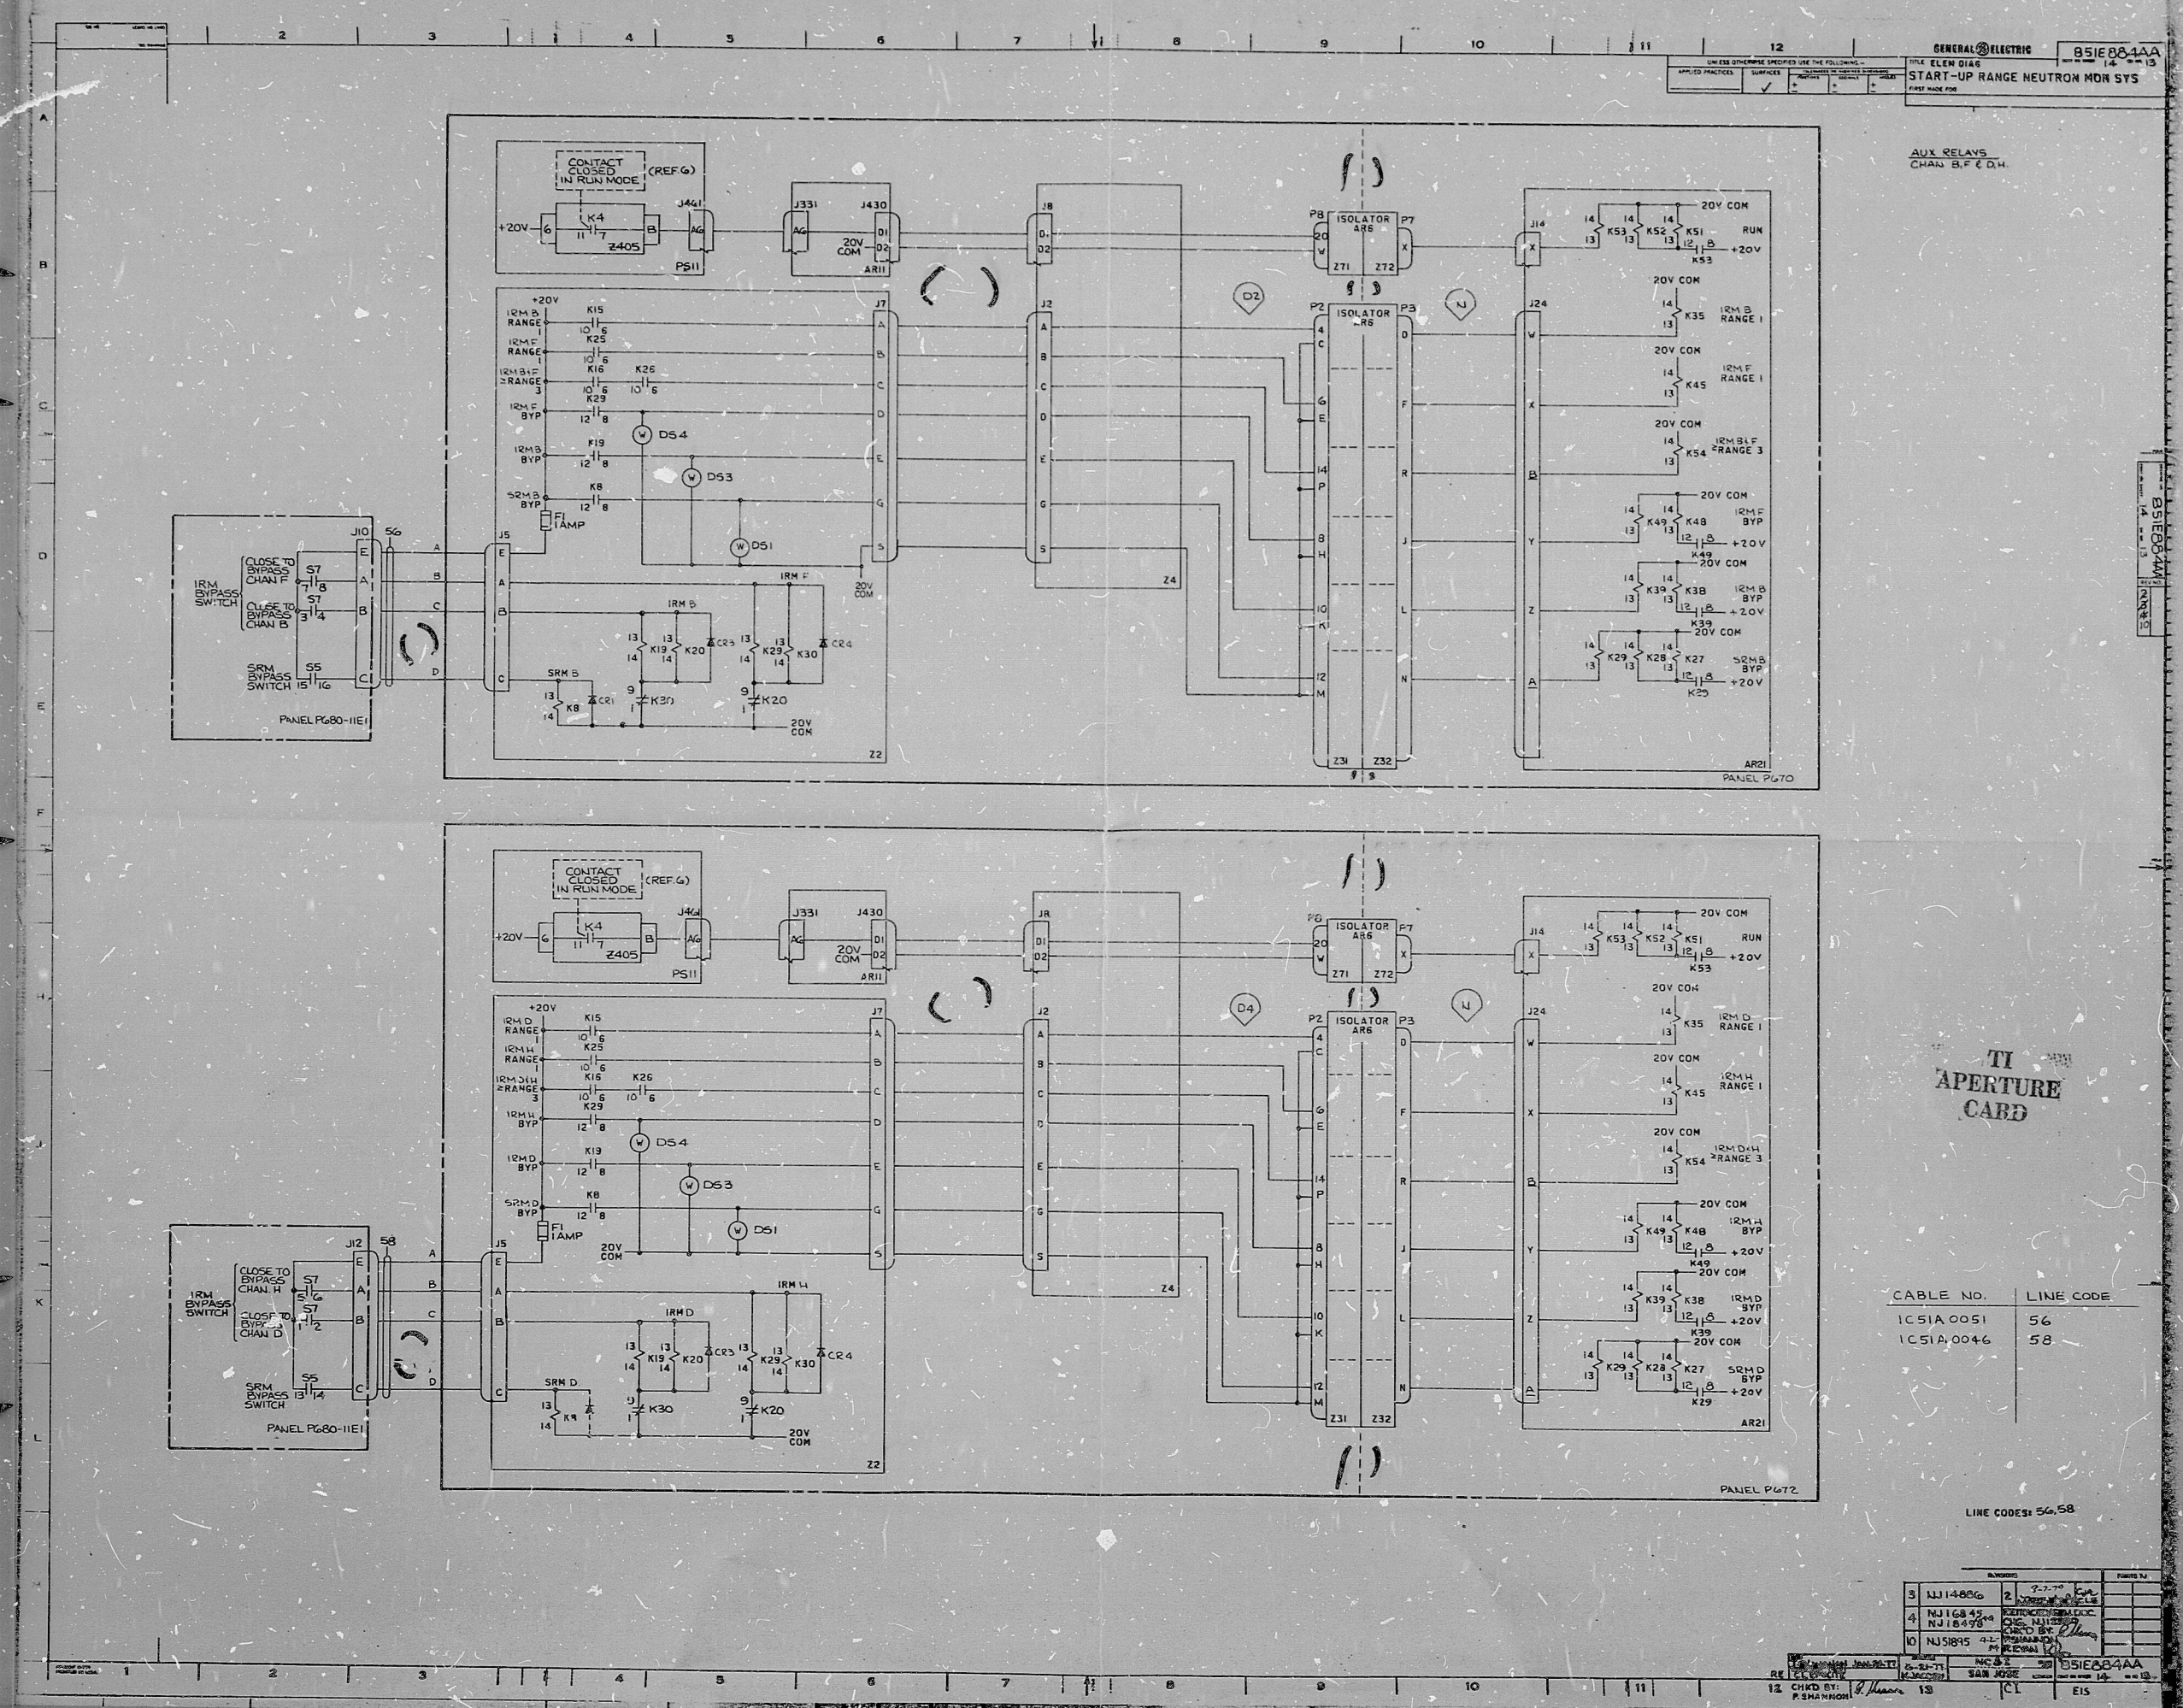

GENERAL ELECTRIC 851E804AA  
 ELEM DIAG  
 START-UP RANGE NEUTRON MON SYS  
 PART NAME FOR

AUX RELAYS  
 CHAN. B, F & D, H.

TI  
 APERTURE  
 CARD

CABLE NO.	LINE CODE
1CSIA.0051	56
1CSIA.0046	58

LINE CODES: 56, 58

REV.	DATE	BY	CHKD BY	REVISION

12 CHKD BY: P. SHANNON  
 13  
 14  
 15



8412190216

PDR RIDS

