


17" 8.5" 11" 17"


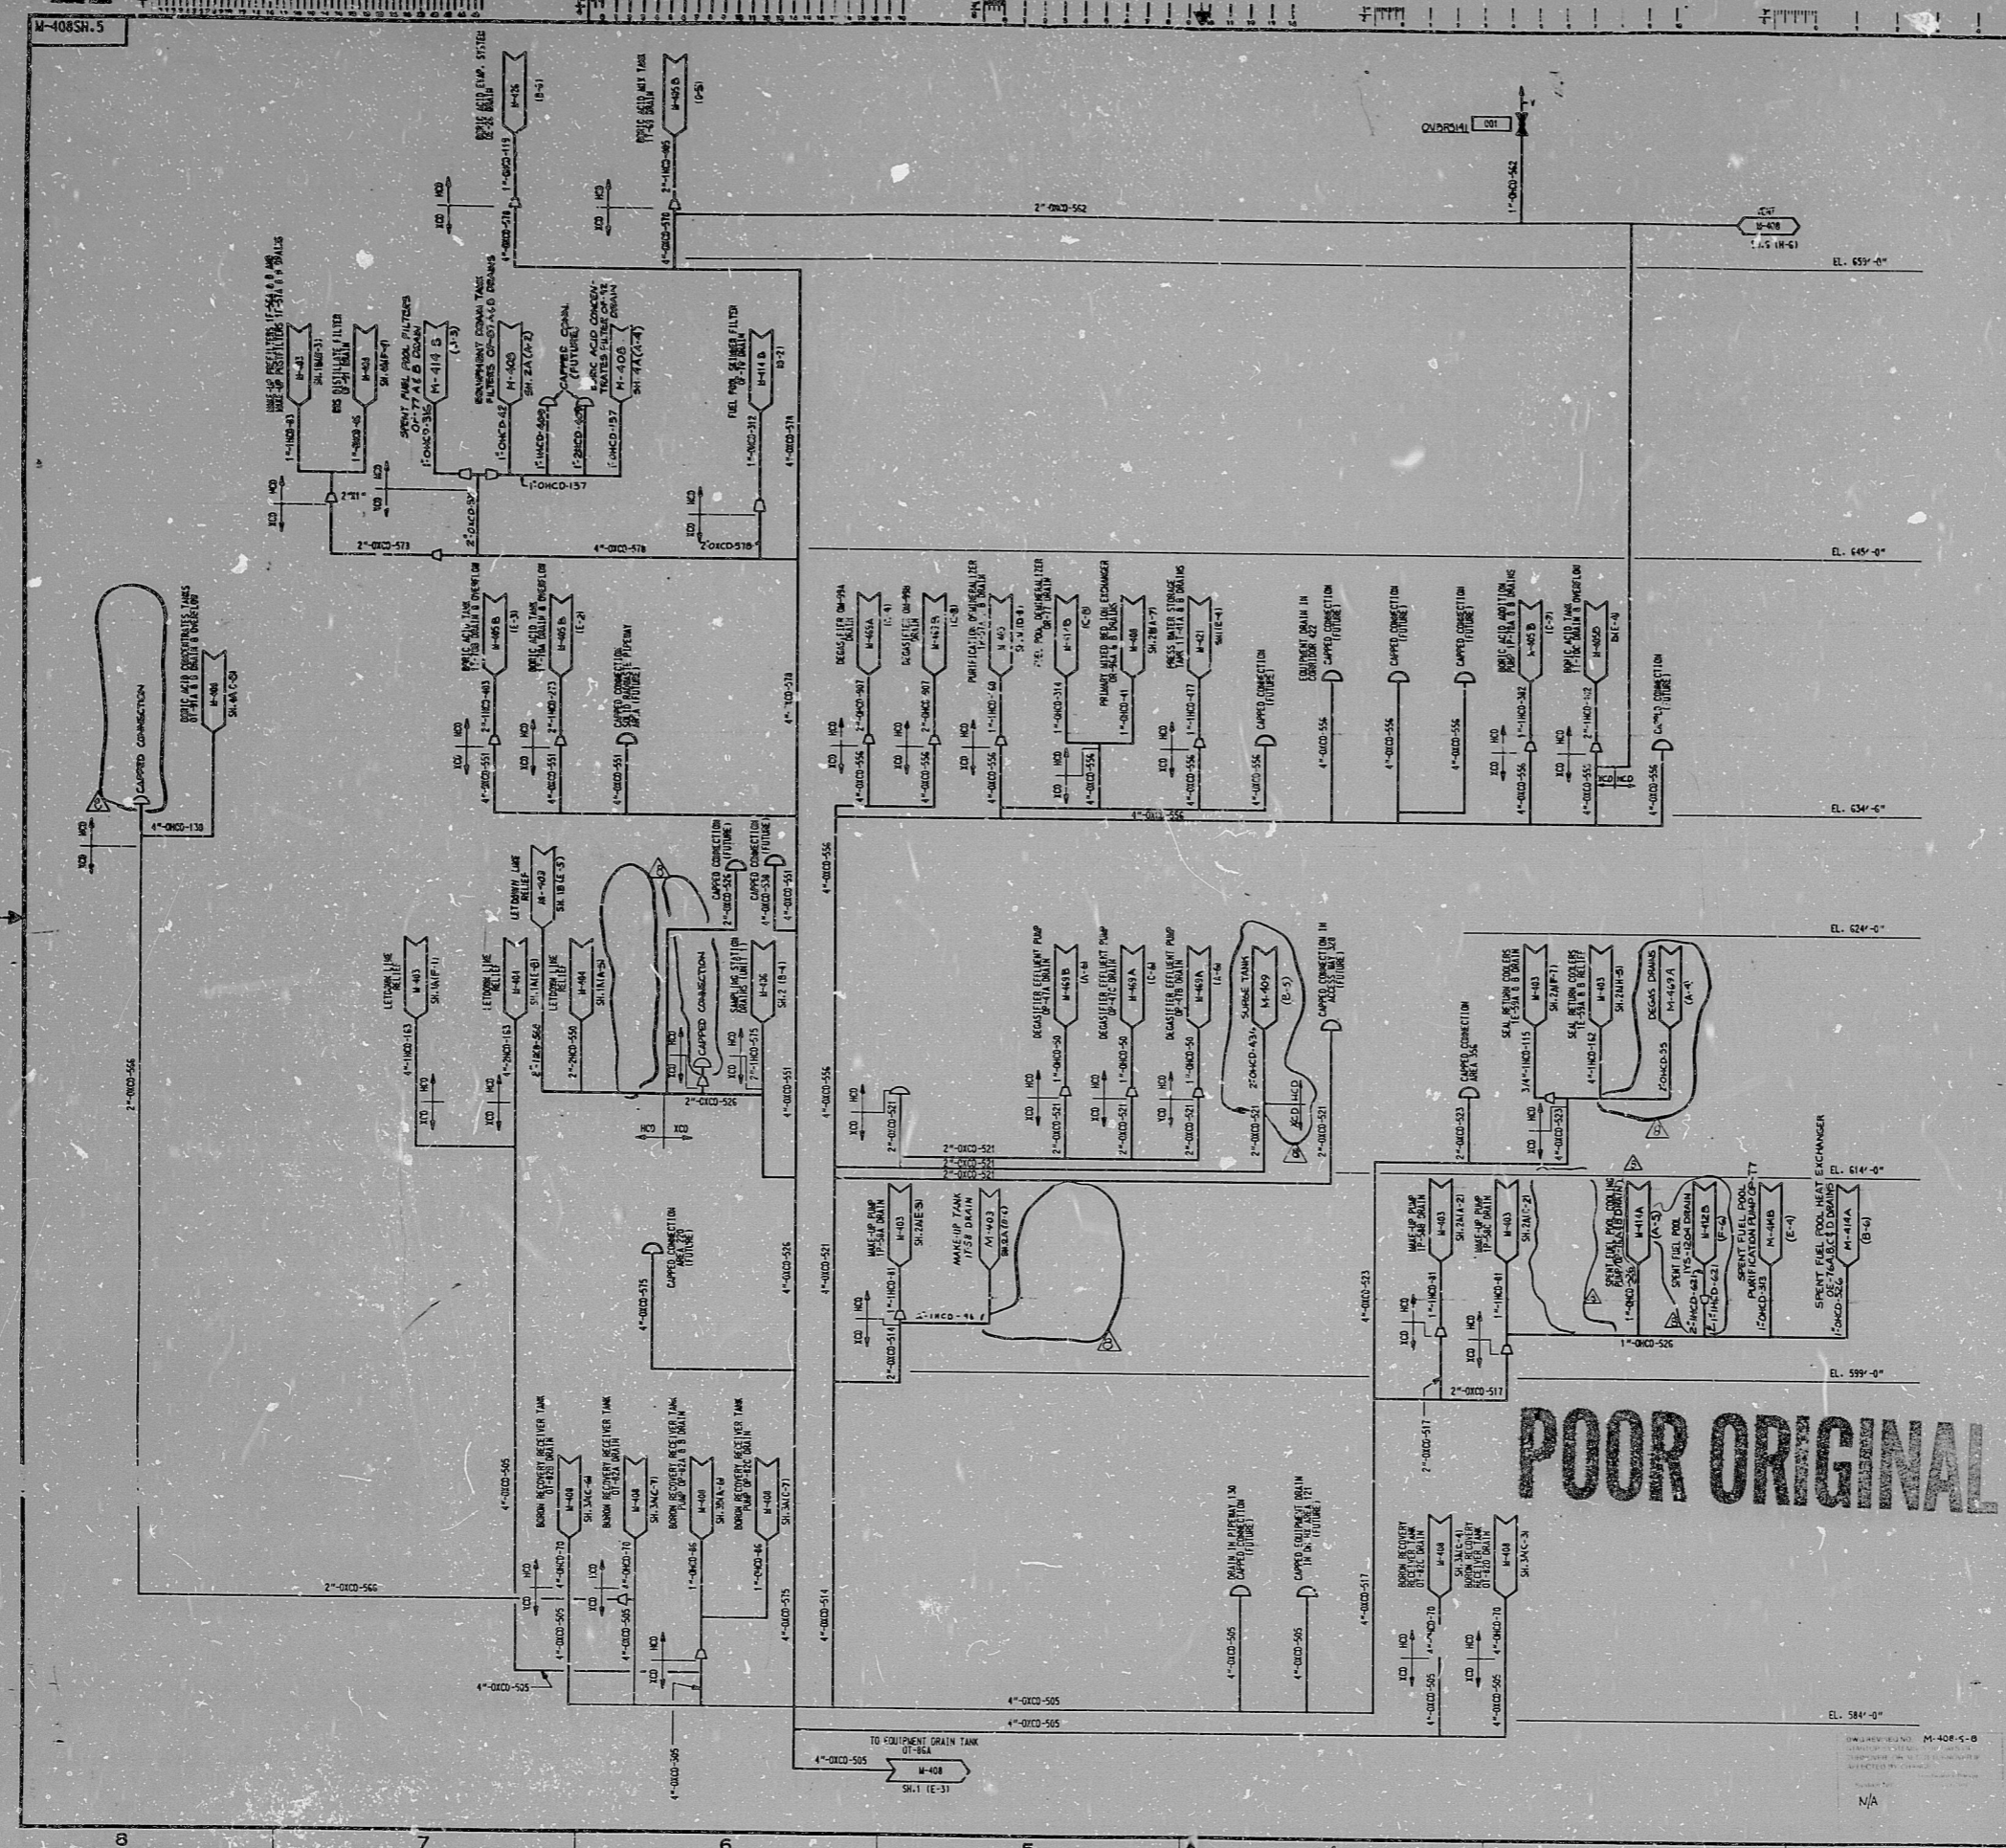

**30X**

NOTE:  
1. THE ORDER OF PIPING CONNECTIONS TO EMBEDDED PIPING IS SHOWN AS A SCHEMATIC REPRESENTATION ONLY. ACTUAL CONSTRUCTION ORDER OF PIPING CONNECTIONS IS NOT CRITICAL.

**TERA APERTURE CARD**

**POOR ORIGINAL**

REVISED AS INDICATED	DATE	BY
INCORPORATE P.C.R. M-2166		
ADD TIME FOR P.C.R. M-2166		
REVISED AS INDICATED AND INCORPORATED A.C.A. 2-11		
REVISED AS INDICATED		
REVISIONS FOUR SHEETS		
DATE		
<b>BECHTEL</b>		
ANN ARBOR, MICHIGAN		
MIDLAND PLANT UNITS 1 & 2		
CONSUMERS POWER COMPANY		
PIPING AND INSTRUMENT DIAGRAM		
BORON RECOVERY		
UNITS 1 & 2		
JOB No.	DRAWING No.	REV.
7220	M-408 SH.5	8

17" 8.5" 11" 17"

RIDS

8112230133

