


17" 11" 8.5" 8.5" 17"


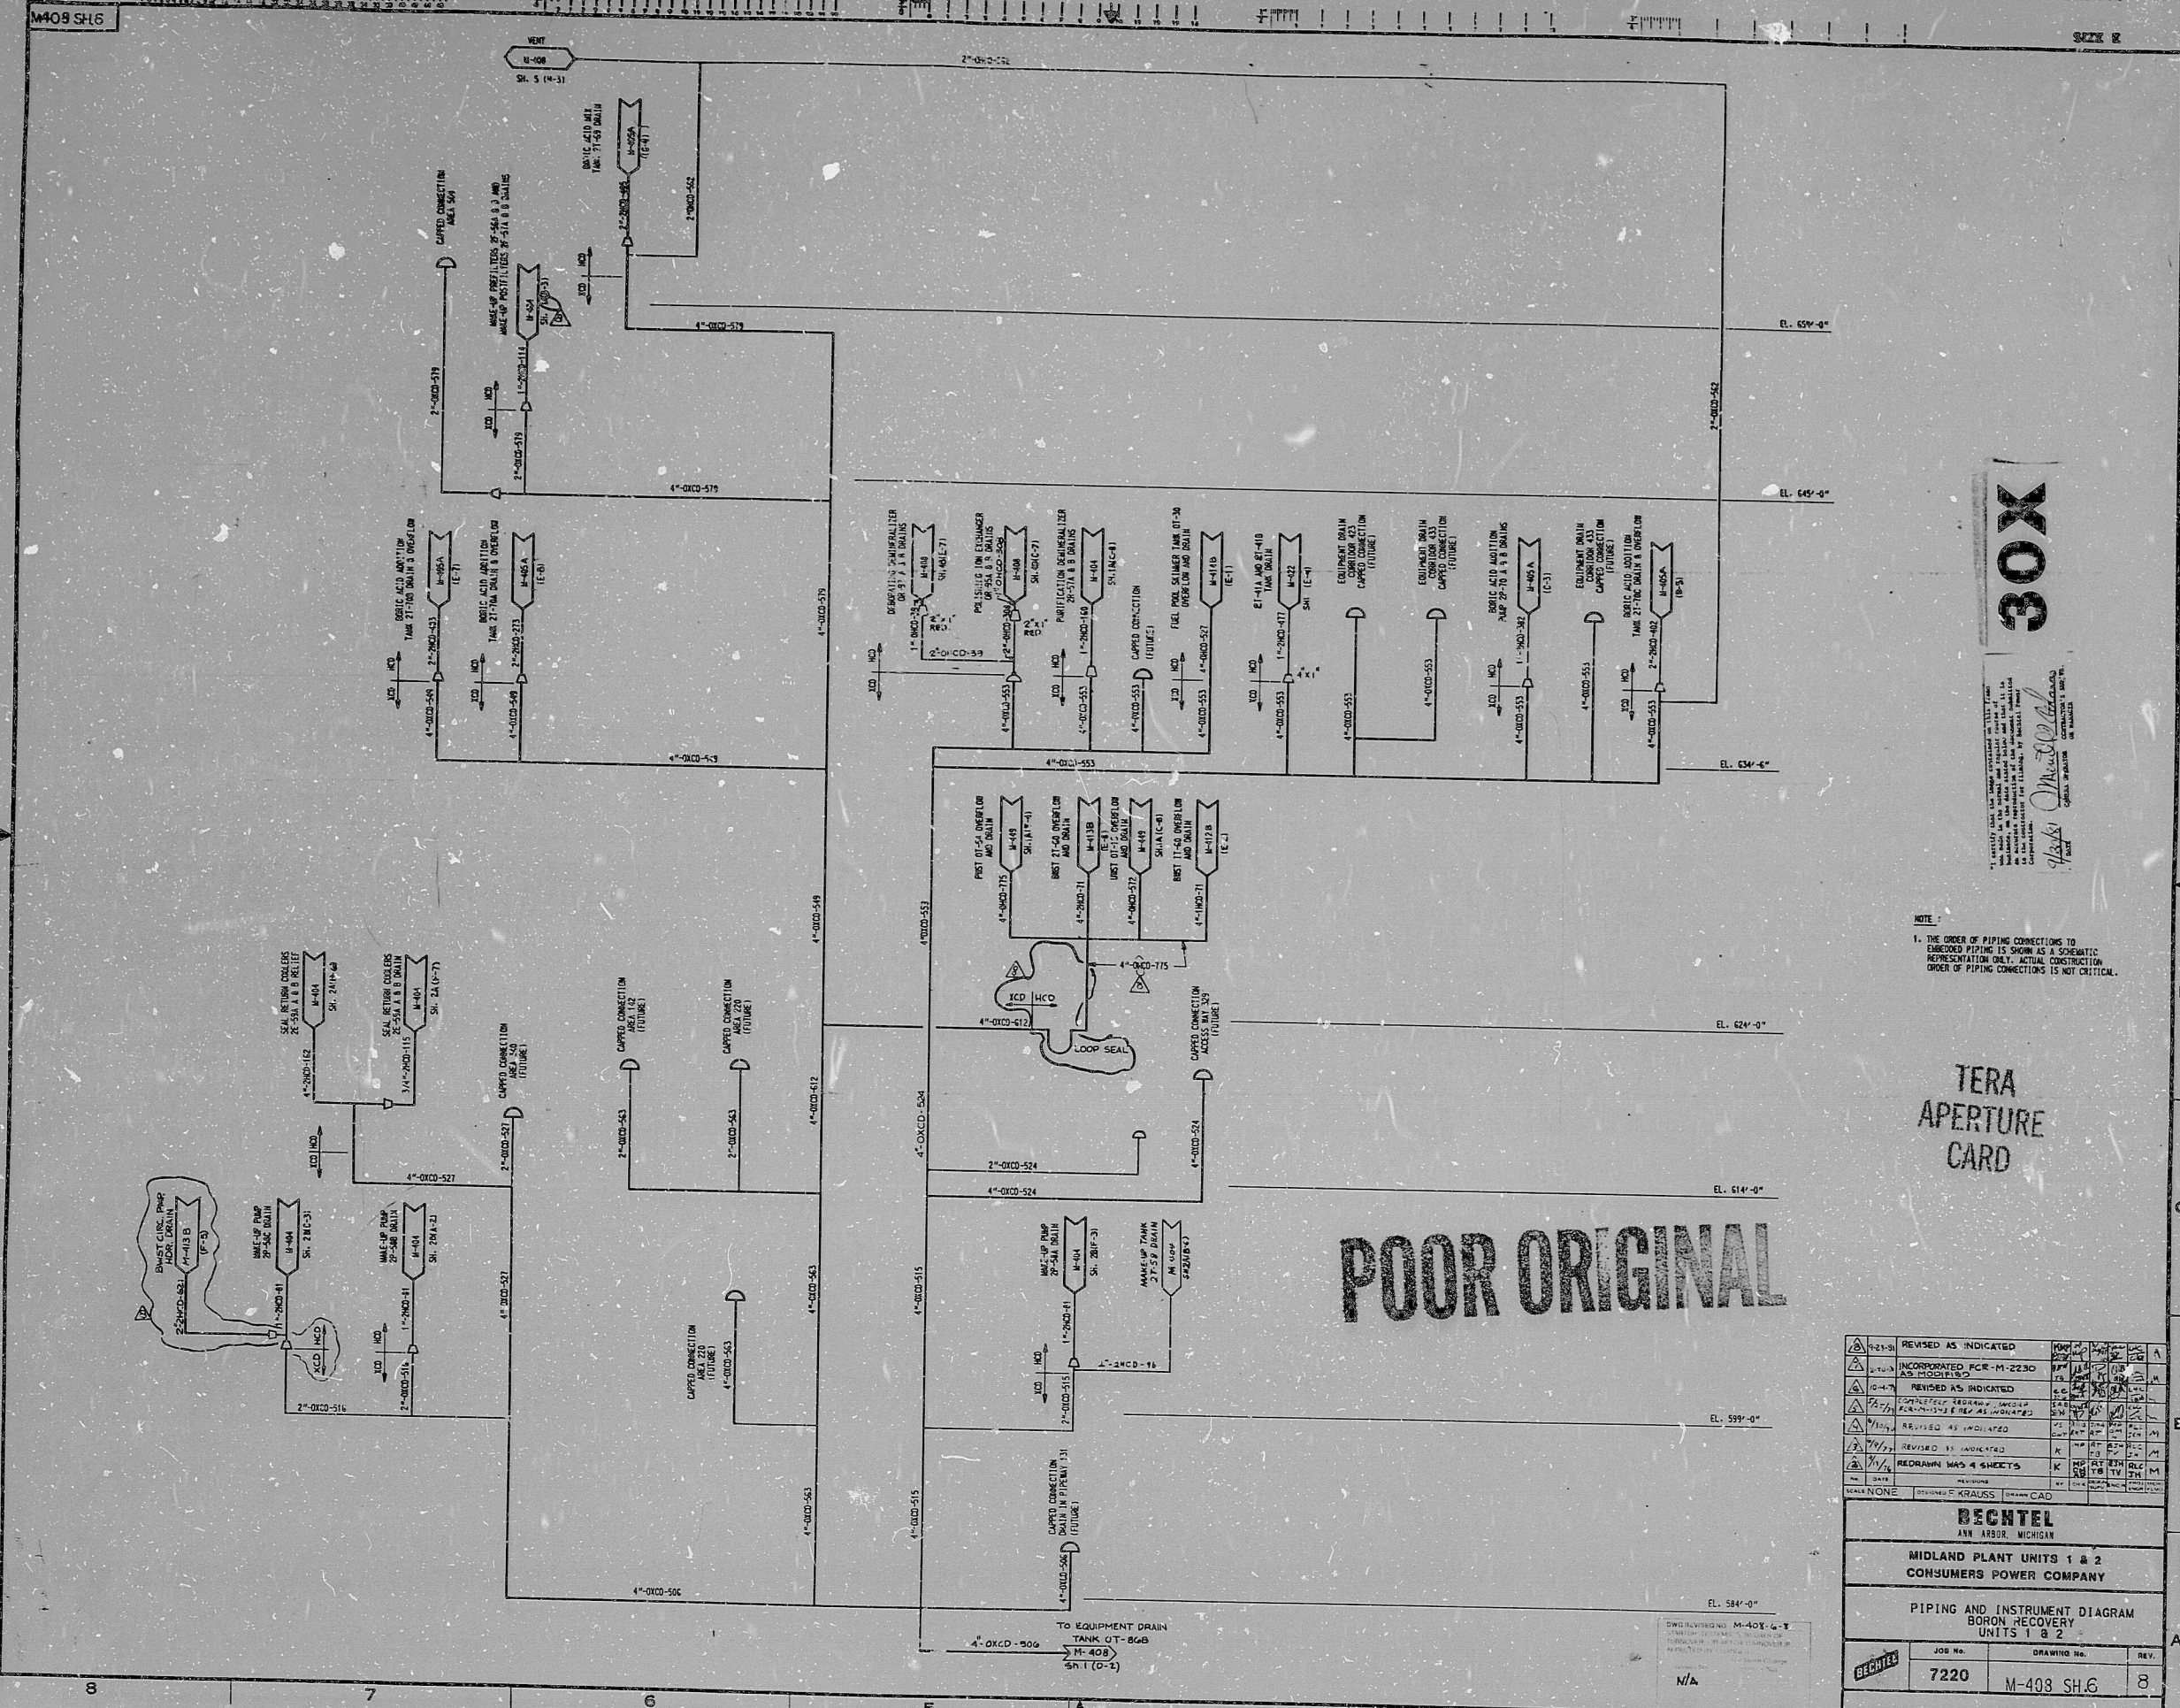

POOR ORIGINAL

30X

NOTE:
1. THE ORDER OF PIPING CONNECTIONS TO
EQUIPPED PIPING IS SHOWN AS A SCHEMATIC
REPRESENTATION ONLY. ACTUAL CONSTRUCTION
ORDER OF PIPING CONNECTIONS IS NOT CRITICAL.

TERA
APERTURE
CARD

BECHTEL
AMT ARBOR MICHIGAN

MIDLAND PLANT UNITS 1 & 2
CONSUMERS POWER COMPANY

PIPING AND INSTRUMENT DIAGRAM
BORON RECOVERY
UNITS 1 & 2

JOB No.	DRAWING No.	REV.
7220	M-408 SH.6	8

RIDS

8112230135

