


J-25-0 SHT. 5

This drawing and the design it covers are the property of BECHTEL. They are hereby loaned and on the borrower's express agreement that they will not be reproduced, copied, loaned, exhibited, nor used except in the limited way and private use permitted by any written consent given by the lender to the borrower.

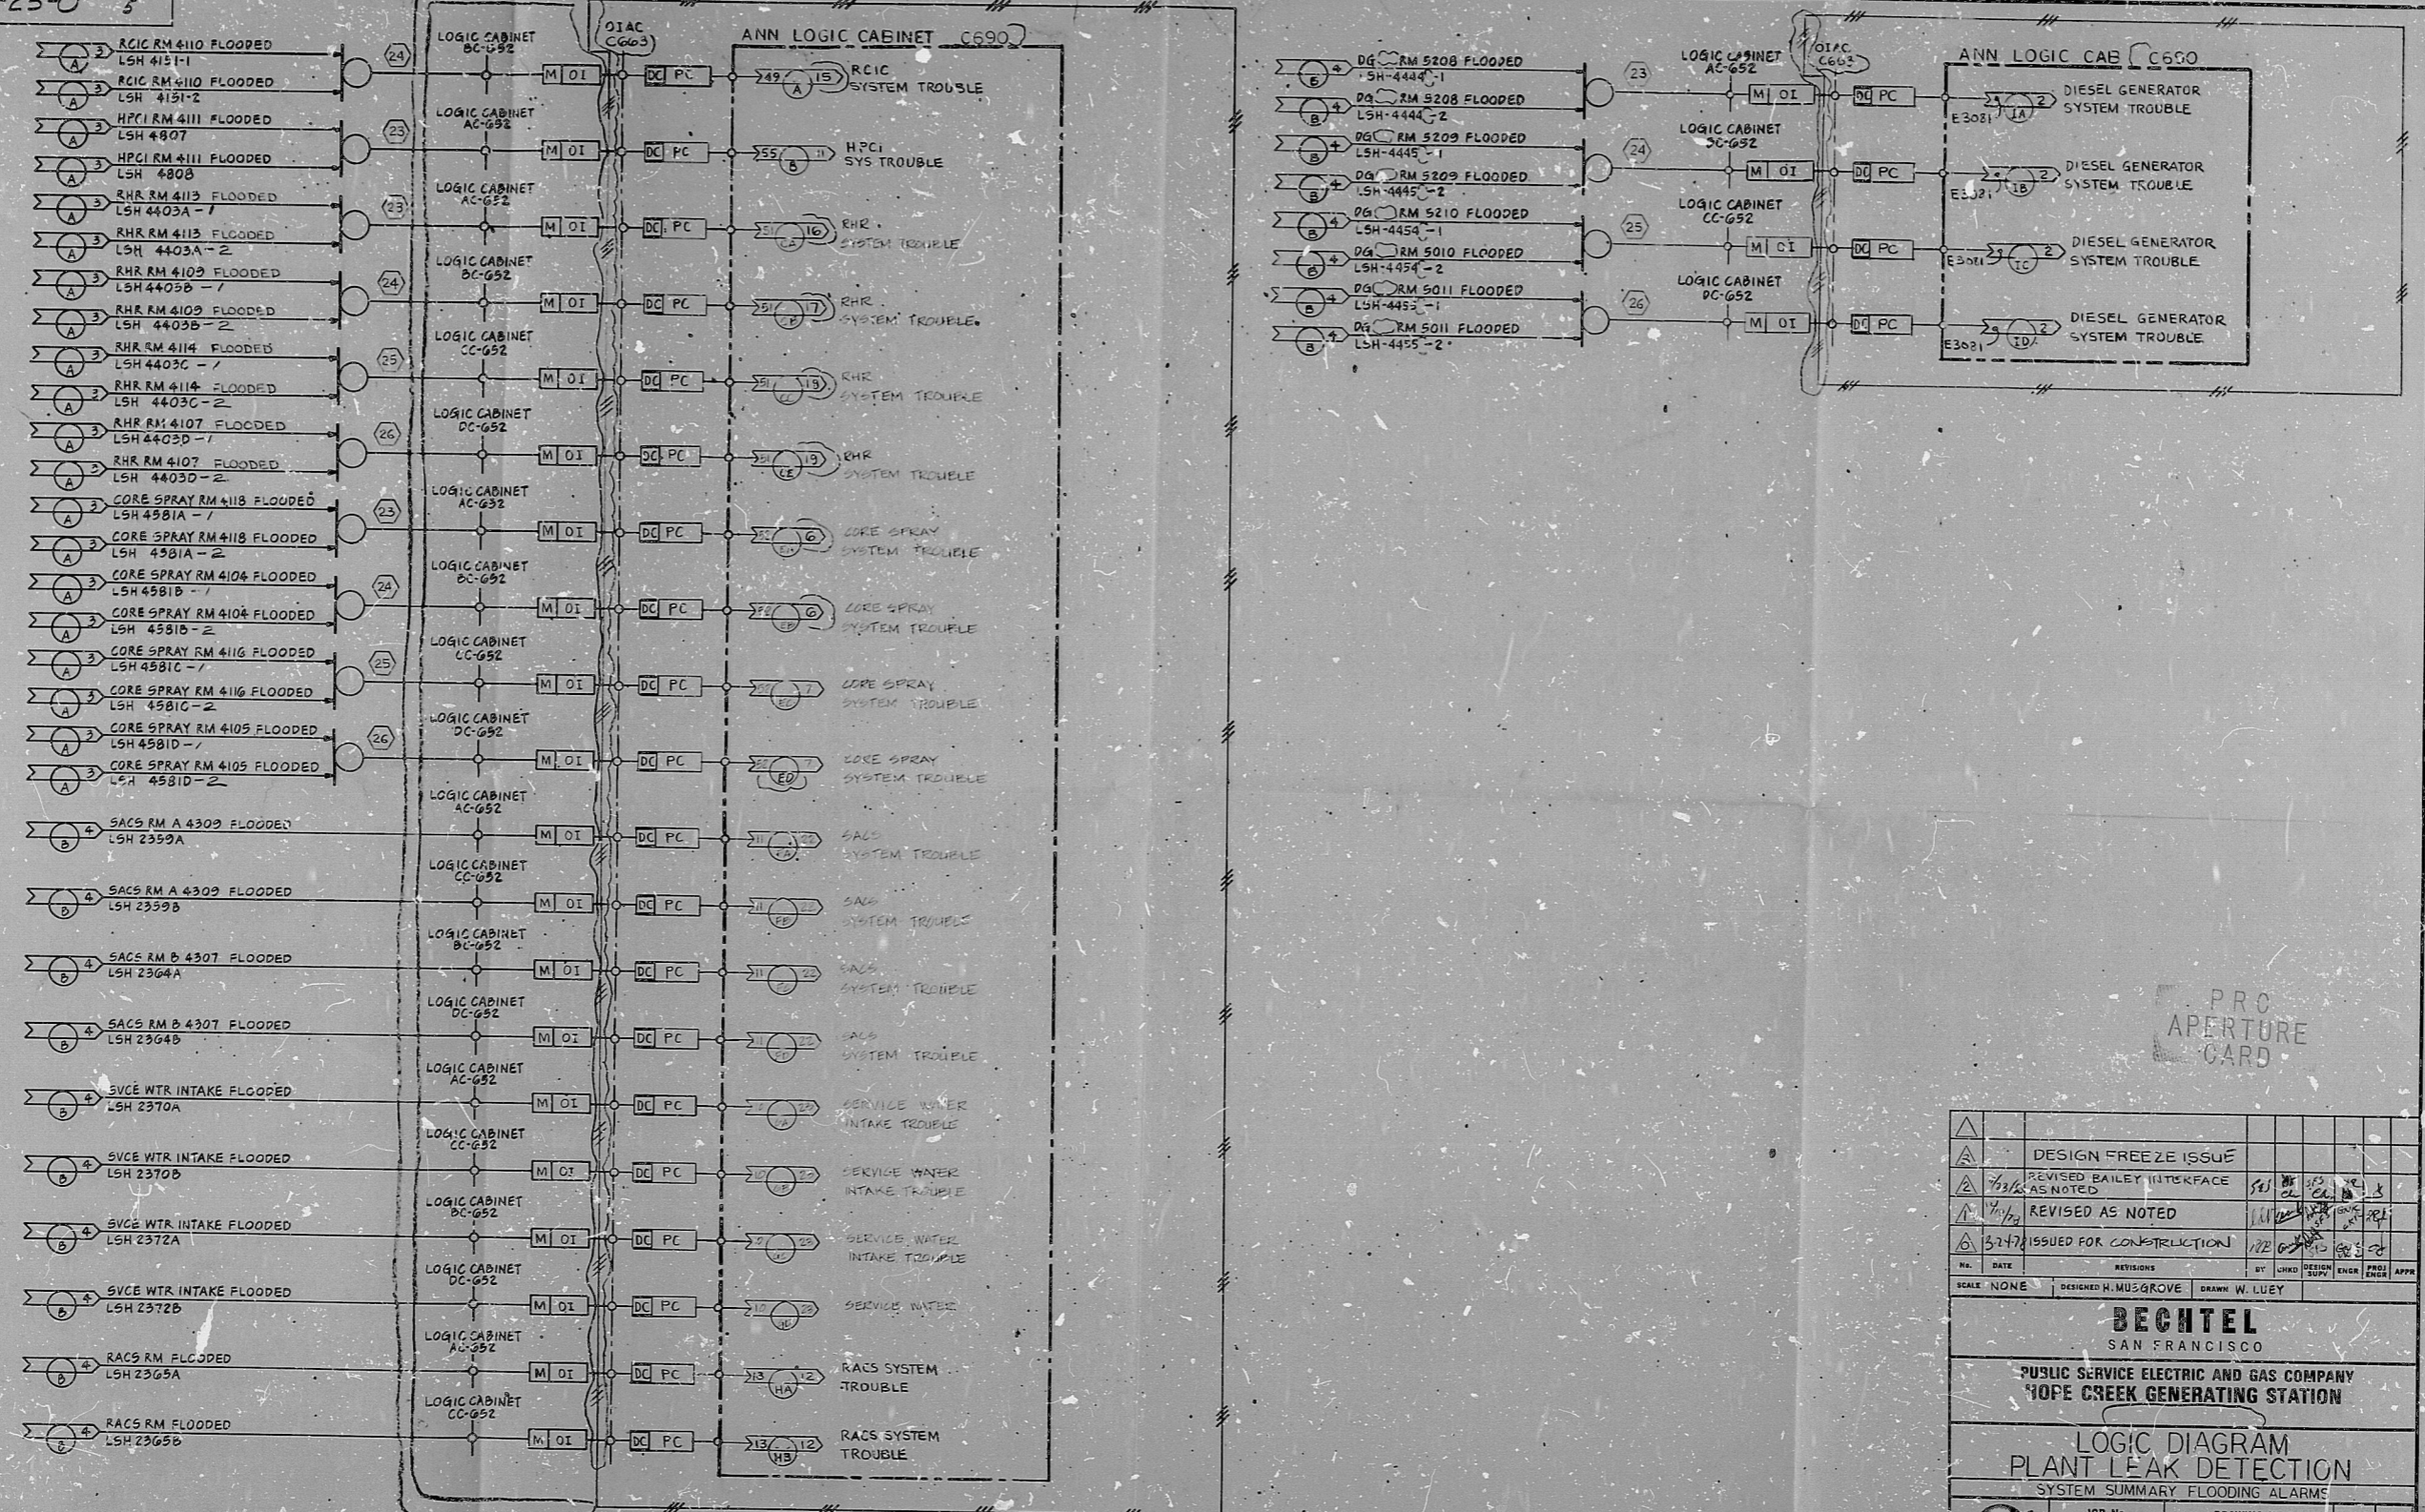

SYSTEM SUMMARY FLOODING ALARMS

PRO APERTURE CARD

△	DESIGN FREEZE ISSUE				
△	REVISED BAILEY INTERFACE AS NOTED	5/1	5/1	5/1	5/1
△	REVISED AS NOTED	1/1	1/1	1/1	1/1
△	ISSUED FOR CONSTRUCTION	1/22	1/22	1/22	1/22

BECHTEL SAN FRANCISCO					
PUBLIC SERVICE ELECTRIC AND GAS COMPANY HOPE CREEK GENERATING STATION					
LOGIC DIAGRAM PLANT LEAK DETECTION SYSTEM SUMMARY FLOODING ALARMS					
JOB No.	10855	DRAWING No.	J-25-0	SHT.	5
REV.	3	REV.	Q		

5/U-SK

77.34 "D" SIZE

RIDS

8307280078

