


[illegible]

SOLID CHECK		DRAWING APPROVALS		DATE	NO. 10191	1012
8904170190		8904170190				

PDR RIDS

8904170190

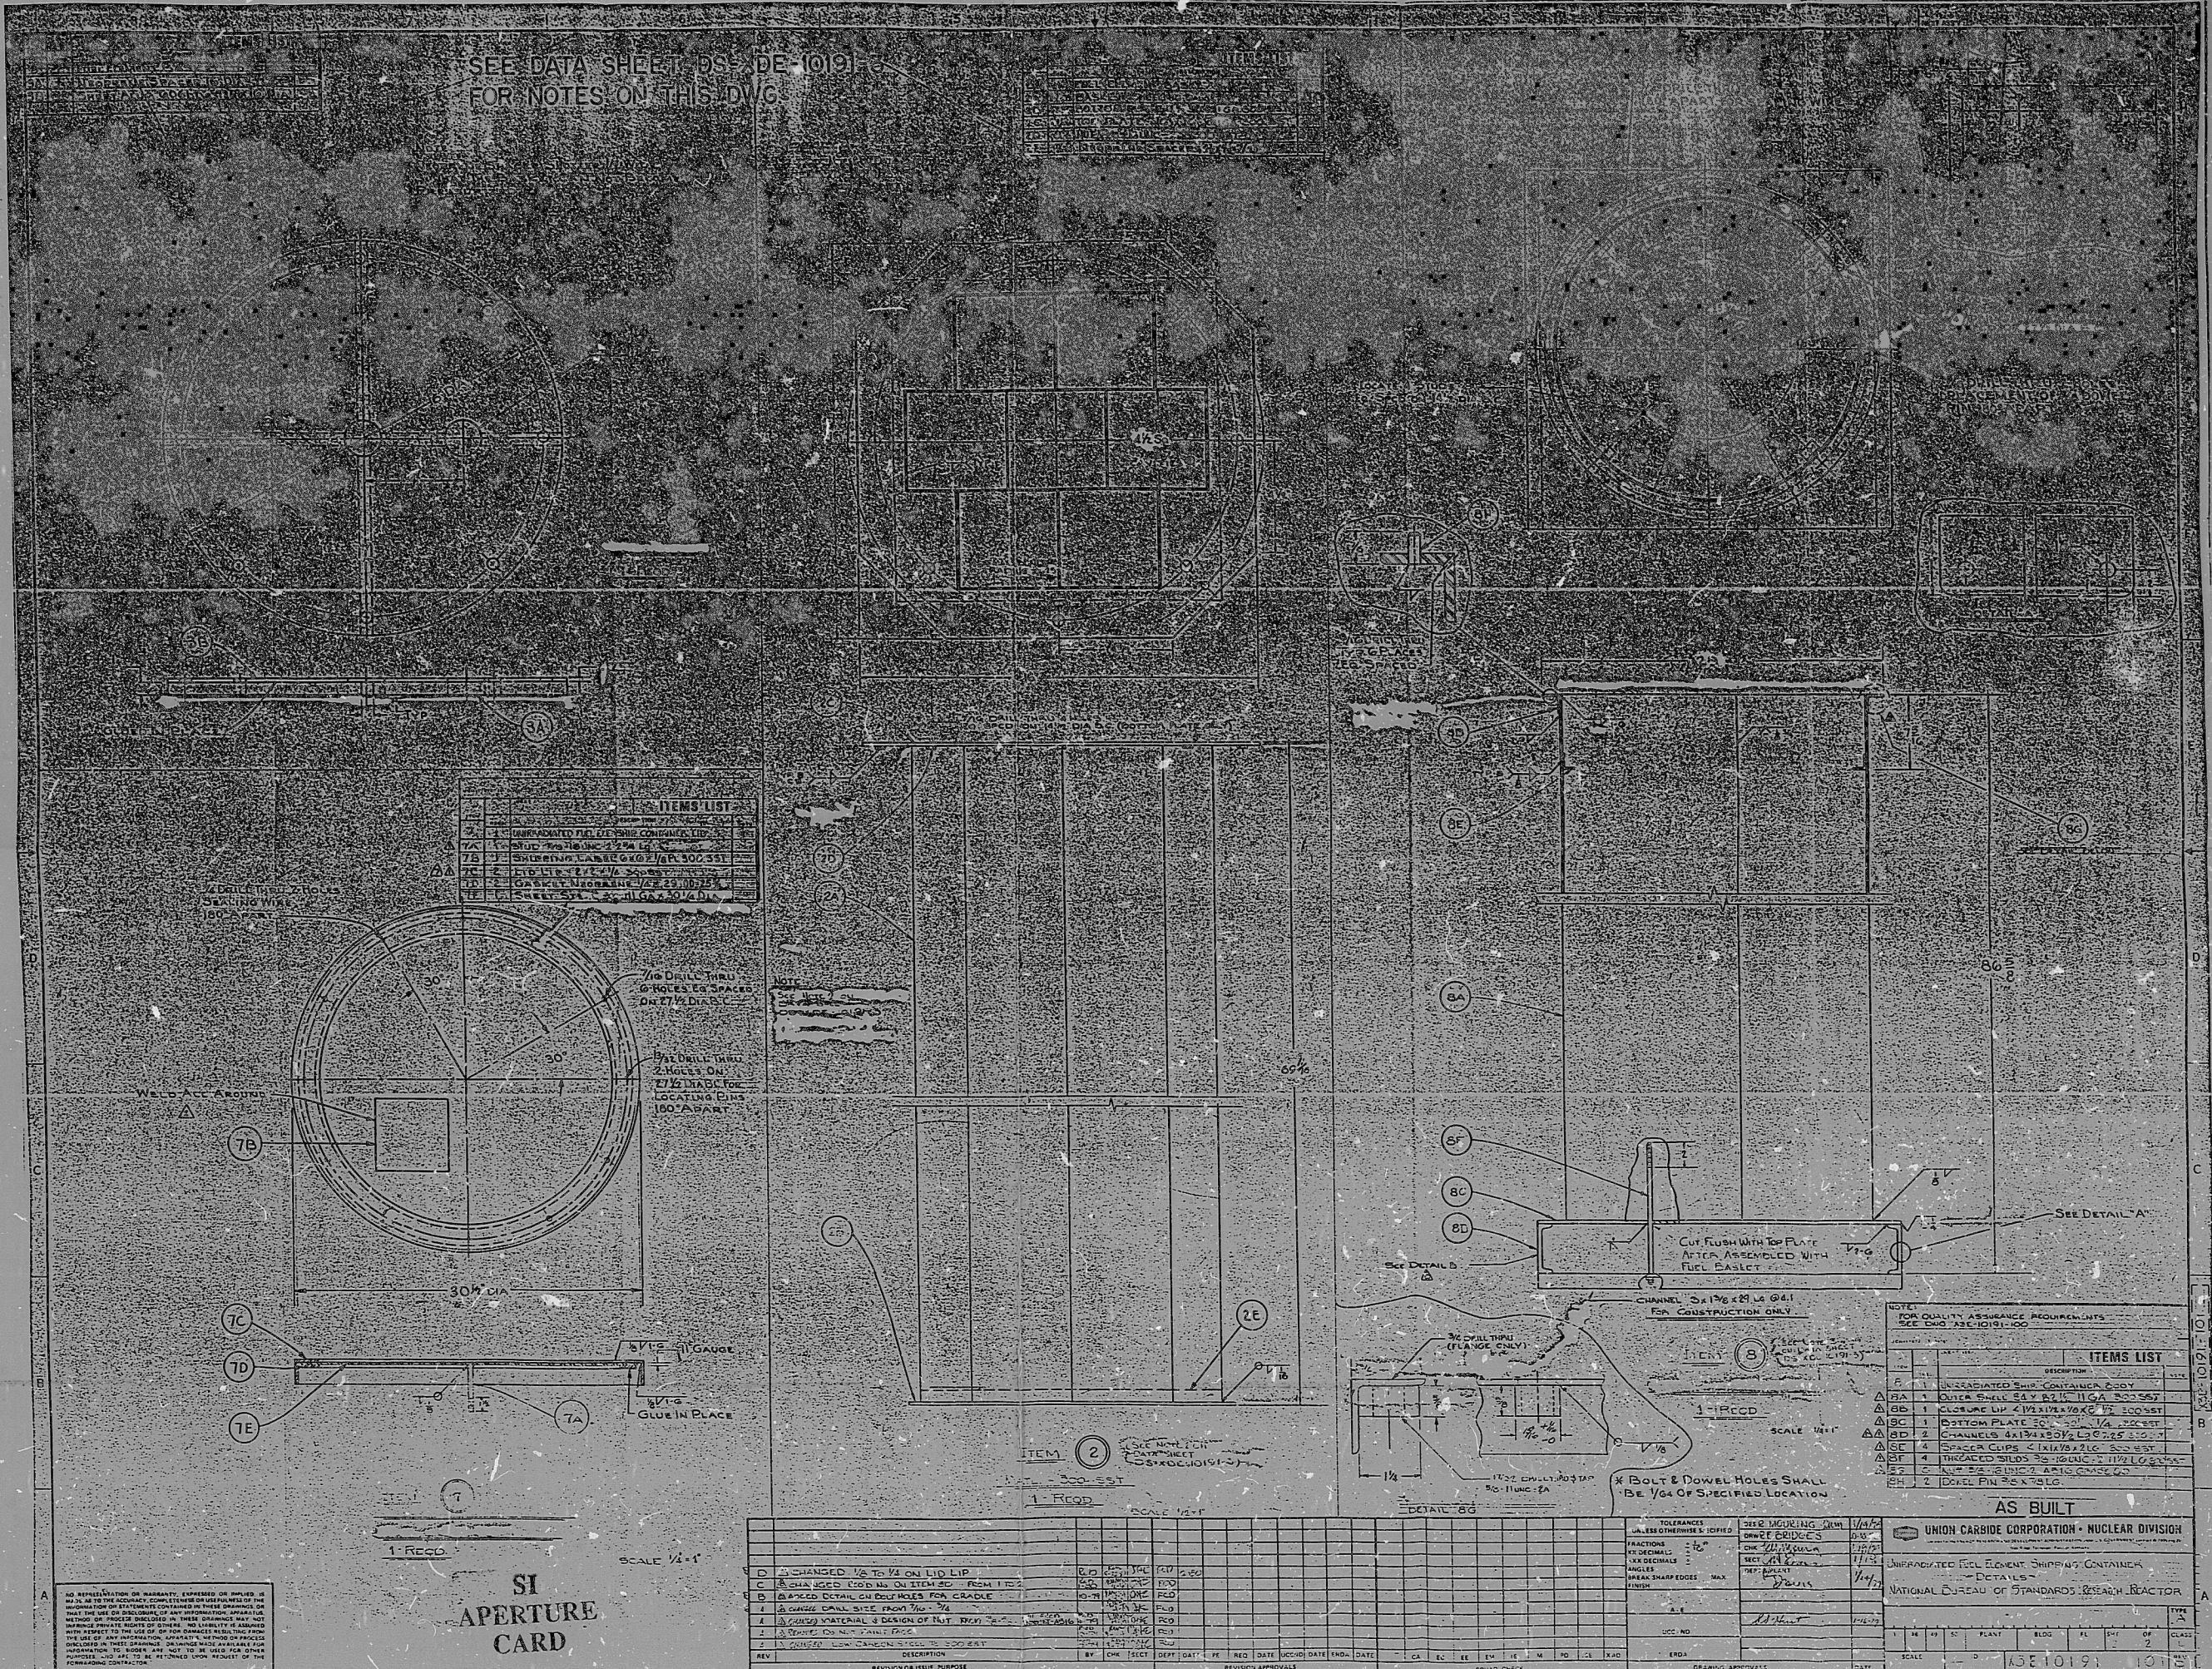