


This drawing and the design it covers are the property of BEI/TEL. They are strictly loaned and on the borrower's express agreement that they will not be reproduced, copied, loaned, exhibited, or used except in the limited way and private use permitted by any written consent given by the lender to the borrower.

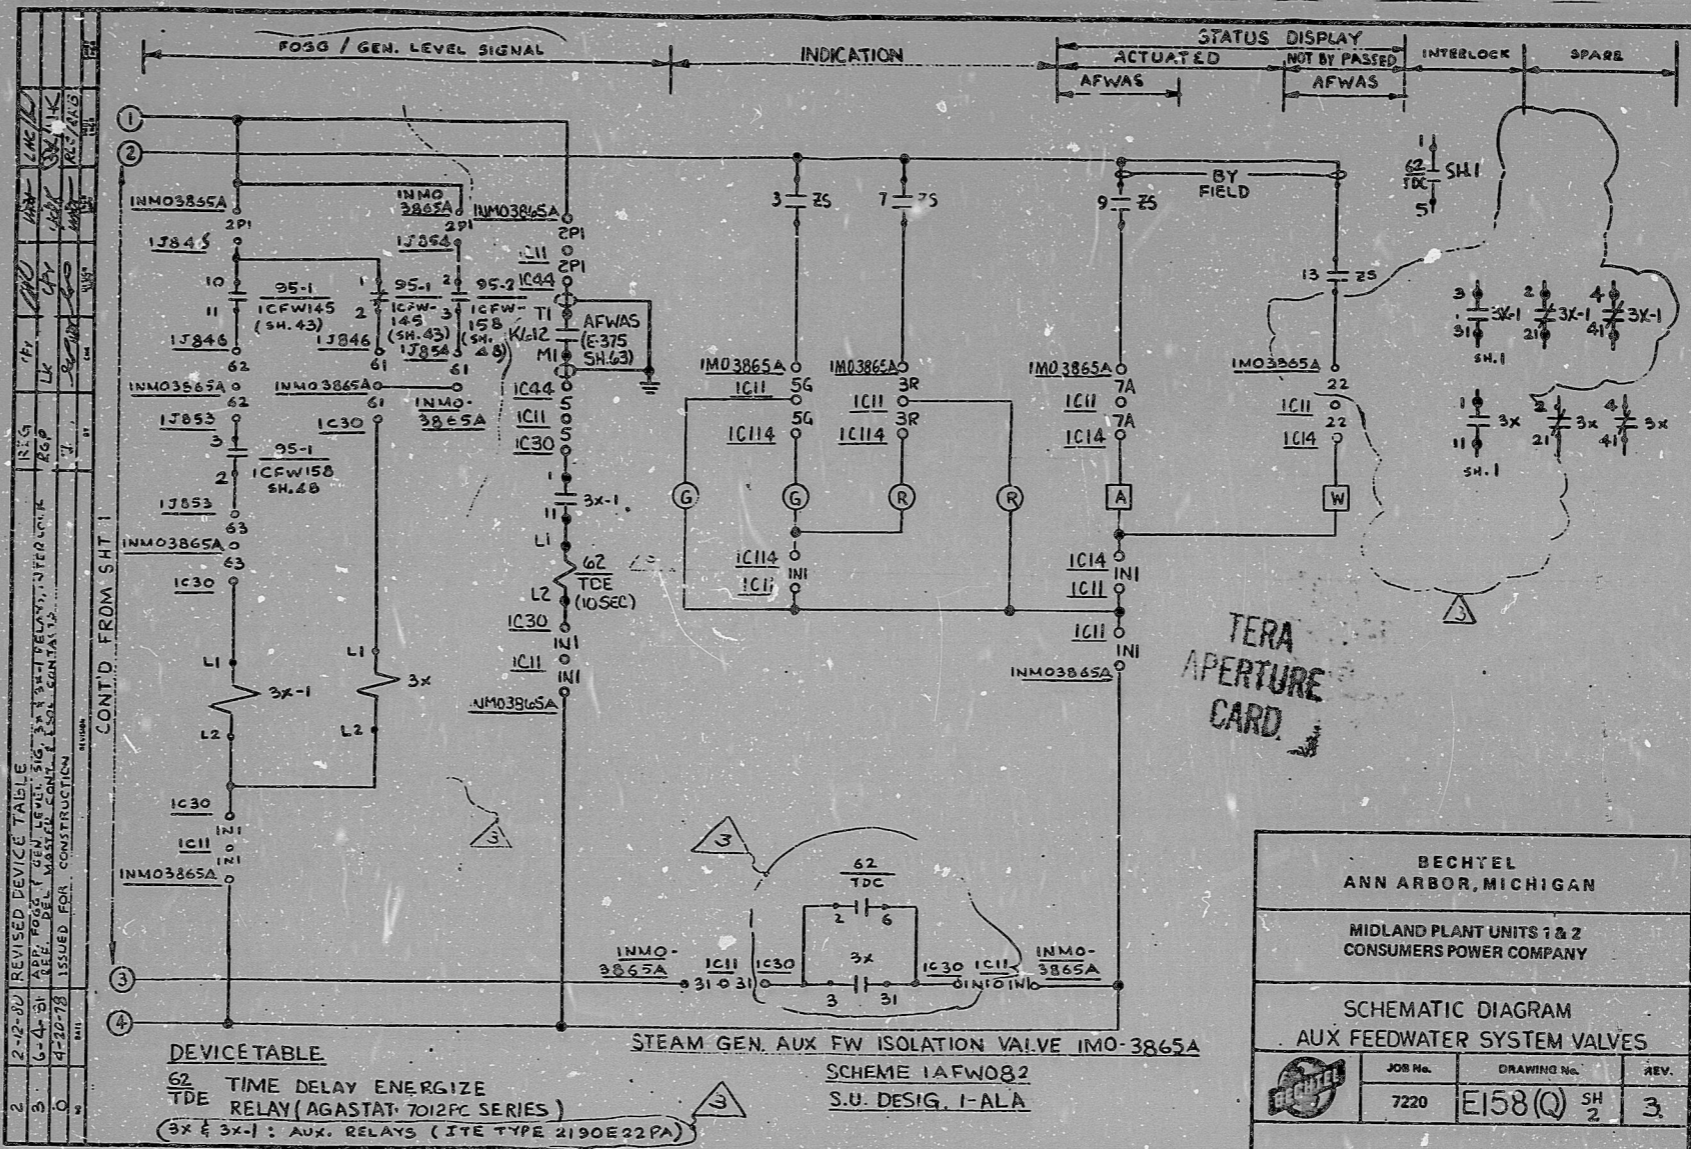

CONT'D FROM SHT 1

REV	DATE	BY	CHKD	DESCRIPTION

DEVICES TABLE

62 TIME DELAY ENERGIZE RELAY (AGASTAT 7012PC SERIES)

3X & 3X-1: AUX. RELAYS (ITE TYPE 2190E22PA)

STEAM GEN. AUX FW ISOLATION VALVE IMO-3865A  
 S.U. DESIG. I-ALA

BECHTEL  
 ANN ARBOR, MICHIGAN

MIDLAND PLANT UNITS 1 & 2  
 CONSUMERS POWER COMPANY

SCHEMATIC DIAGRAM  
 AUX FEEDWATER SYSTEM VALVES

JOB No.	DRAWING No.	REV.
7220	E158(Q) SH 2	3

**16X**

I certify that the image contained on this frame was made in the normal and regular course of business, on the data stated below and that it is an accurate reproduction of the document submitted to the contractor for filming, by Bechtel Power Corporation.

10-28-81 DATE  
 R. Caselle CAMERA OPERATOR  
 J. Thomas CONTRACTOR'S SUPERVISOR OR MANAGER

RIDS

8112230235

