

ITEM NUMBERS

002.012.004
54574

- NOTES
- CONTROL VALVE FITTED WITH HAND WHEEL FOR EMERGENCY MANUAL OPERATION.
 - VALVES AND COILS PROVED BY CONSTRUCTION FOR FLUSH AND HYD.
 - THIS COMPARTMENT HAS NOT BUILT TO RISE III. FOR THIS IT WILL BE BUILT THE APPLICABLE CODE AT THE TIME OF PURCHASE PER INSURANCE POLICY.
 - INSULATE TO FLOOR ON REL. 750°F.
 - INSULATE TO WALL AT COL. W.

DESIGN PROPERTIES

NO.	DESIGN TEMPERATURE	CLASS	NOTES
1	150 PSIG	150°F	
2	150 PSIG	150°F	
3	150 PSIG	150°F	
4	150 PSIG	150°F	
5	150 PSIG	150°F	


REVISIONS

NO.	DATE	BY	CHKD	DATE	APPROV	REVISION
1						
2						
3						
4						
5						

O. A. CONDITION 1
DUKE POWER COMPANY
FLOW DIAGRAM OF
COMPONENT COOLING

SI
APERTURE
CARD
FOR INFORMATION
ONLY

CL. 3 N/A/60 SHT 1

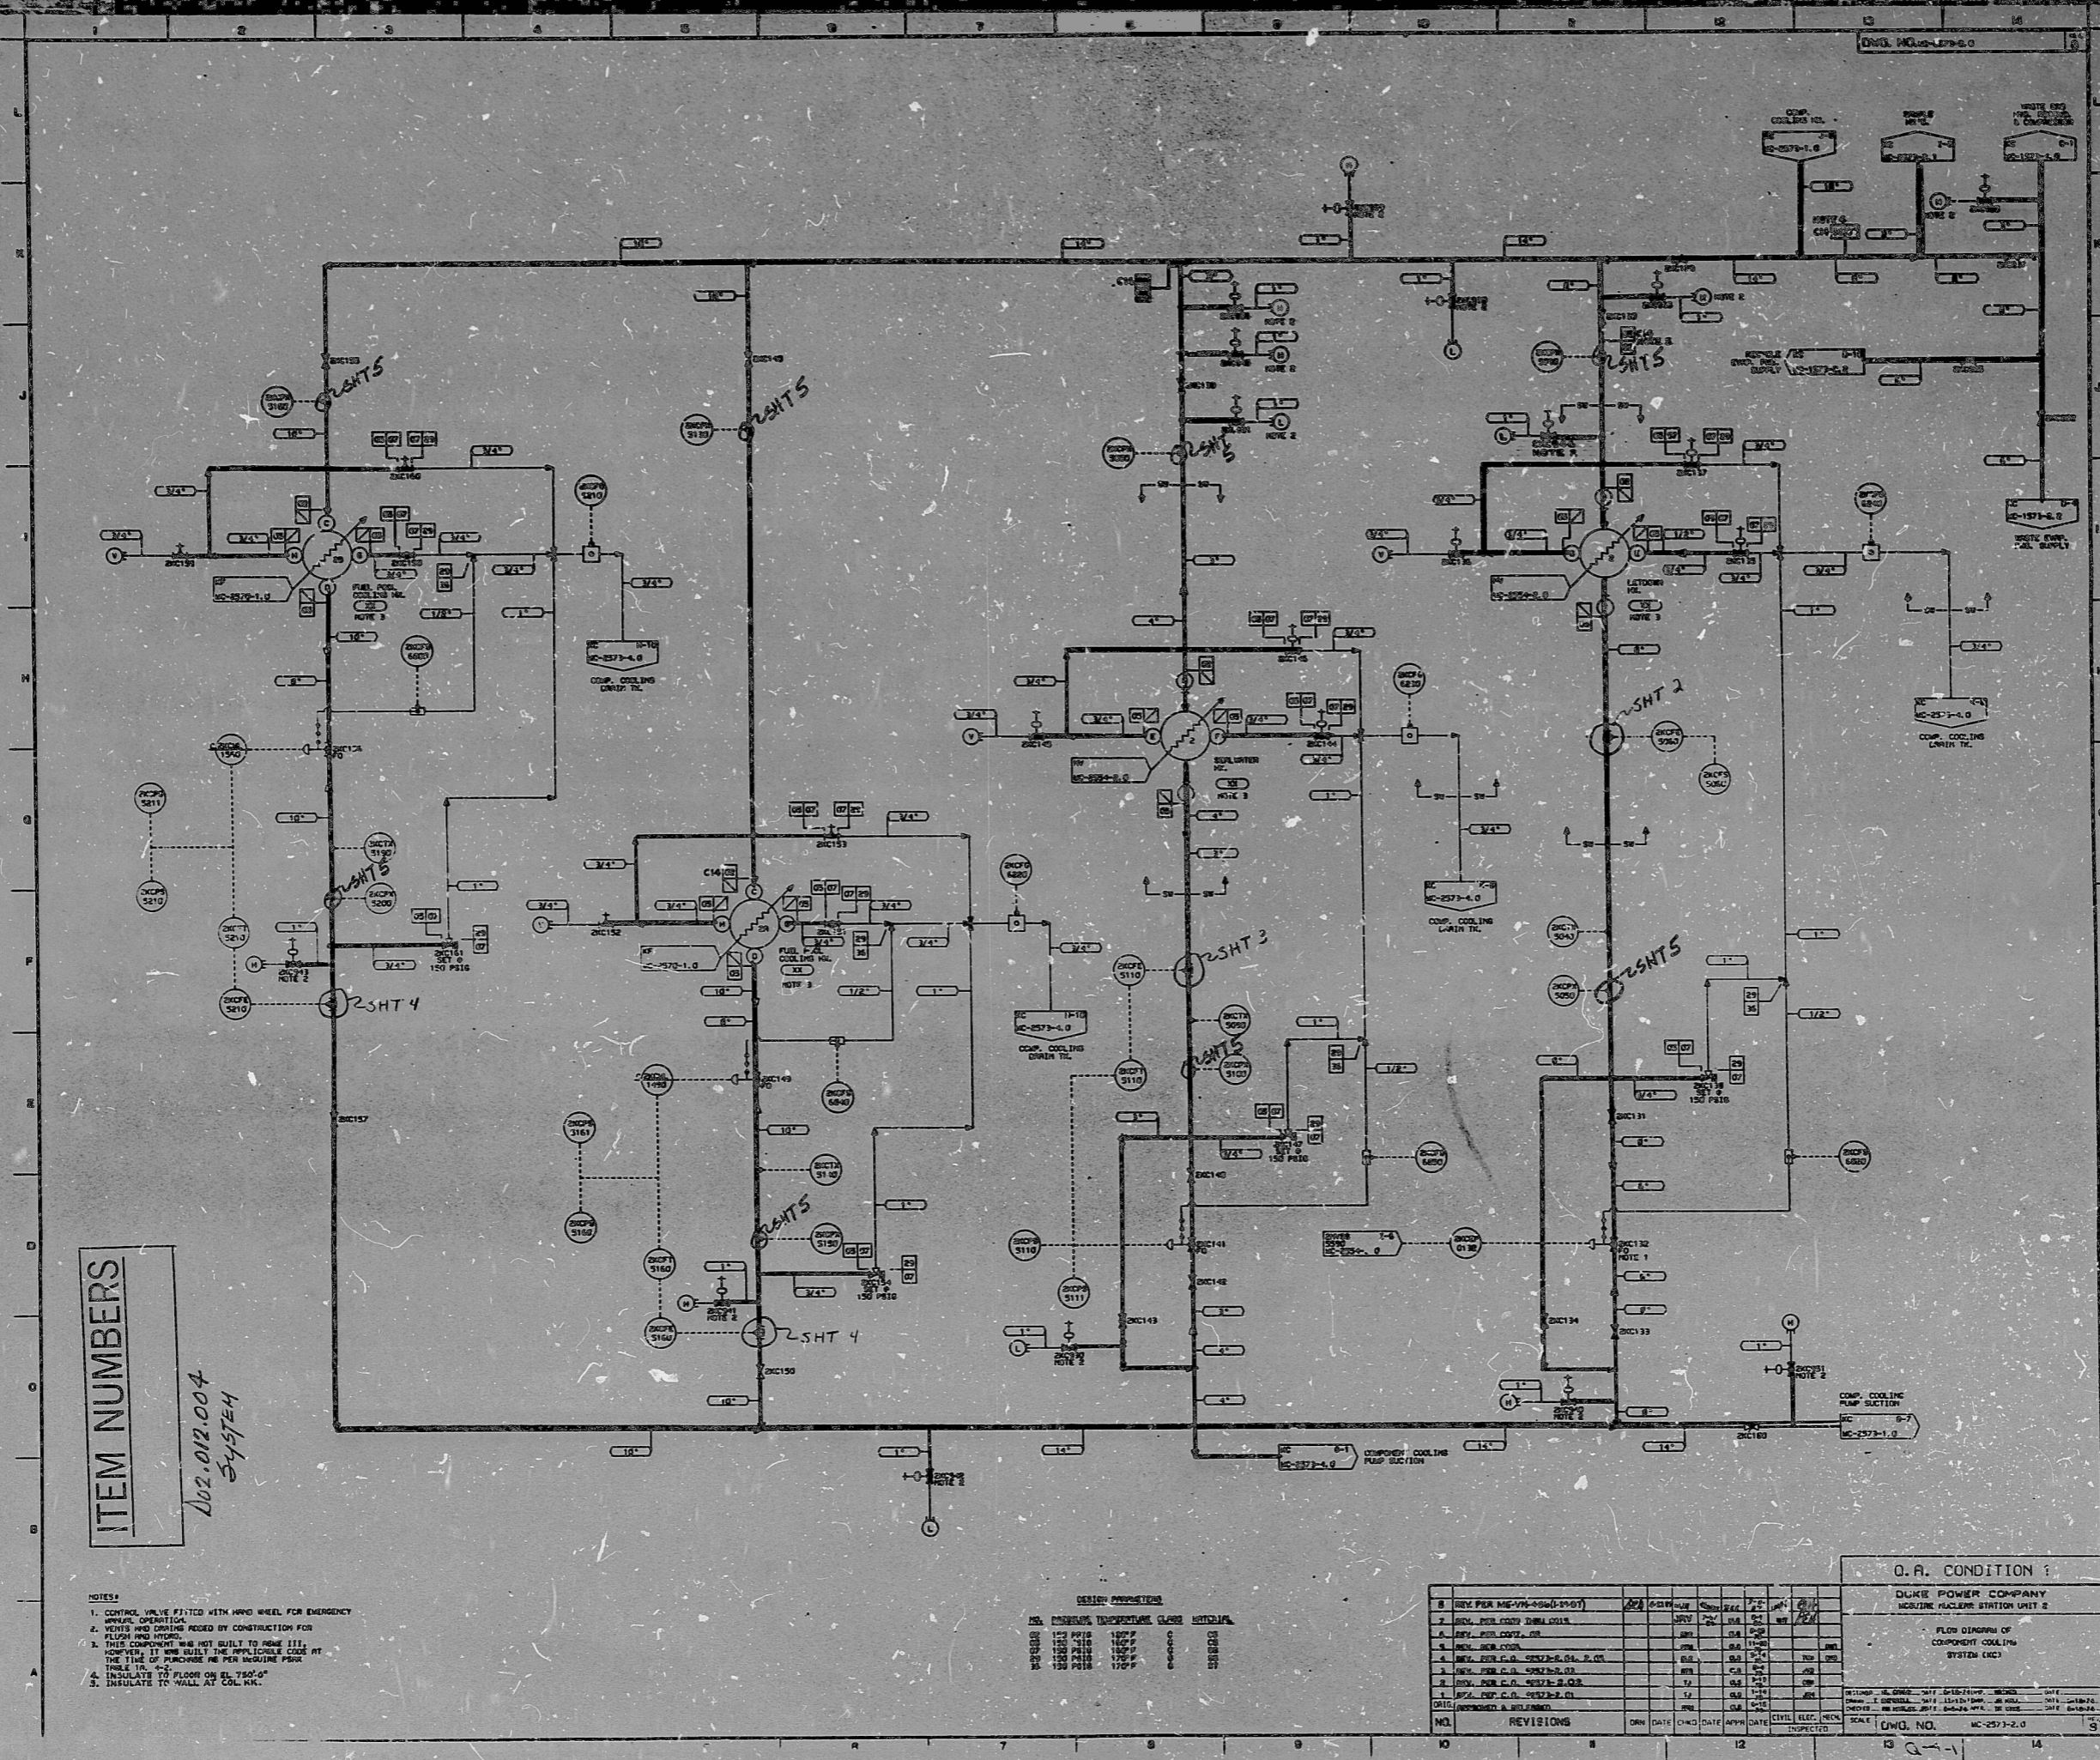

DR RIDS

8904180 286

