
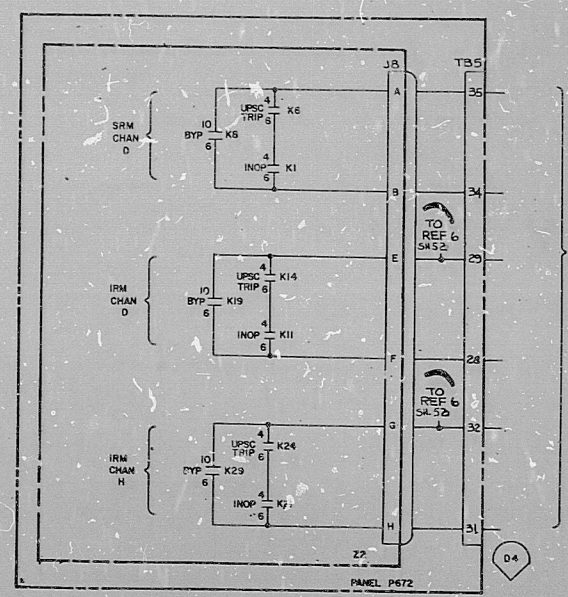
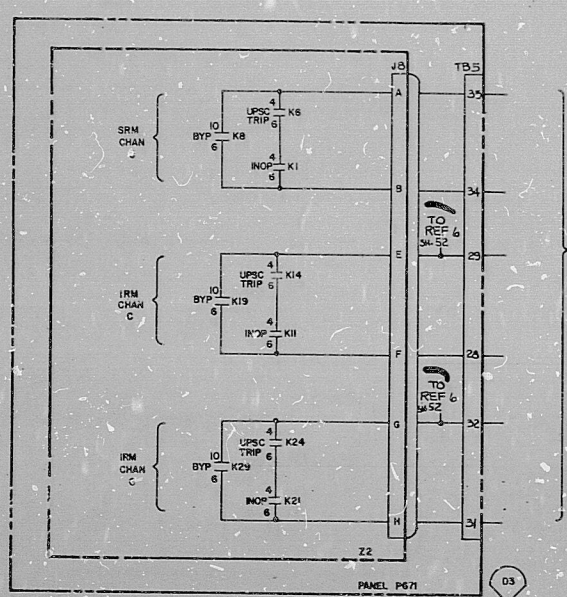
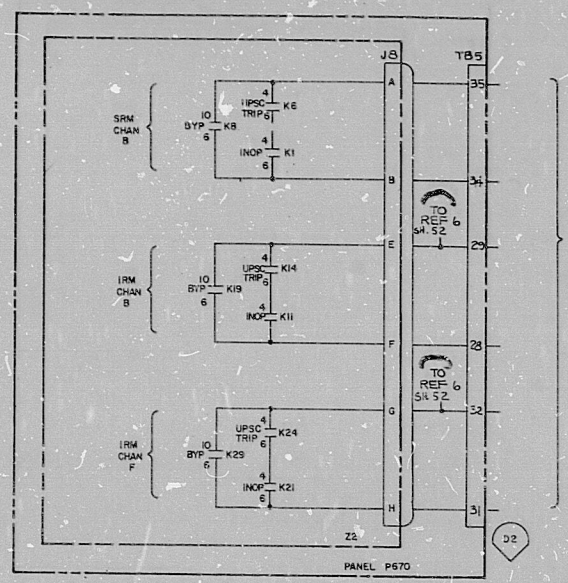


TRIP OUTPUTS TO PROTECTION SYS

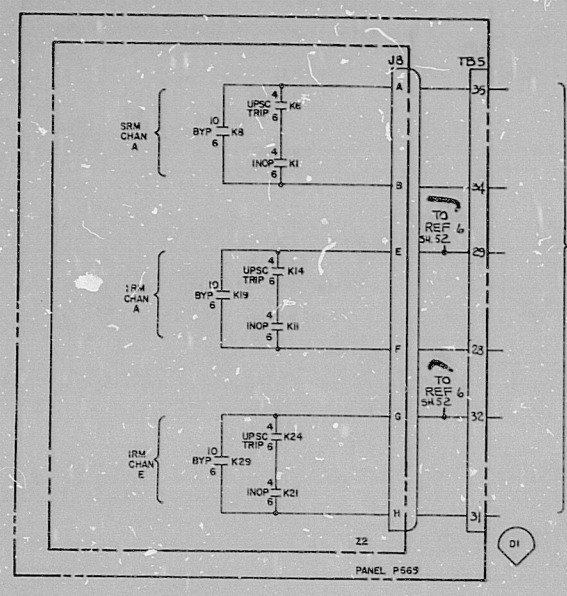

TI APERTURE CARD

1 LINE COORDS:
 NONE THIS SHEET

NO	DESCRIPTION	DATE	BY	CHKD	APPROV
10	NJS1895	11/21/77	J. J. ...		
11	GEN. DOC. CHG				
12	CHKD BY SHANNON				
13	CHKD BY P. ...				

71
 11
 9.8
 8.5
 11
 17

71
 11
 9.8
 8.5
 11
 17

8412190366

PDR RIDS

