


16X

an accurate reproduction of the document submitted to reprographics.

8.5.81 *C. W. ...*
DATE CAMERA OPERATOR SUPERVISOR OF REPROGRAPHICS

Q-1348

This drawing and the design it covers are the property of BECHTEL. They are hereby loaned and on the borrower's express agreement that they will not be reproduced, copied, exhibited, or used except in the limited way and for the limited purpose intended by the lender to the borrower.

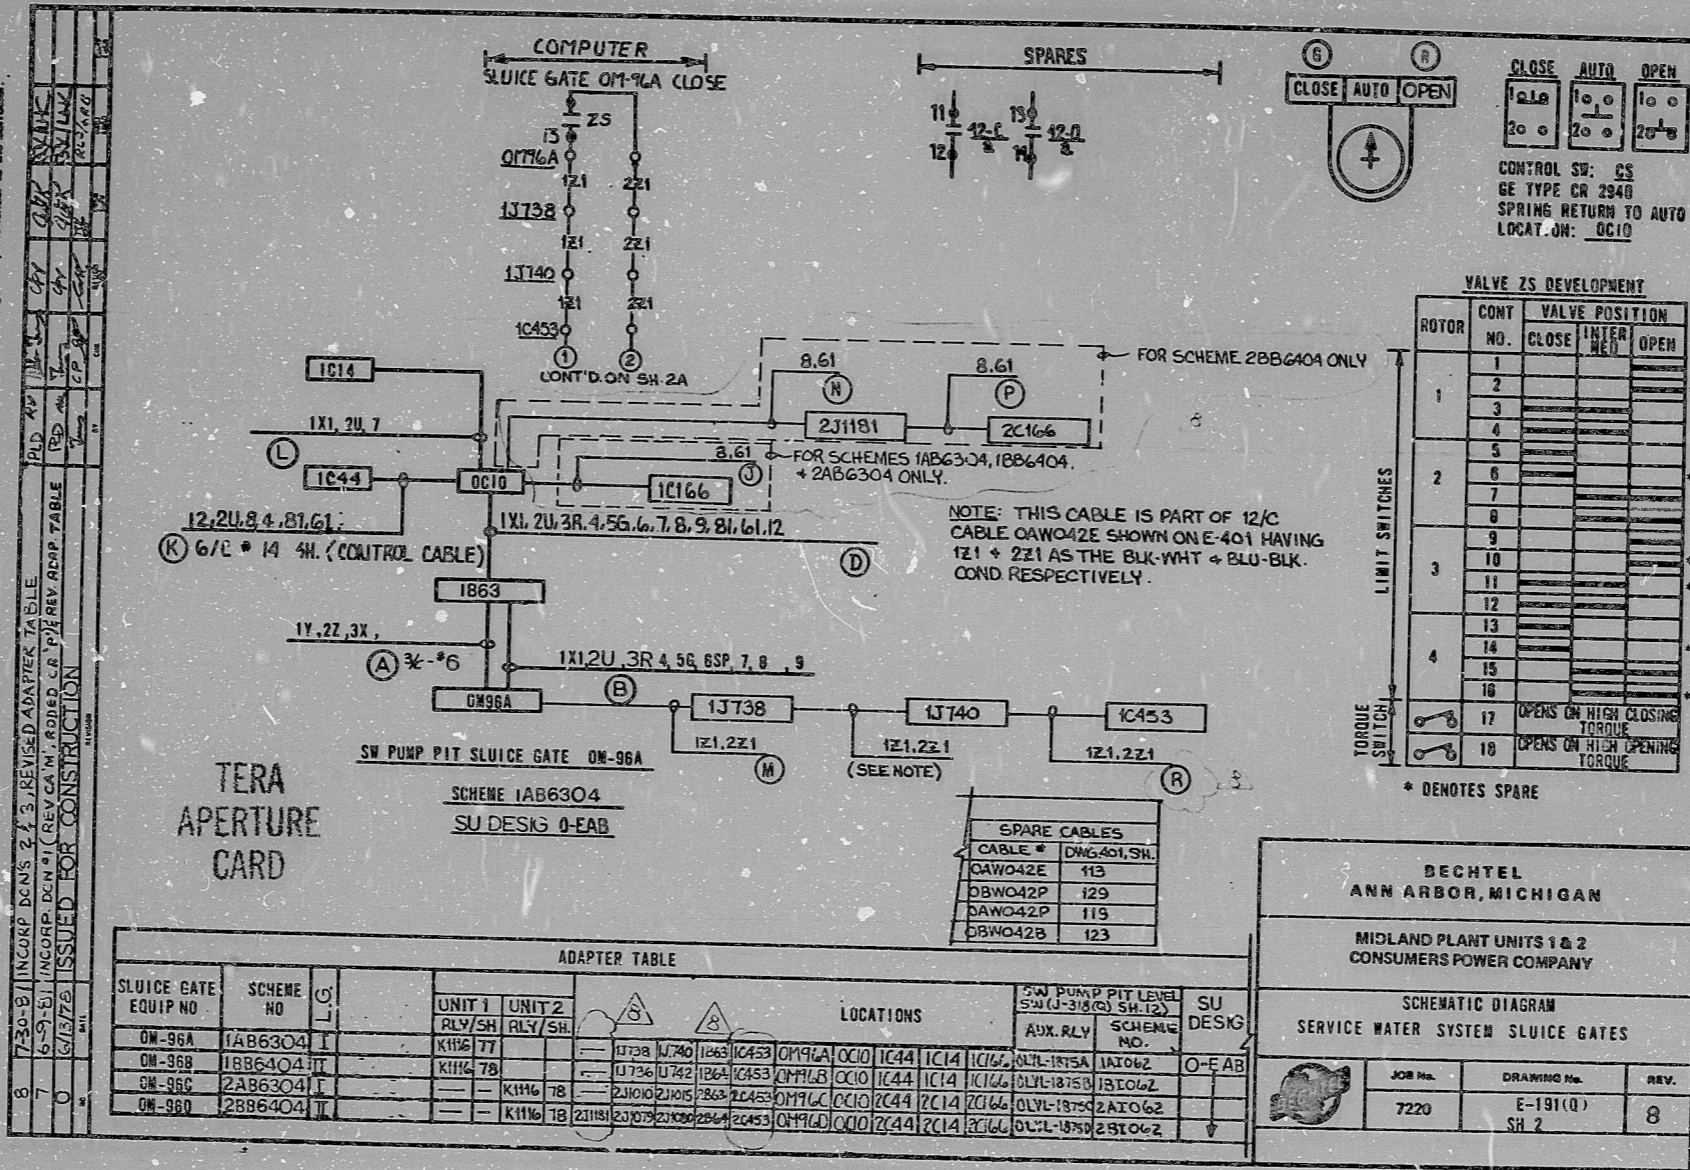

RIDS

8112230403

