


22"  
17"  
11"  
8.5"  
8.5"  
11"  
17"  
22"

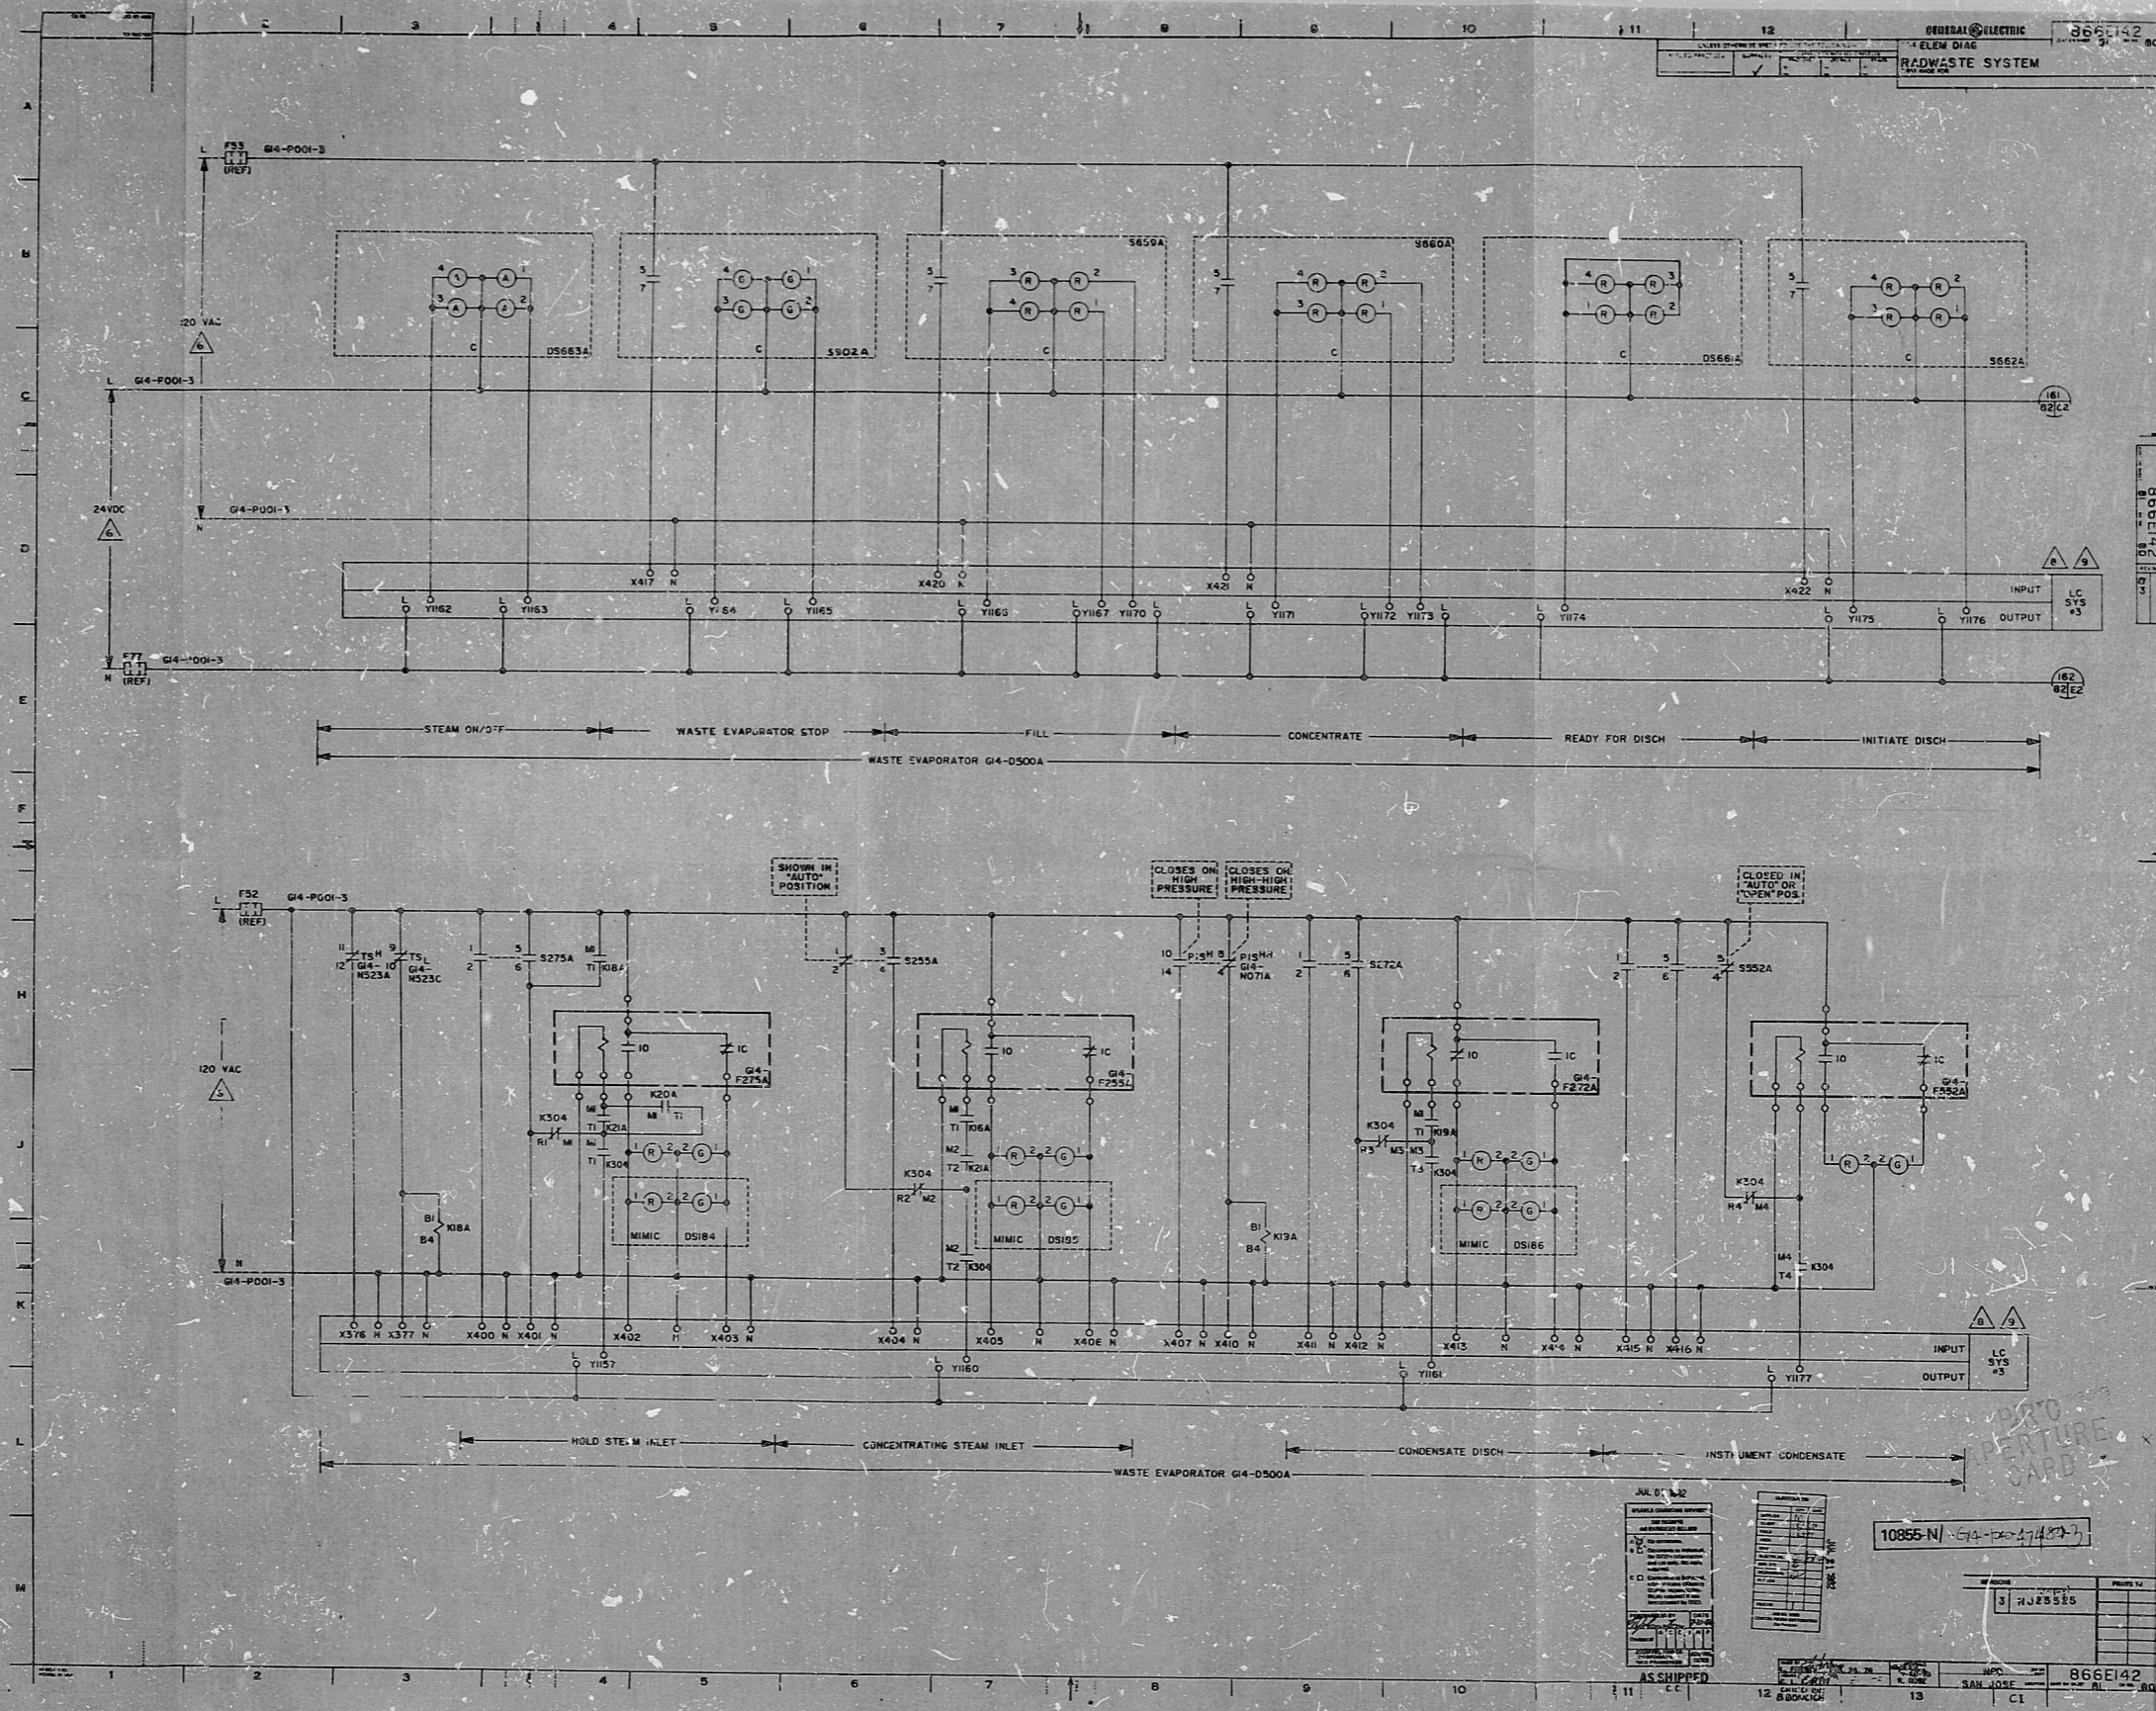

22"  
17"  
11"  
8.5"  
8.5"  
11"  
17"  
22"

866E142  
RADWASTE SYSTEM  
10855-N-014-10-17487-3  
3 JUN 58  
AS SHIPPED  
12 866E142  
13 SAN JOSE CA

RIDS

8307280258

