

ITEM NUMBERS

002, 012, 012
SYSTEM

1. VALVE OPENING PRESSURE IS 150 PSIG.
2. LOCAL PUMP INDICATOR FROM COMPARTMENT THROTTLING VALVE IS POSITIVE THROTTLING.
3. CLEANOUT CONNECTION.

VALVE PRESSURE


NO.	REVISIONS	DATE	BY	APP'D	REASON


ON CONDITION 1
DUKE POWER COMPANY
FLOW DIRECTION

SCALE: 1" = 10'-0"

DWG. NO. UC-2374-9-C

SA
APERTURE
CARD
FOR INFORMATION
ONLY

02.3.14.020
SHT 1

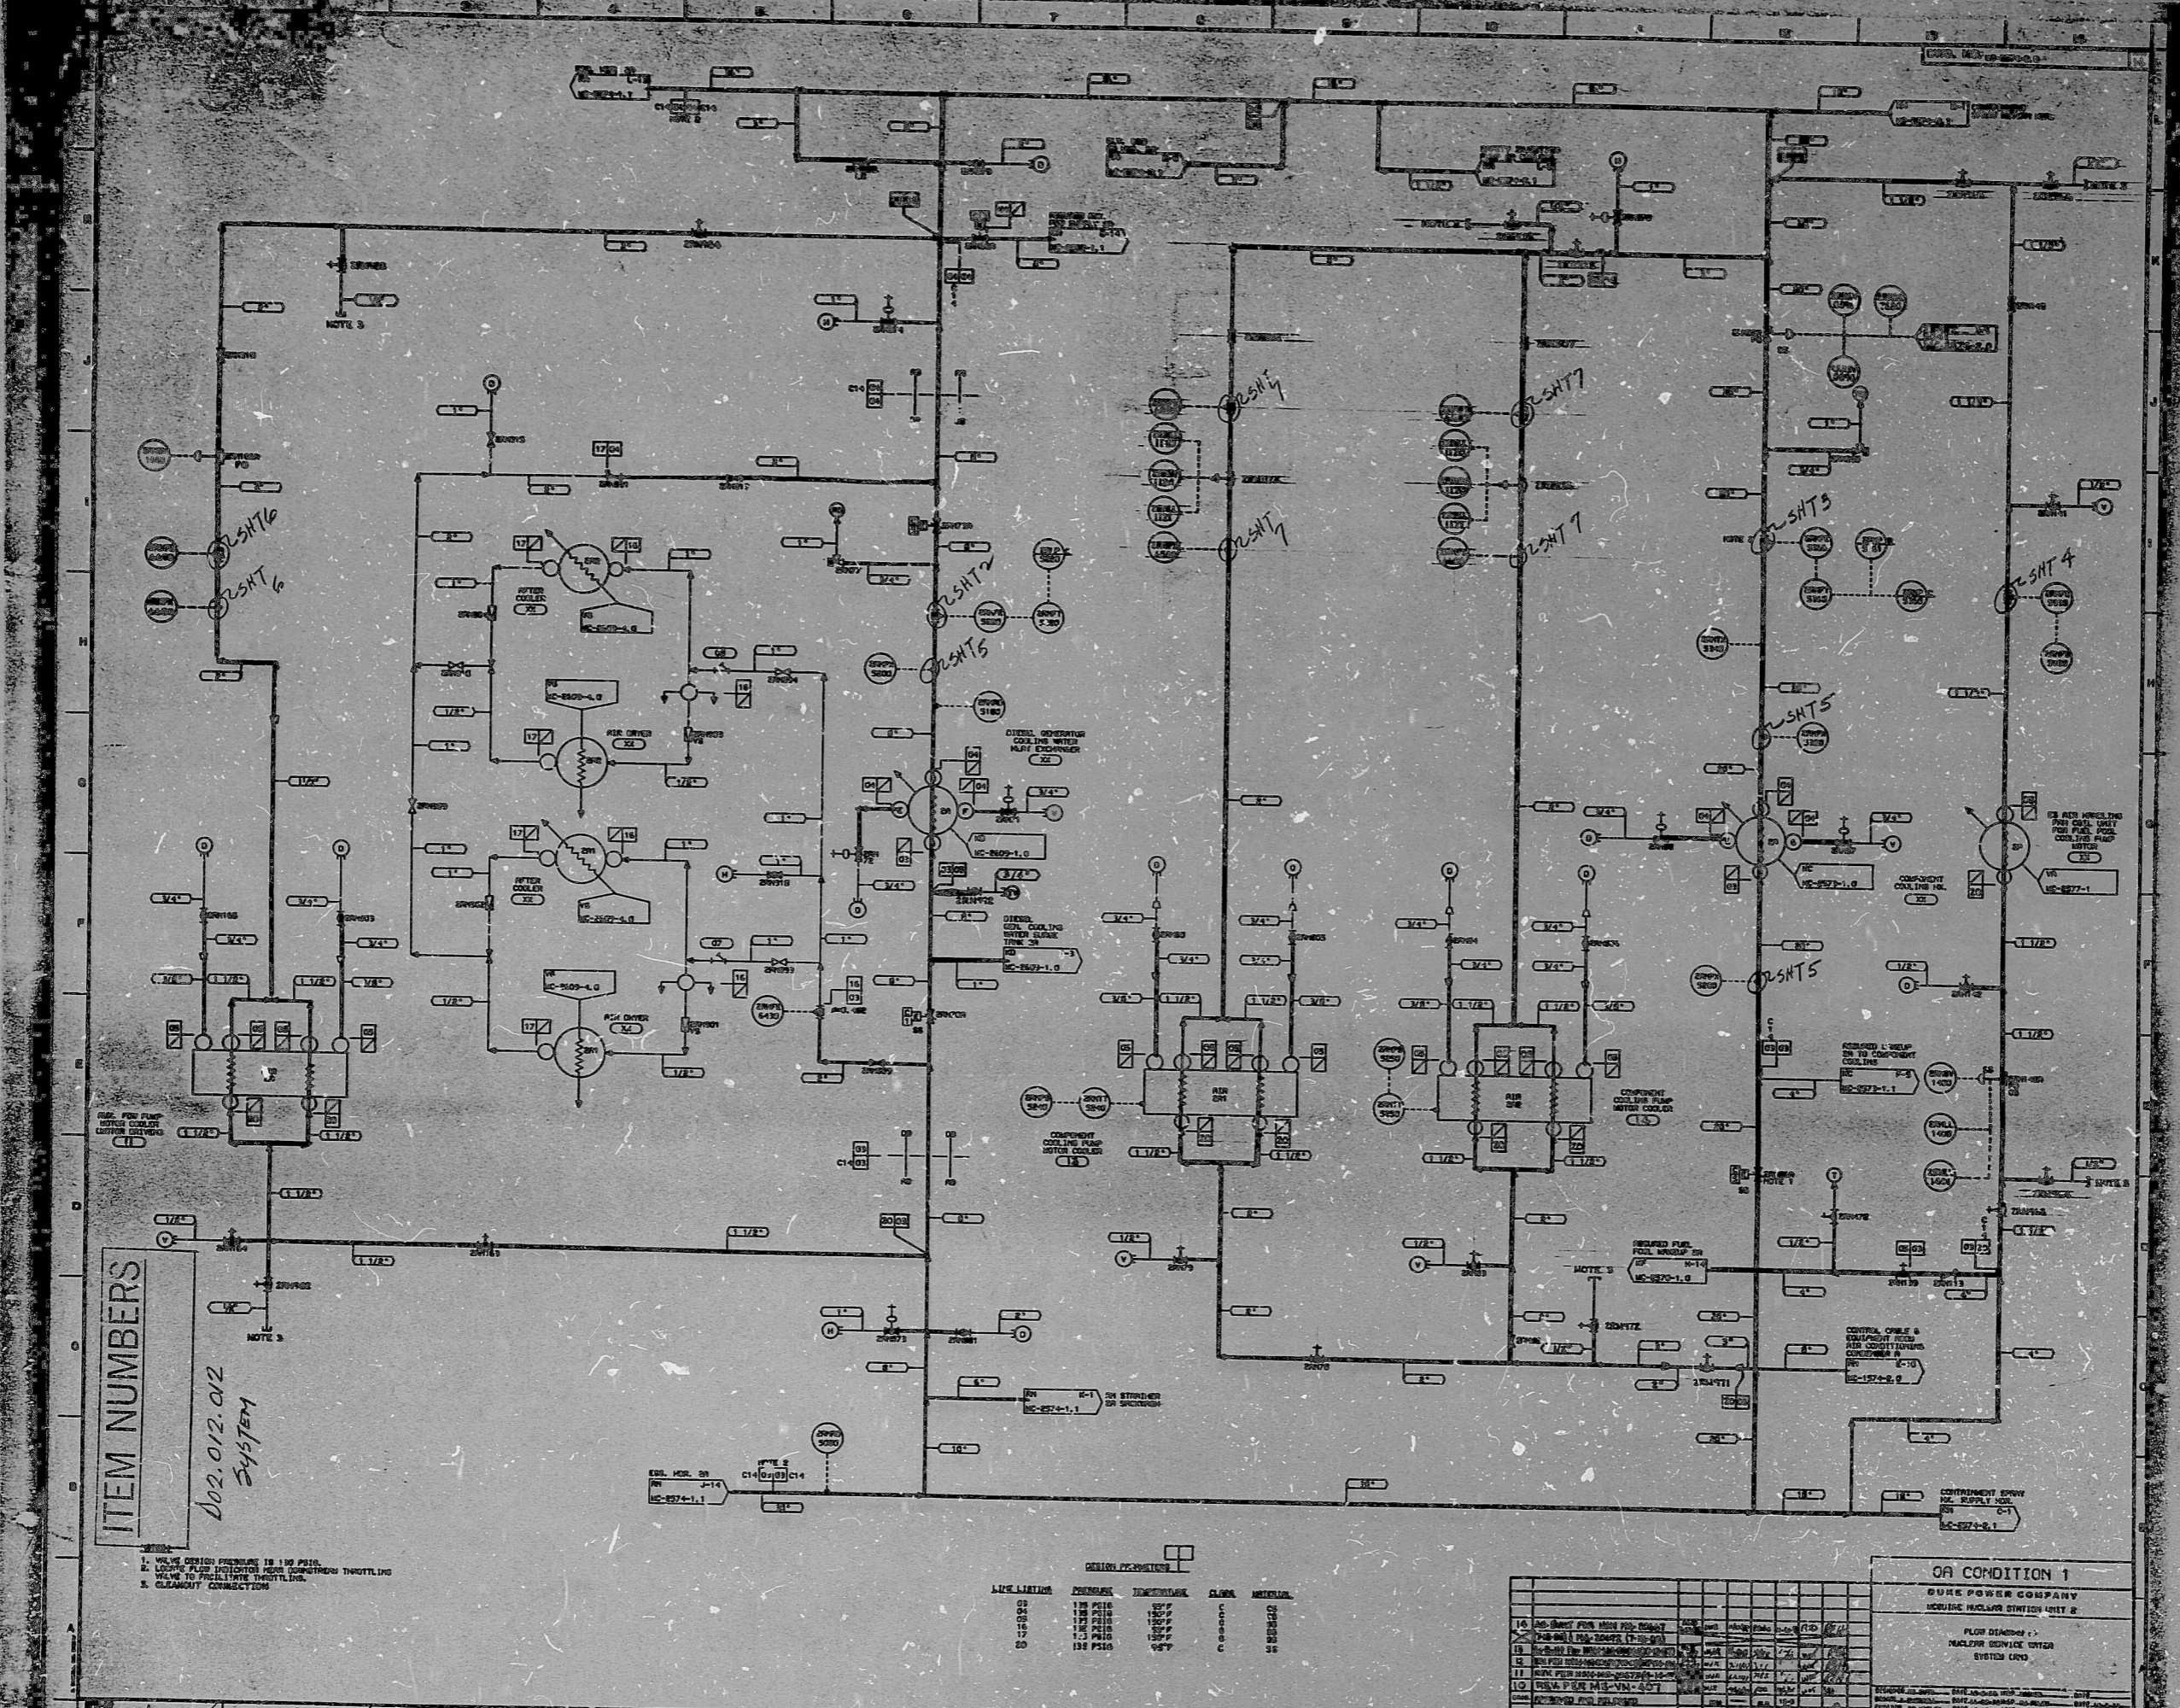

PDR RIDS

8904190437

