


This drawing and the design it covers are the property of BECHTEL. They are hereby loaned and on the borrower's express agreement that they will not be reproduced, copied, loaned, exhibited, or used except in the limited way and private use permitted by any written consent given by the lender to the borrower.

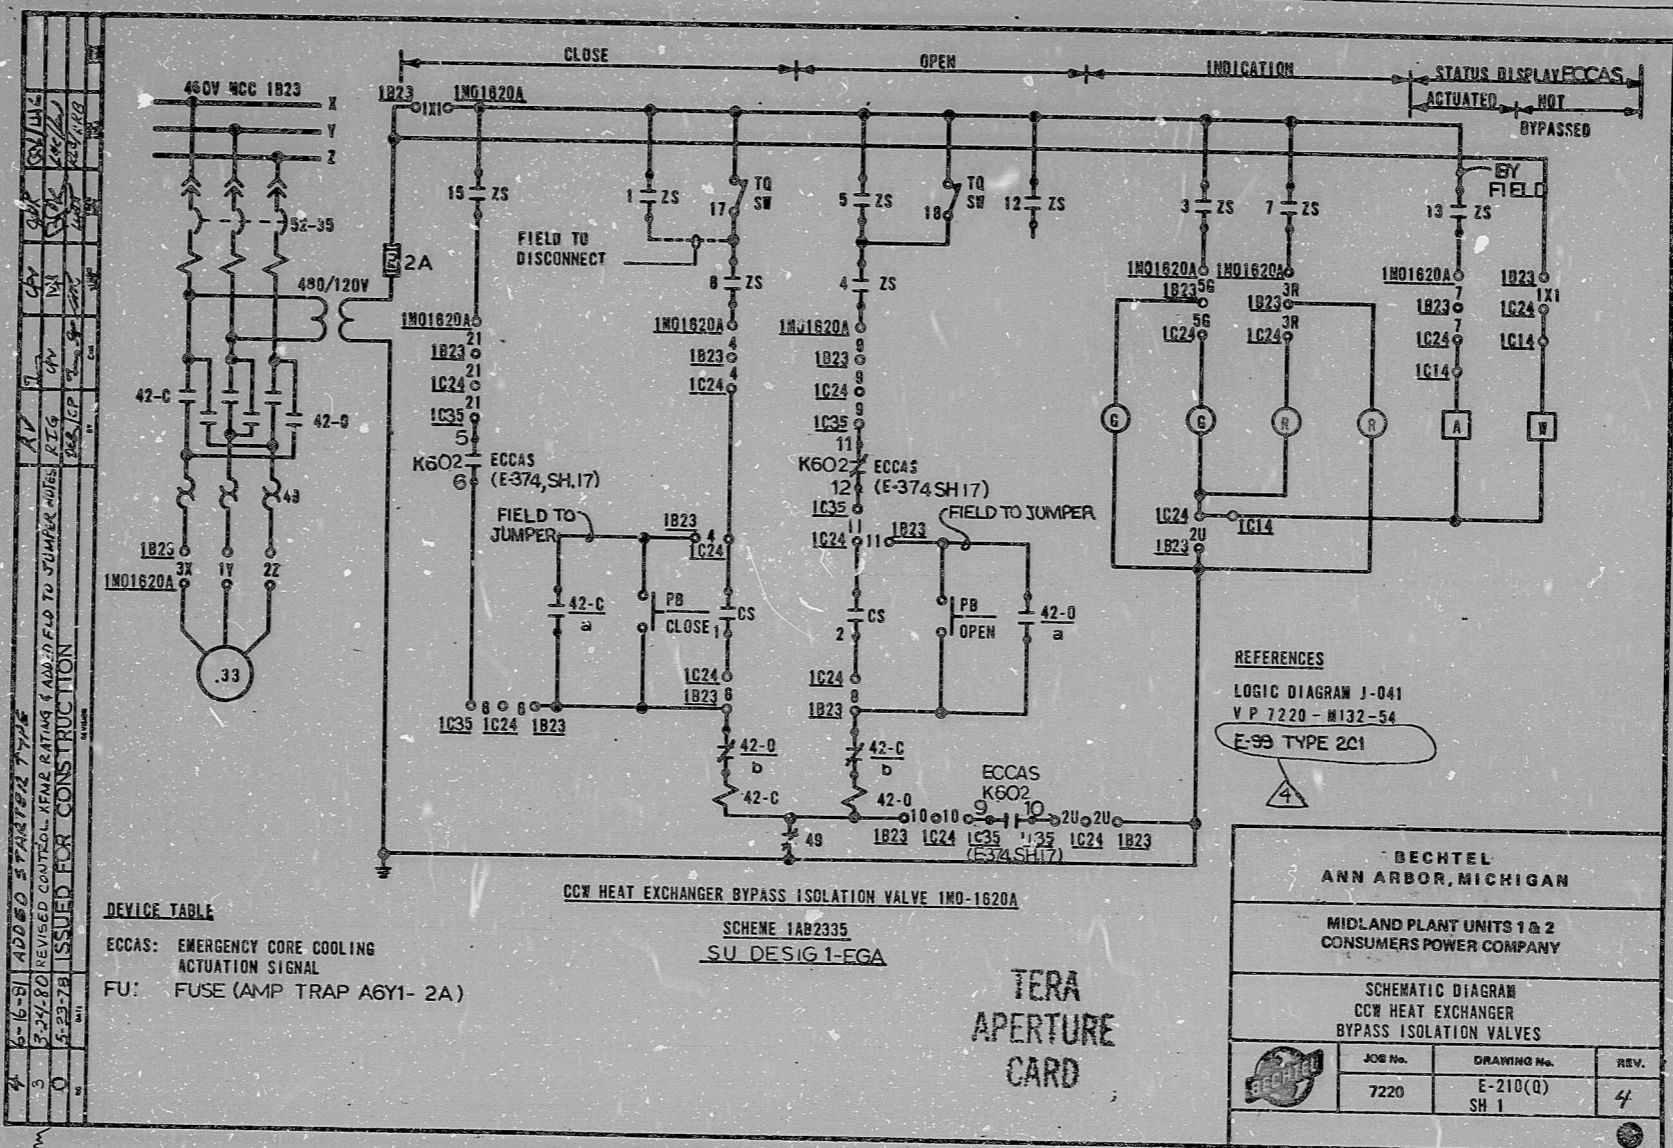

REV	DATE	BY	CHKD	DESCRIPTION
4	5-16-81	AV	AV	ADDED STARTER TIME
3	5-24-80	AV	AV	REVISED CONTROL WIRE RATING & ADDED FLD TO JUMPER WIRE
0	5-23-78	AV	AV	ISSUED FOR CONSTRUCTION

DEVICE TABLE
 ECCAS: EMERGENCY CORE COOLING ACTUATION SIGNAL
 FU: FUSE (AMP TRAP A6Y1- 2A)

CCW HEAT EXCHANGER BYPASS ISOLATION VALVE 1M0-1G20A
 SCHEME 1AB2335
 SU DESIG 1-EGA

TERA
 APERTURE
 CARD

REFERENCES
 LOGIC DIAGRAM J-041
 V P 7220 - N132-54
 E-99 TYPE 2C1

BECHTEL ANN ARBOR, MICHIGAN		
MIDLAND PLANT UNITS 1 & 2 CONSUMERS POWER COMPANY		
SCHEMATIC DIAGRAM CCW HEAT EXCHANGER BYPASS ISOLATION VALVES		
JOB No.	DRAWING No.	REV.
7220	E-210(0) SH 1	4

I certify that the image contained on this frame was made in the normal and regular course of business, on the date stated below and that it is an accurate reproduction of the document submitted to reprographics.

6-19-81 *R. Bradley*
 DATE CAMERA OPERATOR SUPERVISOR OF REPROGRAPHICS

16X

G-1348

RIDS

8112230442

