



This drawing and the design it covers are the property of BECHTEL. They are hereby loaned and on the borrower's express agreement that it will not be reproduced, copied, loaned, exhibited, or used except in the limited way and purpose as permitted by any written consent given by the lender. In the borrower's possession.

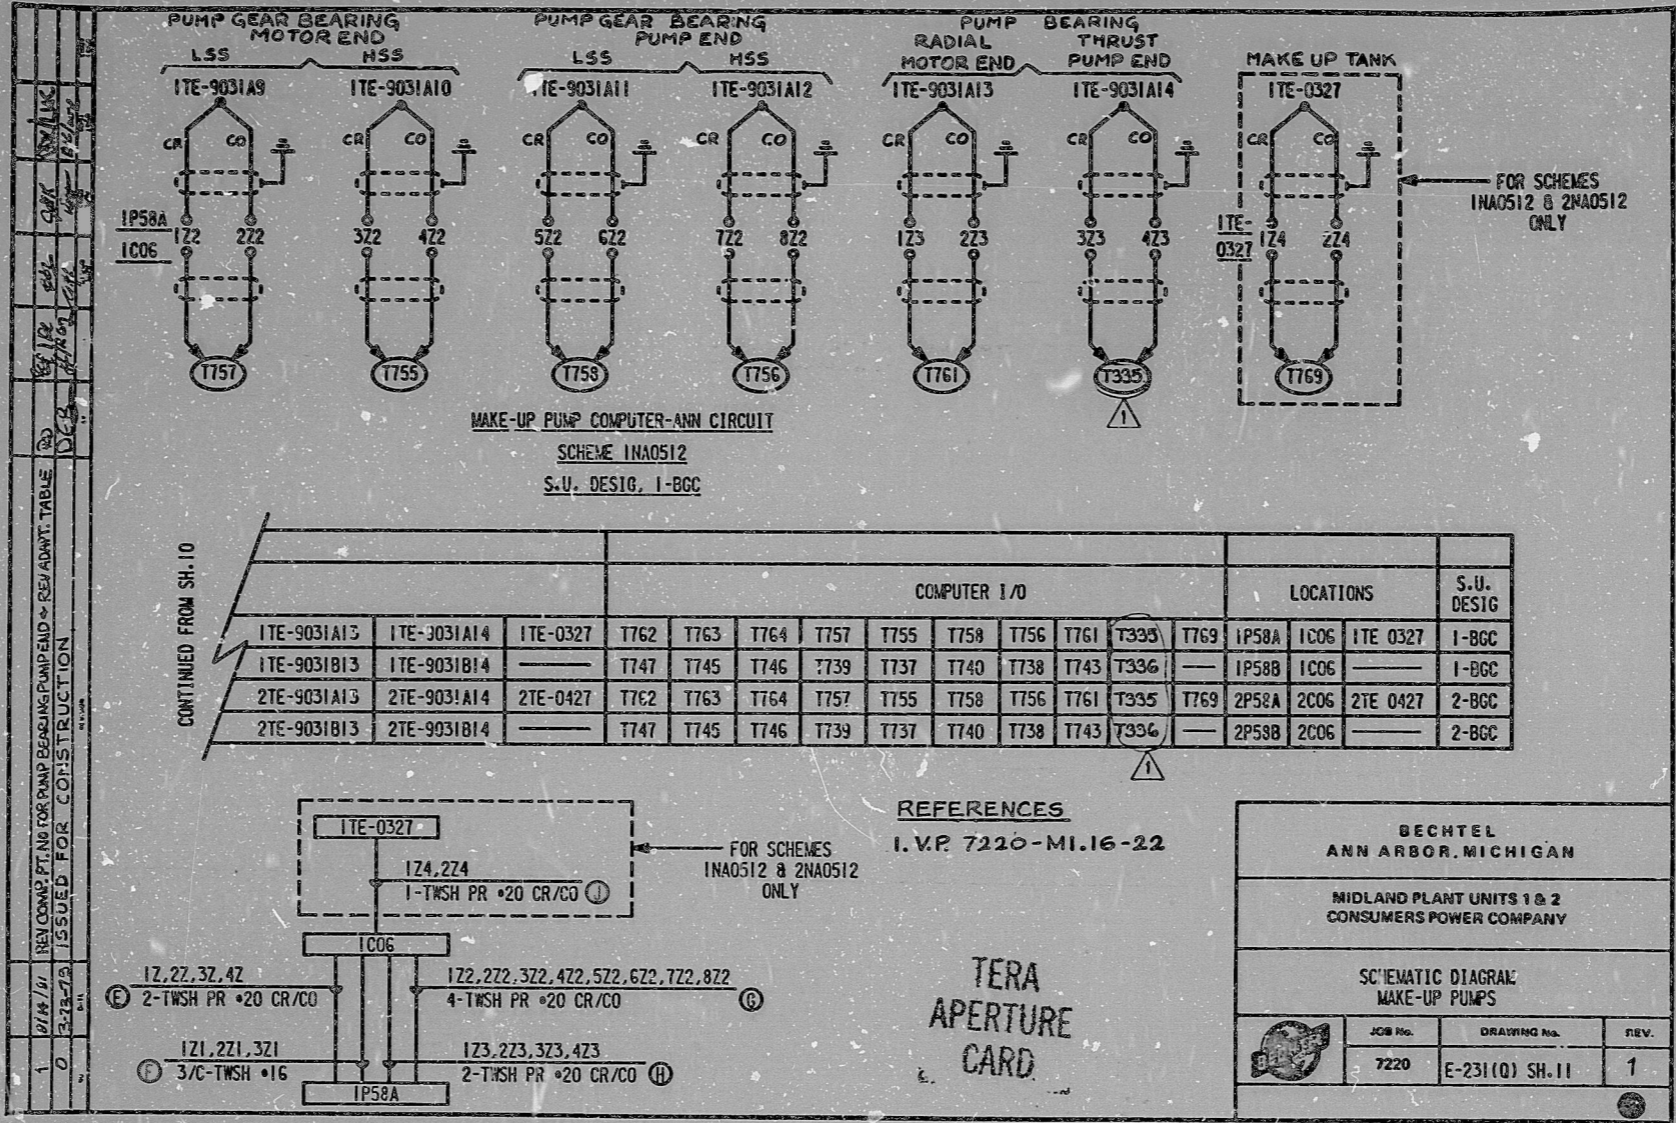

MAKE-UP PUMP COMPUTER-ANN CIRCUIT  
SCHEME 1NA0512  
S.U. DESIG. 1-BGC

CONTINUED FROM SH. 10

| COMPUTER I/O |             |          |      |      |      |      |      |      |      | LOCATIONS |      |      | S.U. DESIG |      |          |       |
|--------------|-------------|----------|------|------|------|------|------|------|------|-----------|------|------|------------|------|----------|-------|
| ITE-9031A13  | ITE-9031A14 | ITE-0327 | T762 | T763 | T764 | T757 | T755 | T758 | T756 | T761      | T335 | T769 | IP58A      | IC06 | ITE 0327 | 1-BGC |
| ITE-9031B13  | ITE-9031B14 |          | T747 | T745 | T746 | T739 | T737 | T740 | T738 | T743      | T336 |      | IP58B      | IC06 |          | 1-BGC |
| 2TE-9031A13  | 2TE-9031A14 | 2TE-0427 | T762 | T763 | T764 | T757 | T755 | T758 | T756 | T761      | T335 | T769 | 2P58A      | 2C06 | 2TE 0427 | 2-BGC |
| 2TE-9031B13  | 2TE-9031B14 |          | T747 | T745 | T746 | T739 | T737 | T740 | T738 | T743      | T336 |      | 2P58B      | 2C06 |          | 2-BGC |

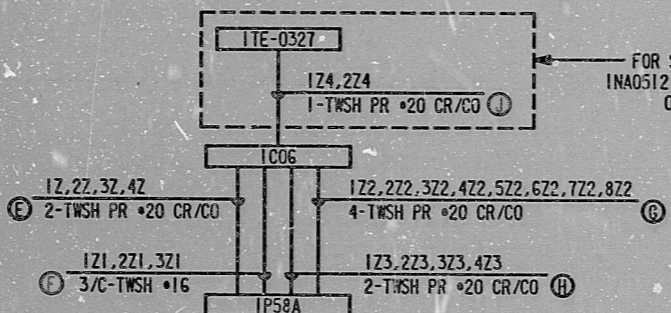

REFERENCES  
I.V.P. 7220-MI.16-22

TERA APERTURE CARD

|  |                |      |
|--|----------------|------|
| BECHTEL<br>ANN ARBOR, MICHIGAN                       |                |      |
| MIDLAND PLANT UNITS 1 & 2<br>CONSUMERS POWER COMPANY |                |      |
| SCHEMATIC DIAGRAM<br>MAKE-UP PUMPS                   |                |      |
| JOB No.  | DRAWING No.    | REV. |
| 7220   | E-231(Q) SH.11 | 1    |

**16X**

I certify that the image contained on this frame was made in the normal and regular course of business, on the date stated below and that it is an accurate reproduction of the document submitted to reprographics.

8-27-81 DATE  
B. L. ... CAMERA OPERATOR  
... SUPERVISOR OF MICROGRAPHICS

G-1348

RIDS

8112230512

