
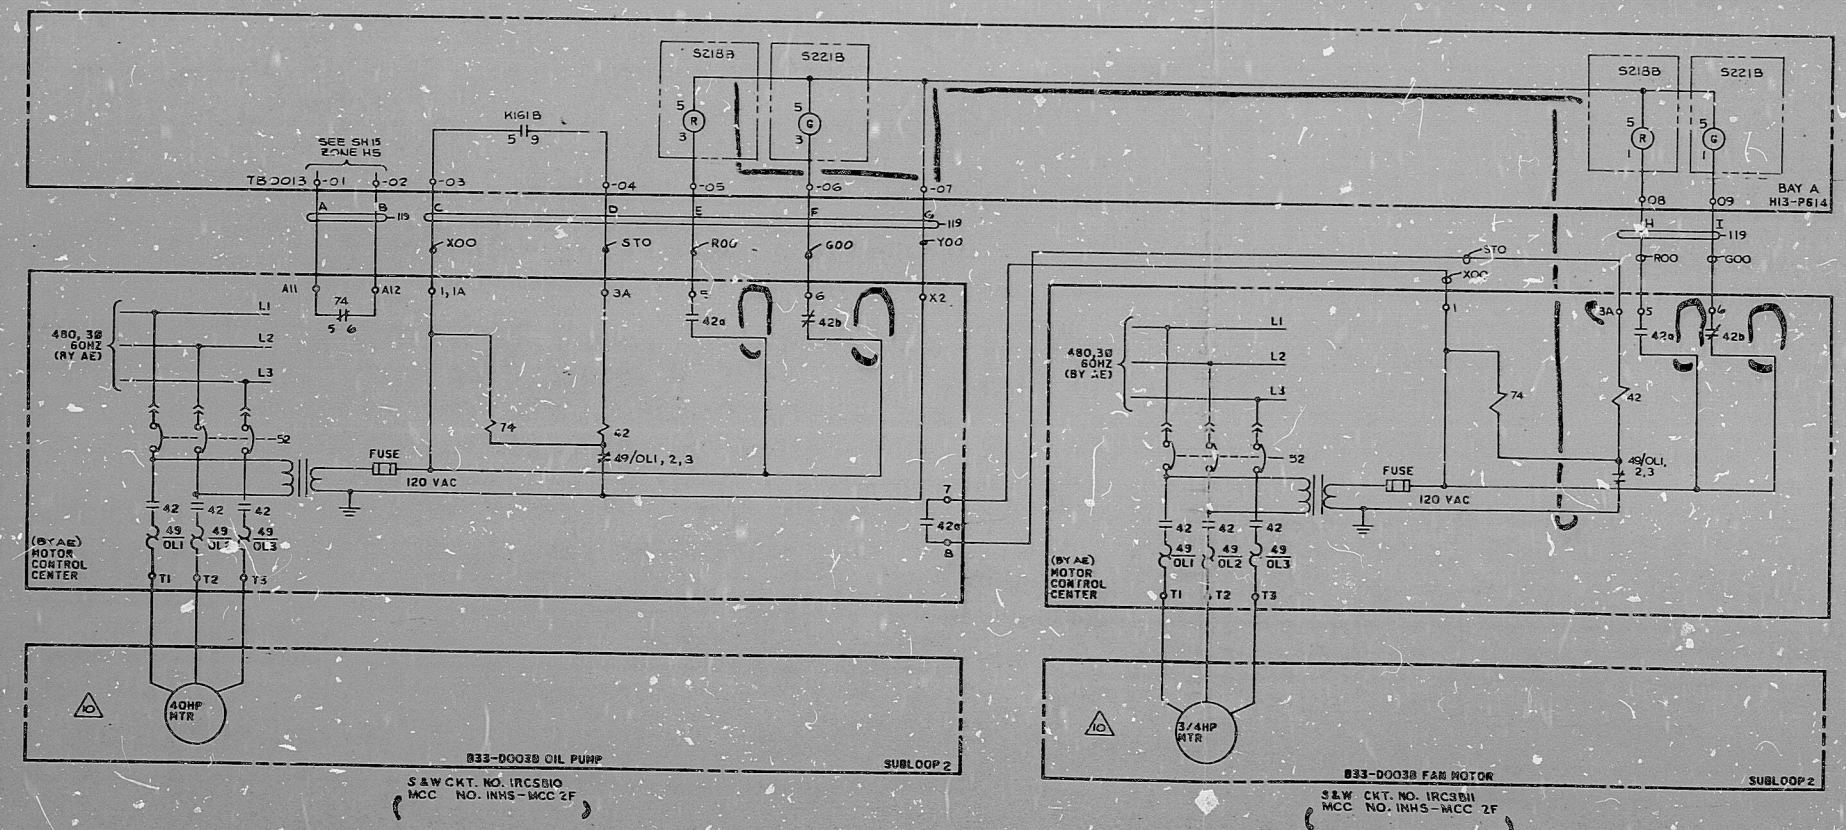


HPU OIL PUMP CONTROLS "B"

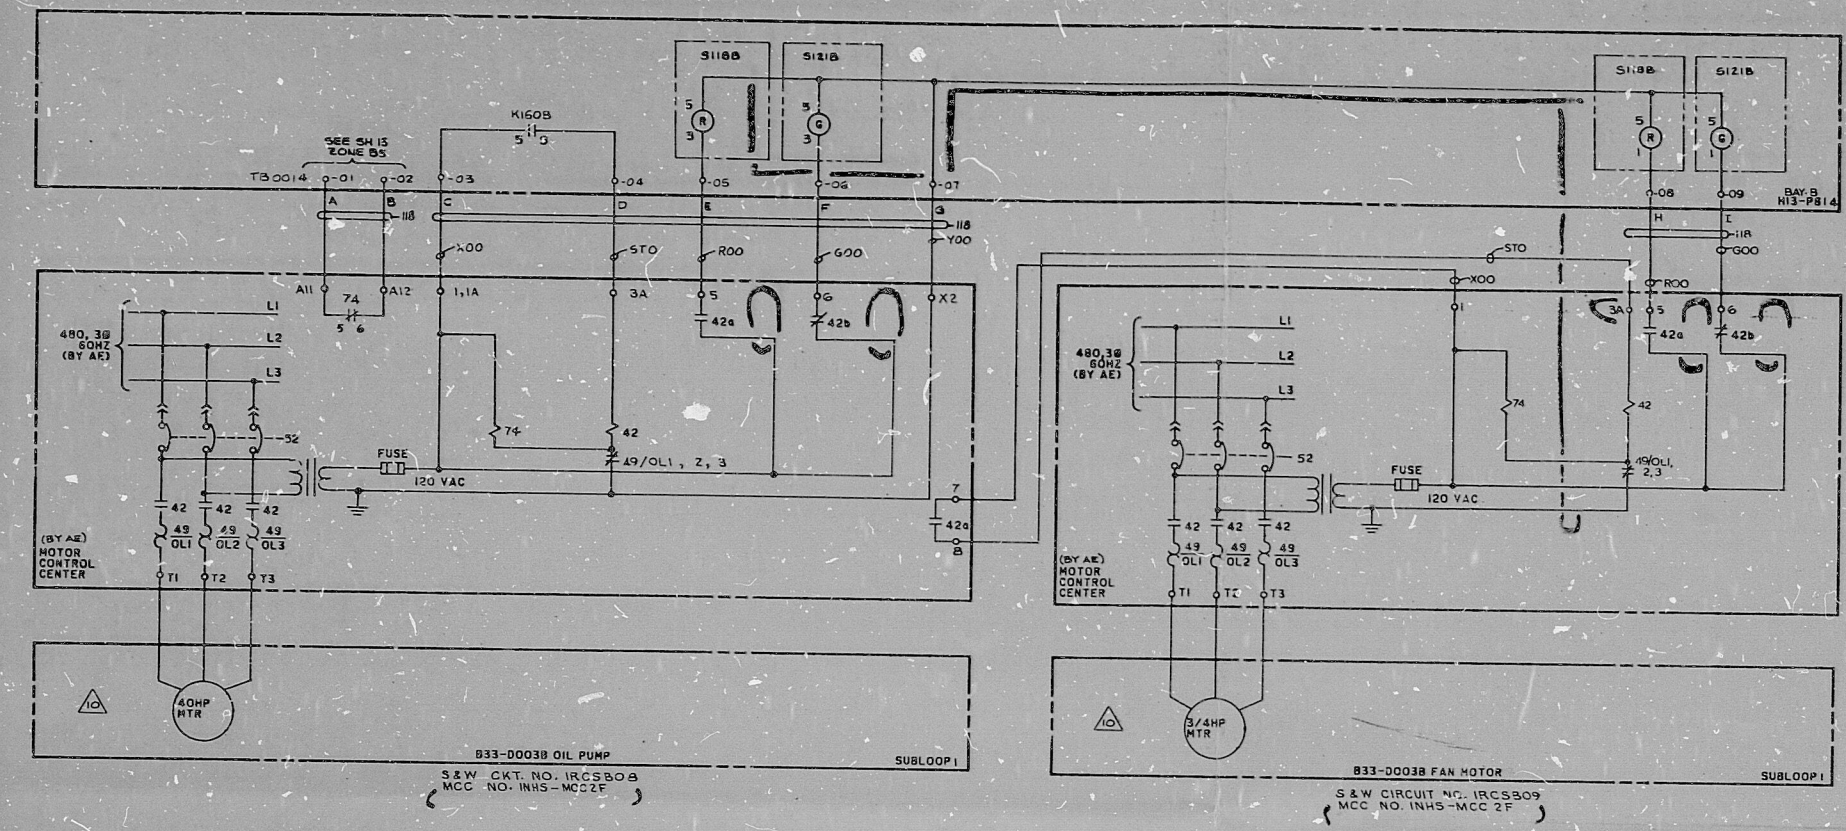

TI APERTURE CARD

CABLE NO.	LINE CODE
1833A 0235	115
1833A 0234	119

LIKE CODES IN HS

NO.	DESCRIPTION	DATE	BY

8412200078

PDR RIDS

