


44  
46  
48  
8.5"  
11"  
17"

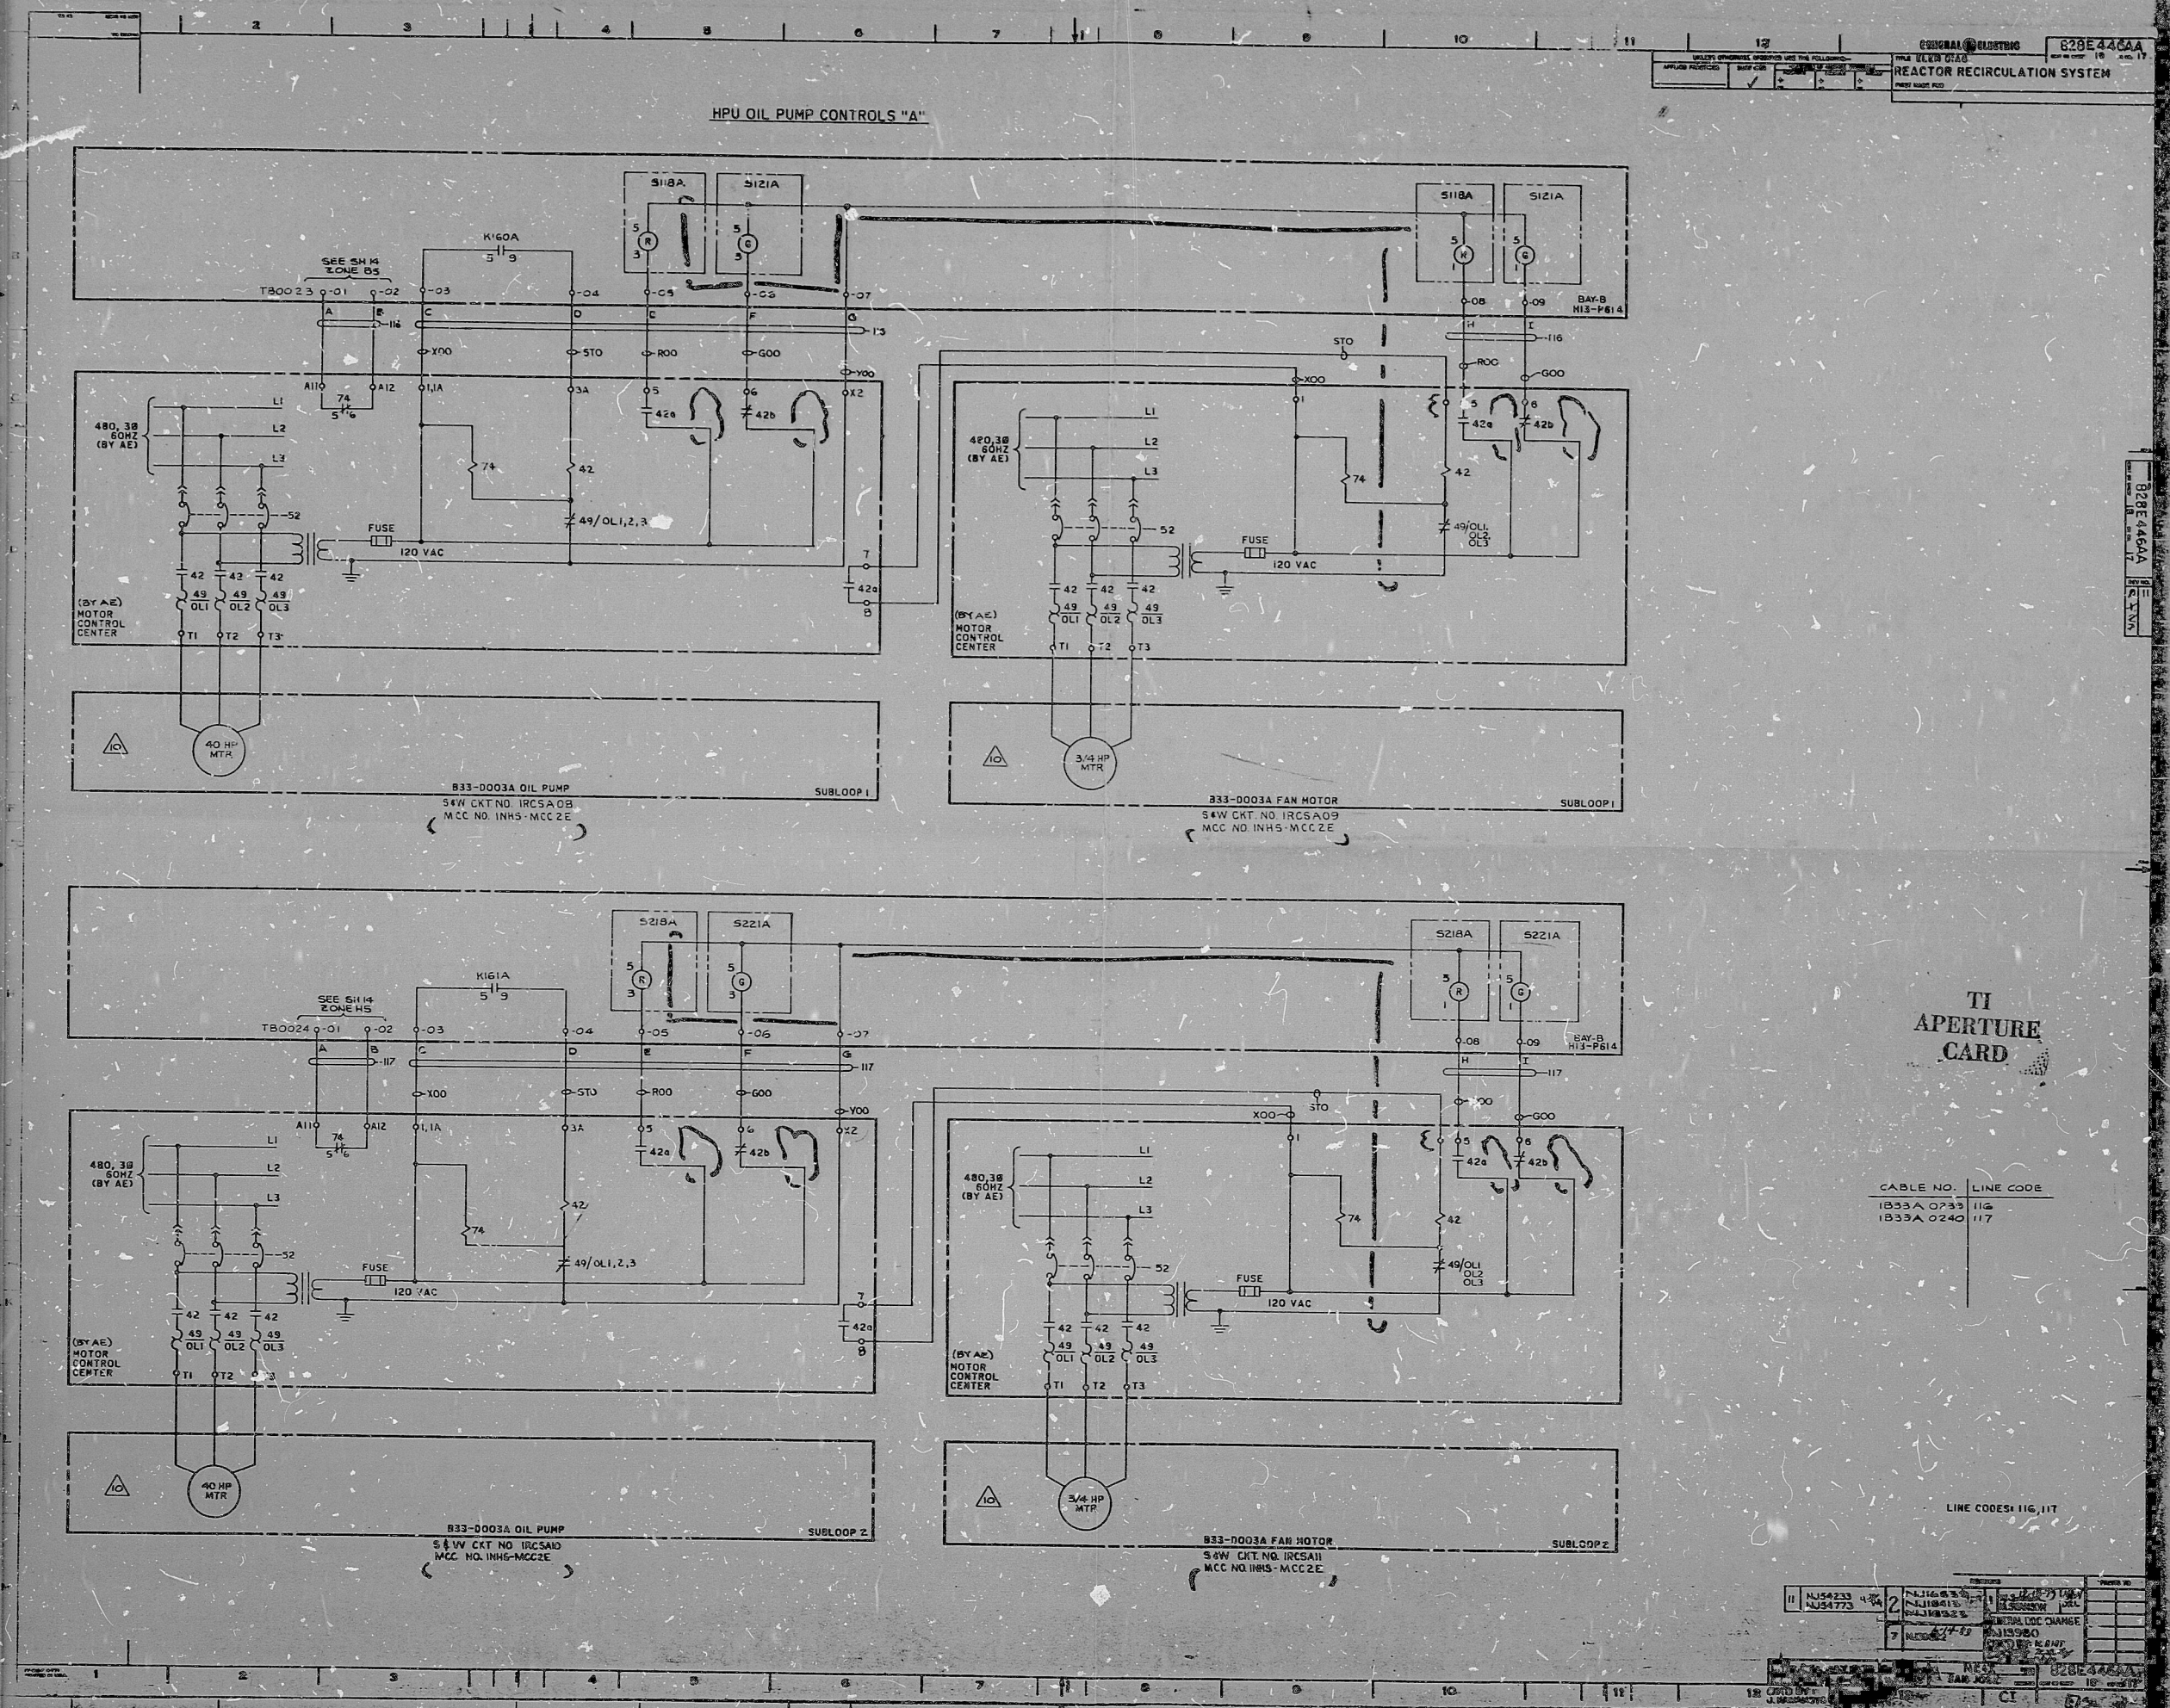

828E446AA

44  
46  
48  
8.5"  
11"  
17"



8412200080

PDR RIDS

