


22"  
17"  
11"  
8.5"  
8.5"  
11"  
17"  
22"

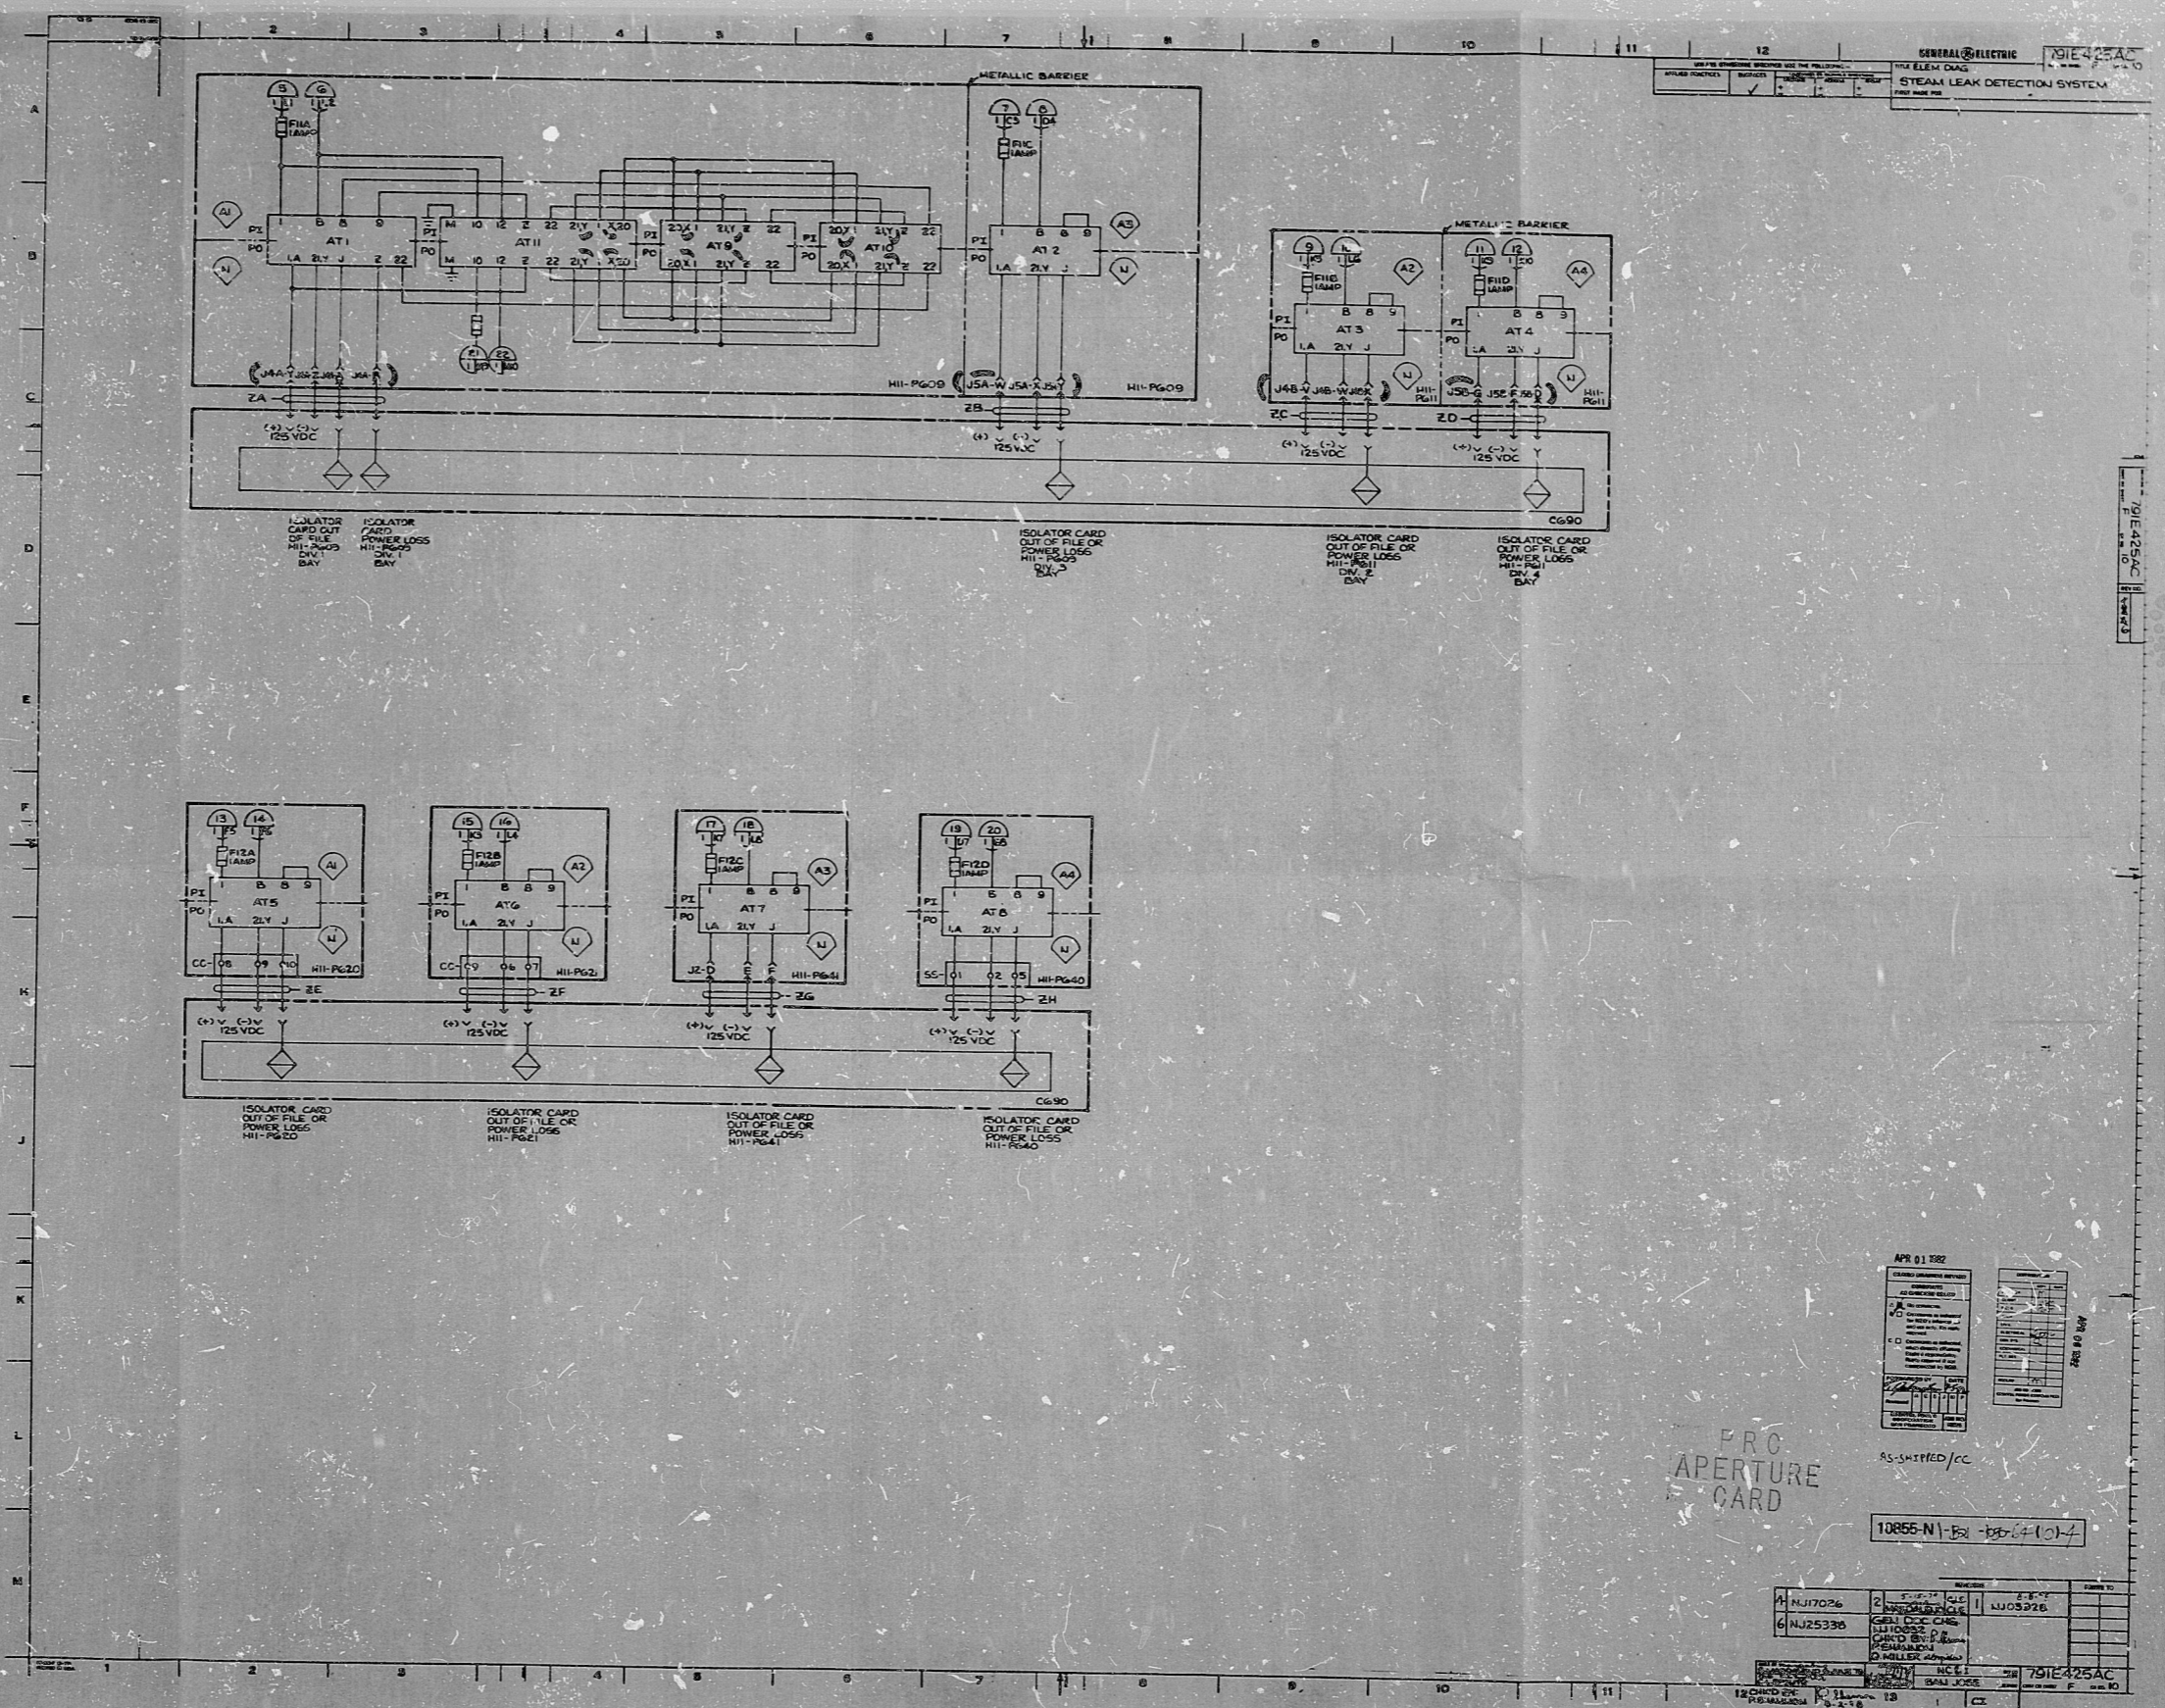

GENERAL ELECTRIC  
TYPE ELEMENT DIAG  
STEAM LEAK DETECTION SYSTEM  

APR 01 1982  

FRC  
APERTURE  
CARD



791E425AC

22"  
17"  
11"  
8.5"  
8.5"  
11"  
17"  
22"

RIDS

8307280428

