


ALL WIRE NOS ARE PREFIXED BY
 174510 ON THIS SHEET

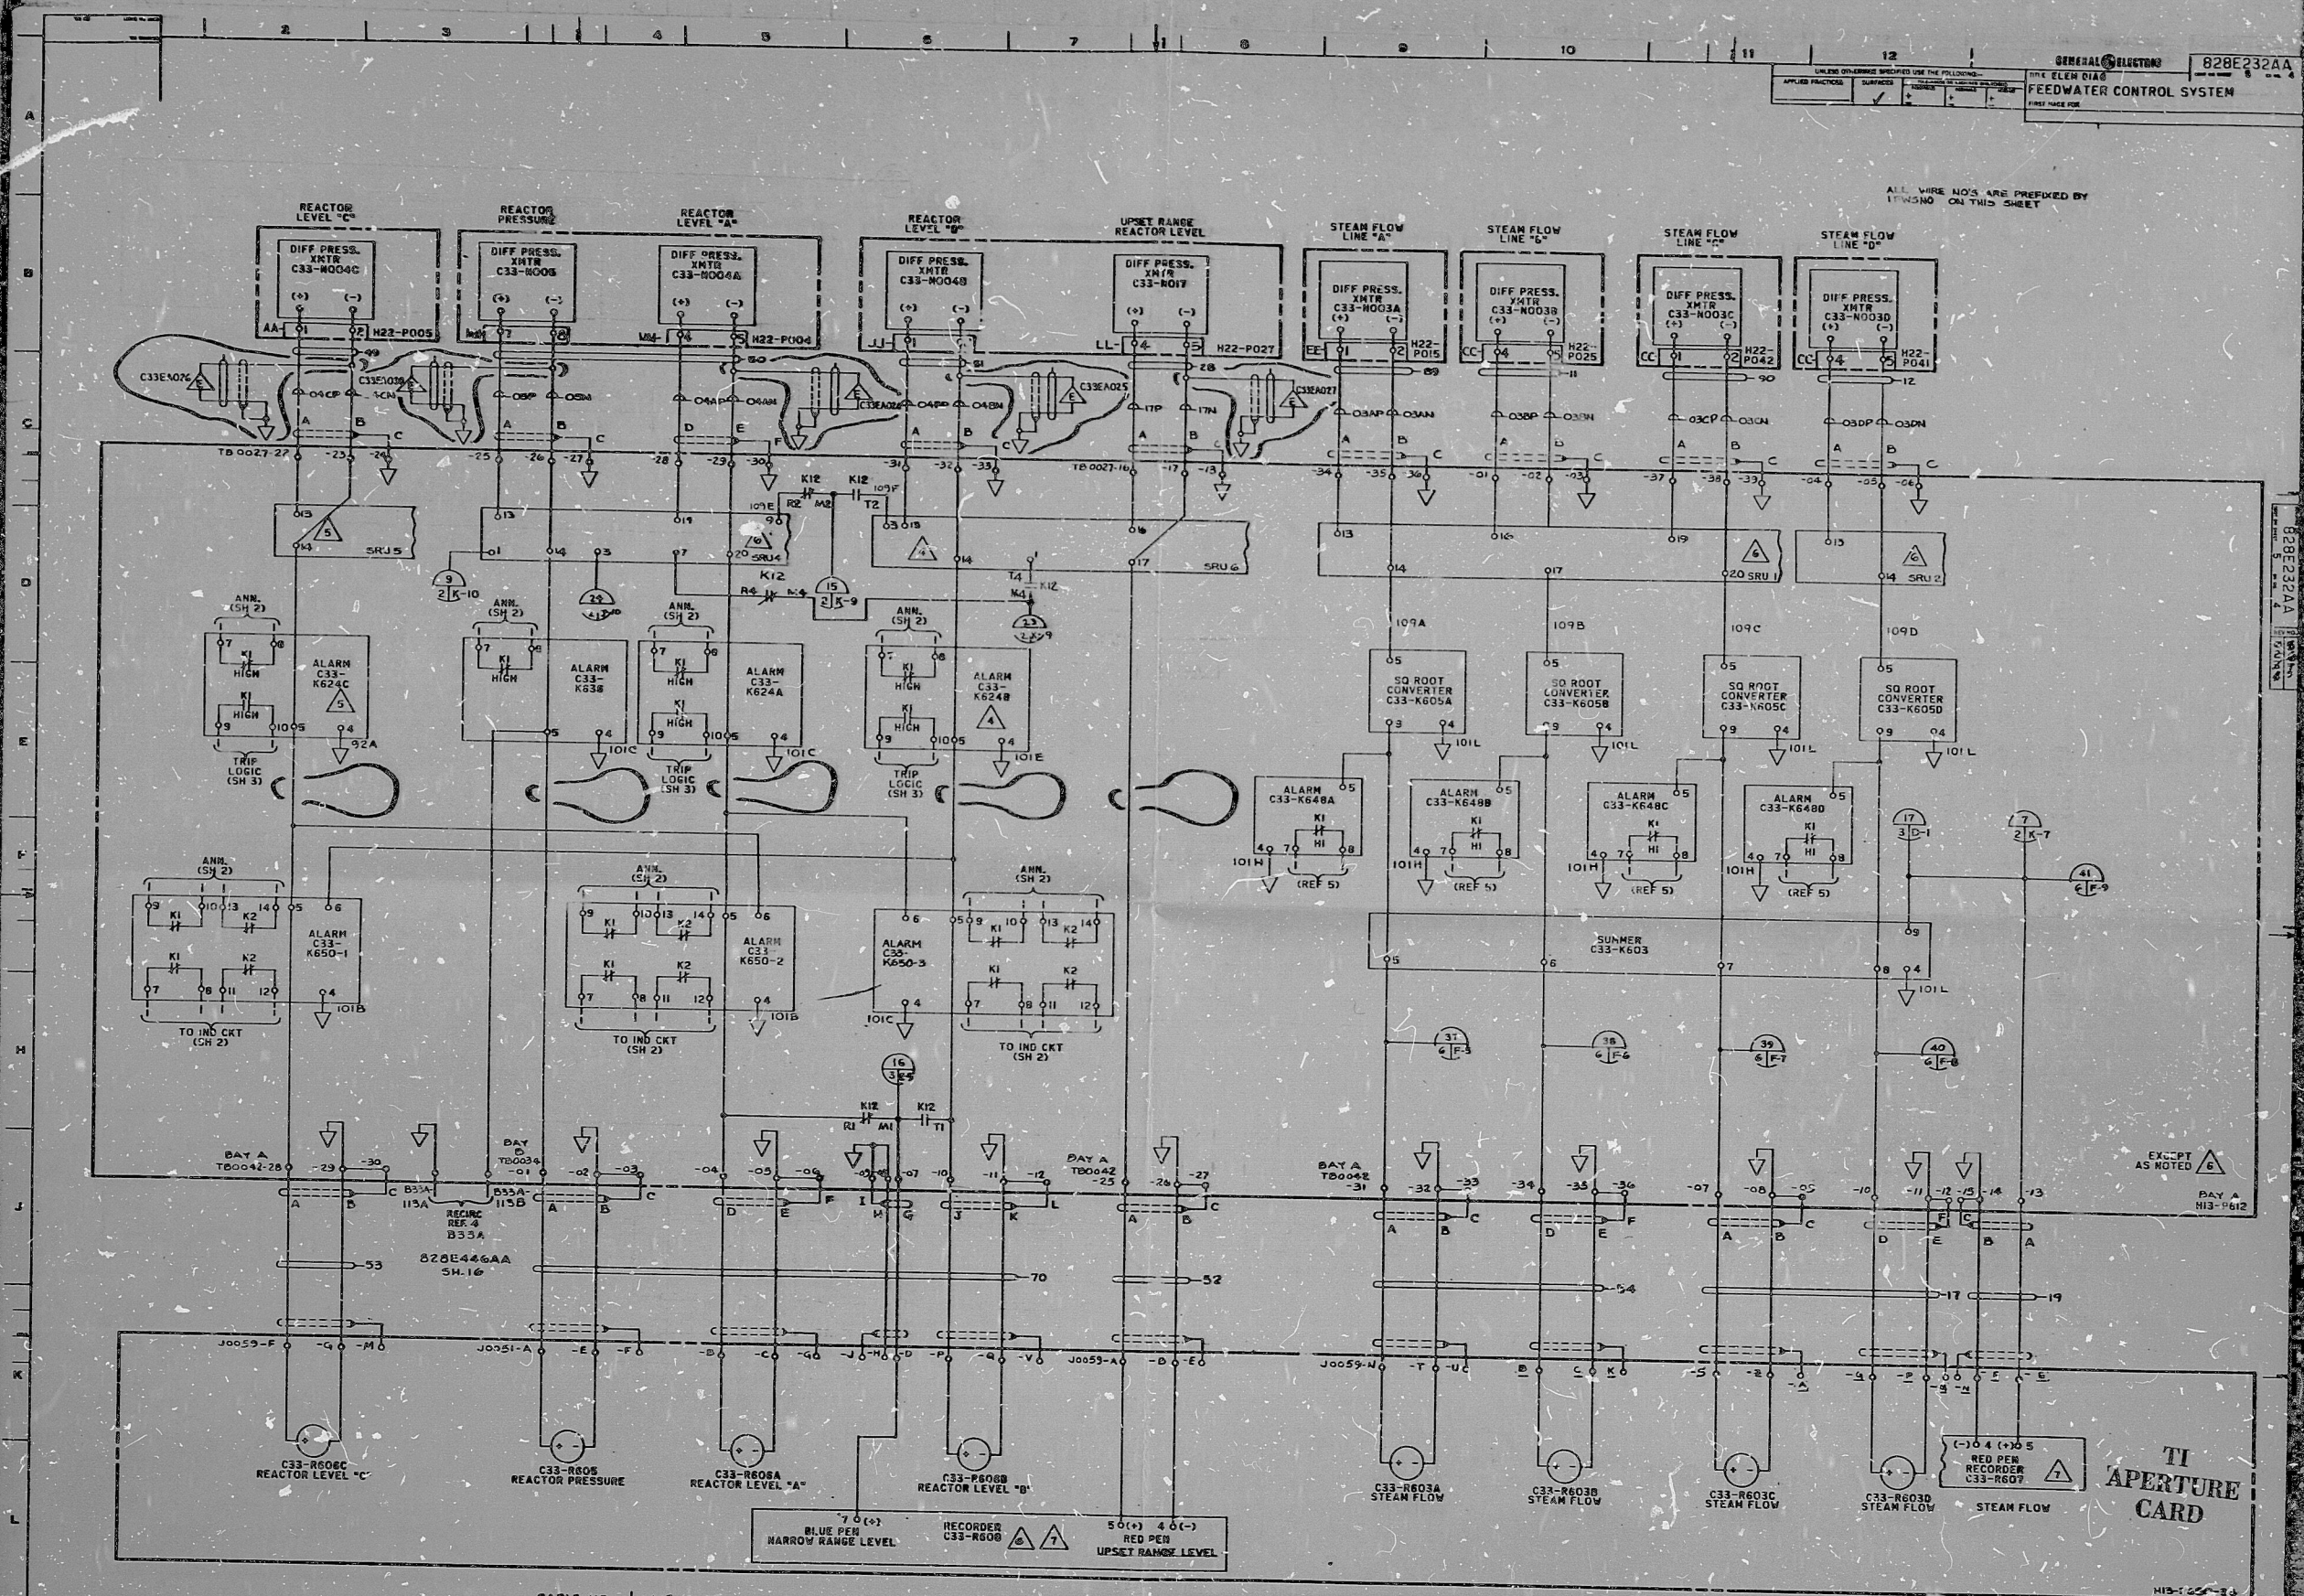

CABLE NO	LINE CODE
IC33A0005	11, 12, 28, 49, 50, 51, 89, 90
IC33A0022	17, 19, 52, 53, 54
IC33A0014	70

LINE CODES: 11, 12, 13, 28, 49-54, 70, 89, 90, 101, 109, 110, 113

NO	DATE	BY	REVISION

TI APERTURE CARD

46 41

46 11

46 58

8.5"

11"

17"

46 41

46 11

46 58

8.5"

11"

17"

8412200126

PDR RIDS

