


This drawing and the design it covers are the property of BECHTEL. They are merely loaned and on the borrower's express agreement that they will not be reproduced, copied, loaned, exhibited, or used except in the limited way and private use permitted by any written consent given by the lender to the borrower.

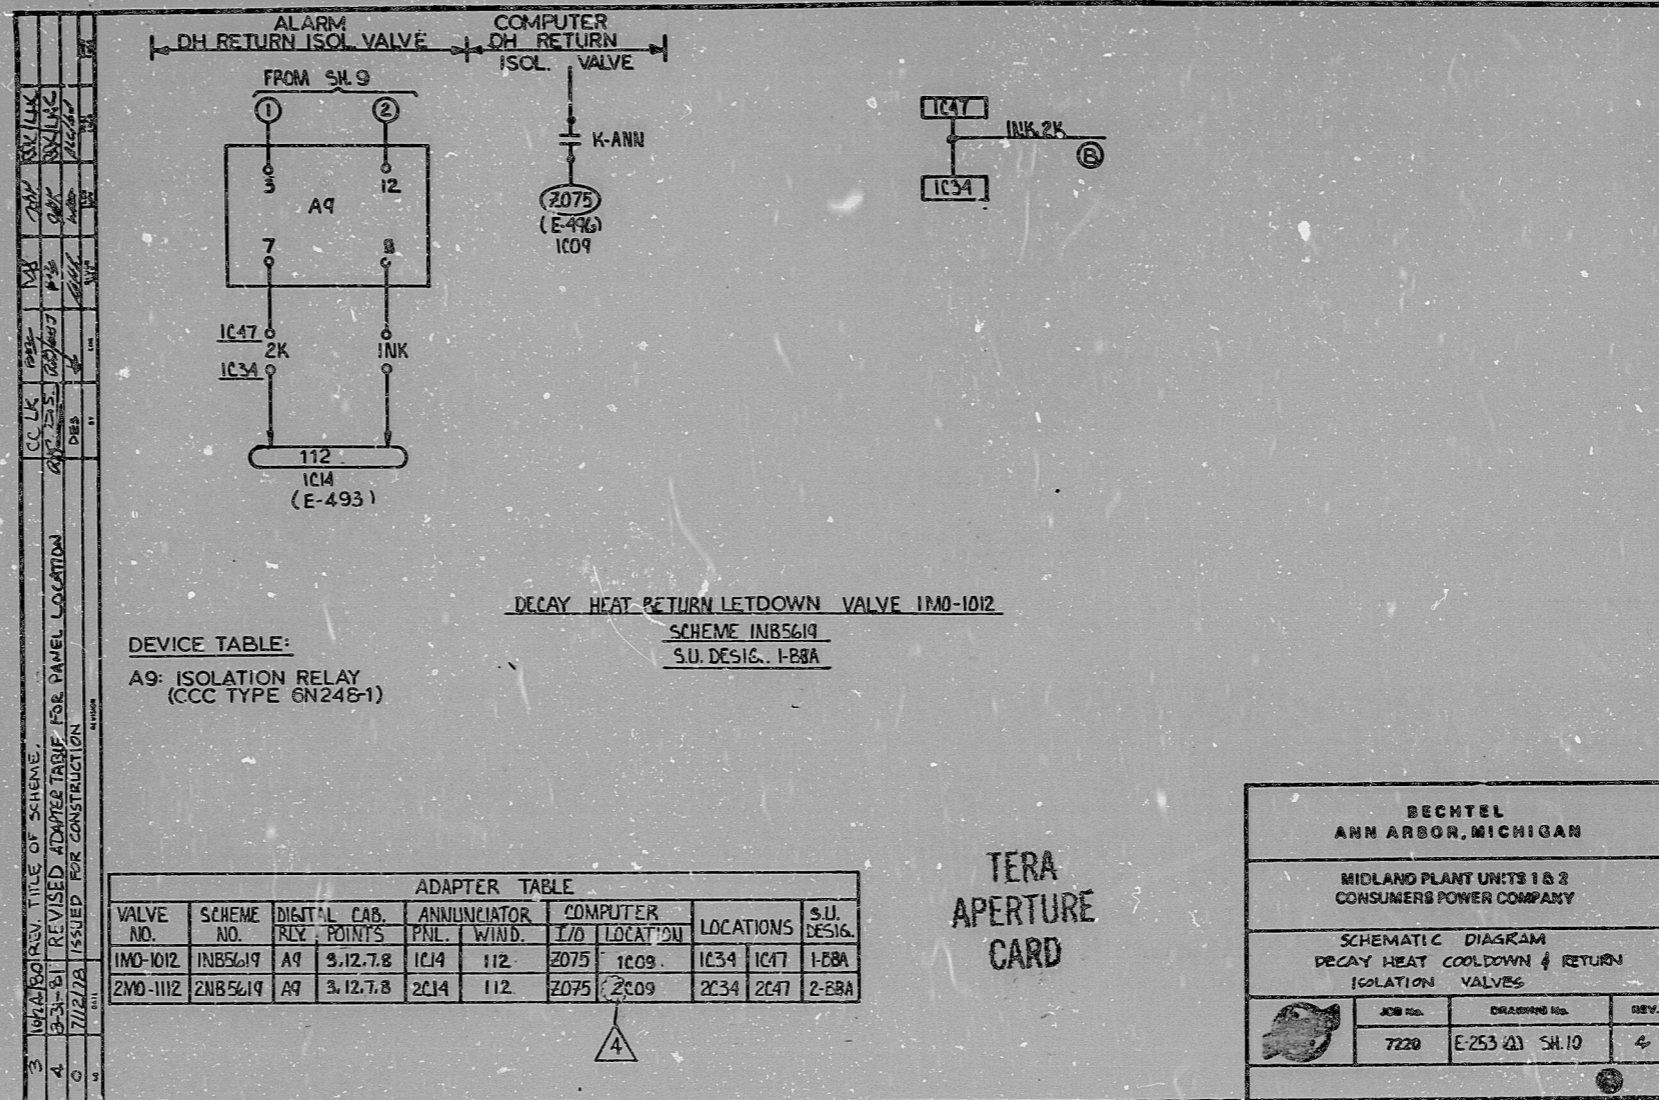

DECAY HEAT RETURN LETDOWN VALVE IM0-1012
 SCHEME INB5619
 S.U. DESIG. 1-B8A

DEVICE TABLE:
 A9: ISOLATION RELAY
 (CCC TYPE 6N248-1)

ADAPTER TABLE							
VALVE NO.	SCHEME NO.	DIGITAL CAB. RLY POINTS	ANNUNCIATOR PNL. WIND.	COMPUTER I/O LOCATION	LOCATIONS	S.U. DESIG.	
IM0-1012	INB5619	A9 3,12,7,8	IC14 112	2075 1C09	1C34 1C47	1-B8A	
2WD-1112	2NB5619	A9 3,12,7,8	2C14 112	2075 2C09	2C34 2C47	2-B8A	

TERA
 APERTURE
 CARD

BECHTEL ANN ARBOR, MICHIGAN		
MIDLAND PLANT UNITS 1 & 2 CONSUMERS POWER COMPANY		
SCHEMATIC DIAGRAM DECAY HEAT COOLDOWN & RETURN ISOLATION VALVES		
JOB No. 7220	DRAWING No. E-253 (2) SH.10	REV. 4

I certify that the image contained on this frame was made in the normal and regular course of business, on the date stated below and that it is an accurate reproduction of the document submitted to reprographics.

9-11-81 DATE
 Belinda M. Lyman SUPERVISOR OF MICROGRAPHICS
 CAMERA OPERATOR

16X

G-1348

RIDS

8112280071

