


This drawing and the design it covers are the property of BECHTEL. They are hereby loaned and on the borrower's express agreement that they will not be reproduced, copied, loaned, exhibited, or used except in the limited way and private use permitted by any written consent given by the lender to the borrower.

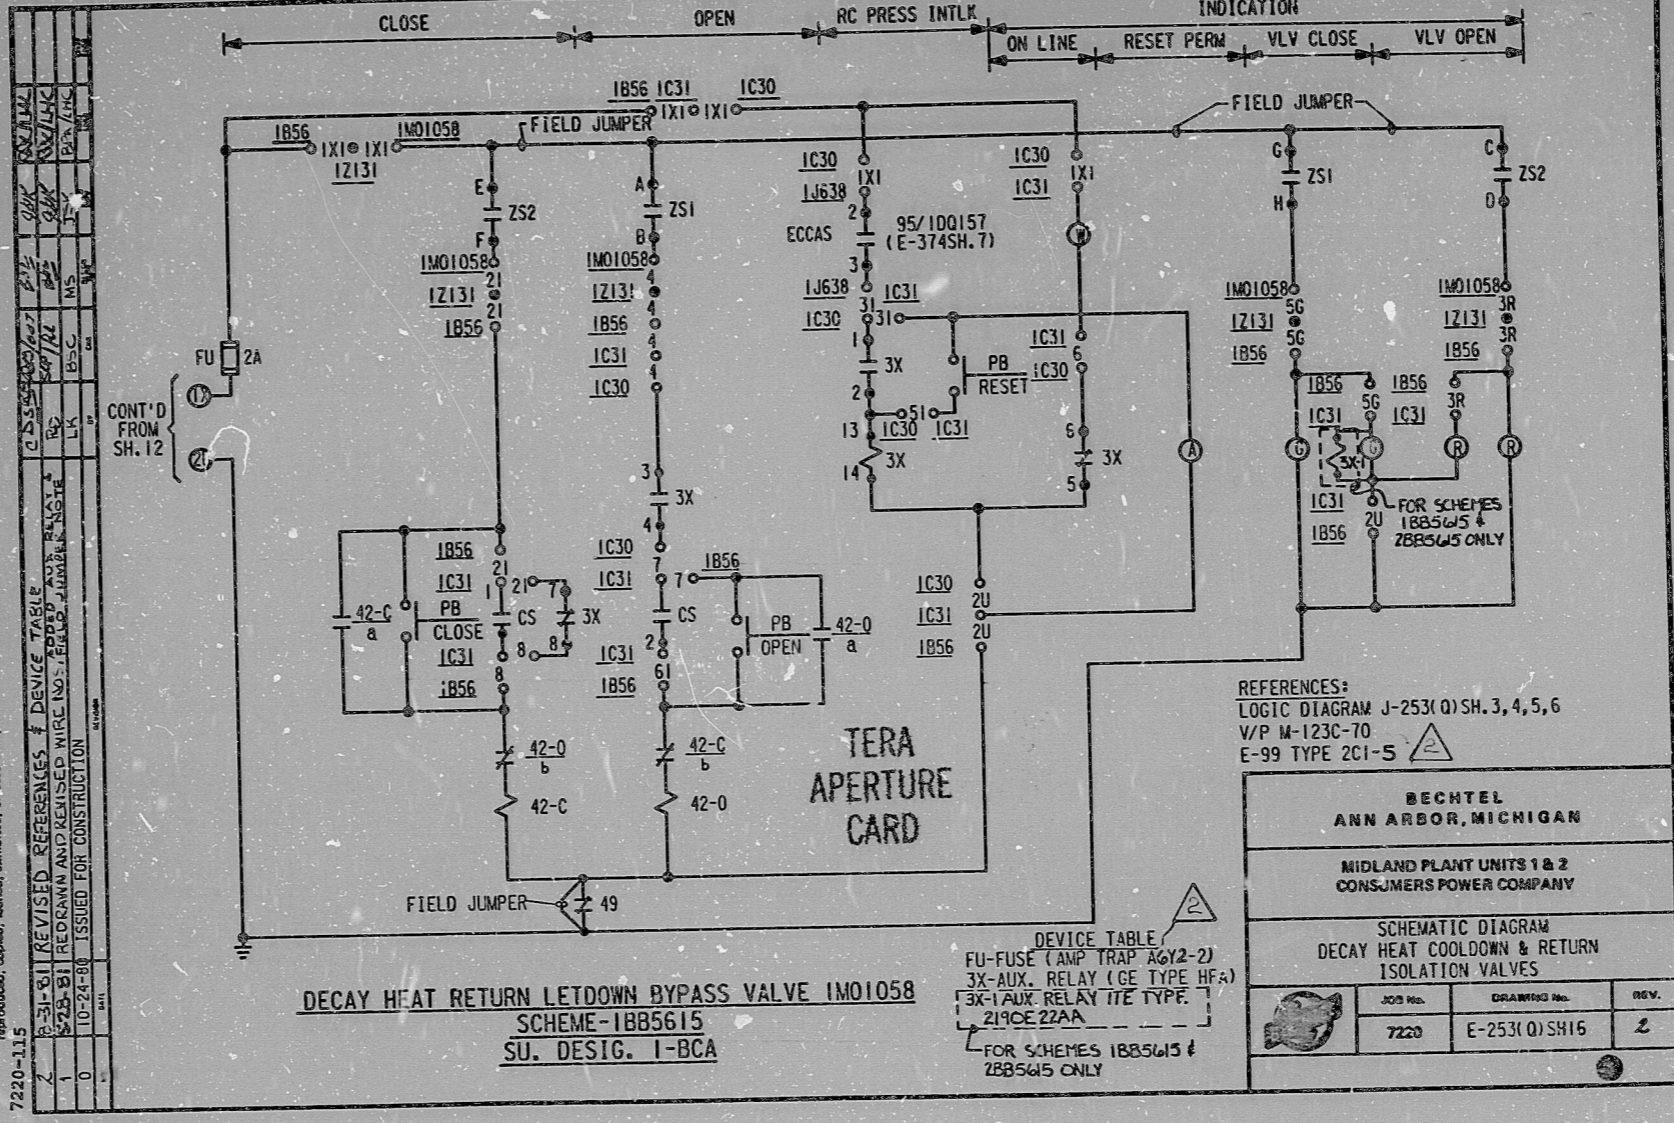

7220-115

REV.	DATE	BY	CHKD.	APP.	REVISION

CONT'D FROM SH. 12

DEVICE TABLE

FU-FUSE (AMP TRAP AGY2-2)
3X-AUX. RELAY (GE TYPE HFA)
3X-1 AUX. RELAY IIE TYPE 219CE 22AA
FOR SCHEMES 1B85615 & 2B85615 ONLY

I certify that the image contained on this frame was made in the normal and regular course of business, on the date stated below and that it is an accurate reproduction of the document submitted to reprographics.

9-1-81
DATE
CAMERA OPERATOR
SUPERVISOR OF REPROGRAPHICS

16X

RIDS

8112280081

