


This drawing and the design it covers are the property of BECHTEL. They are merely loaned and on the borrower's express agreement that they will not be reproduced, copied, loaned, exhibited, or used except in the limited way and for the limited time permitted by the letter to the borrower.

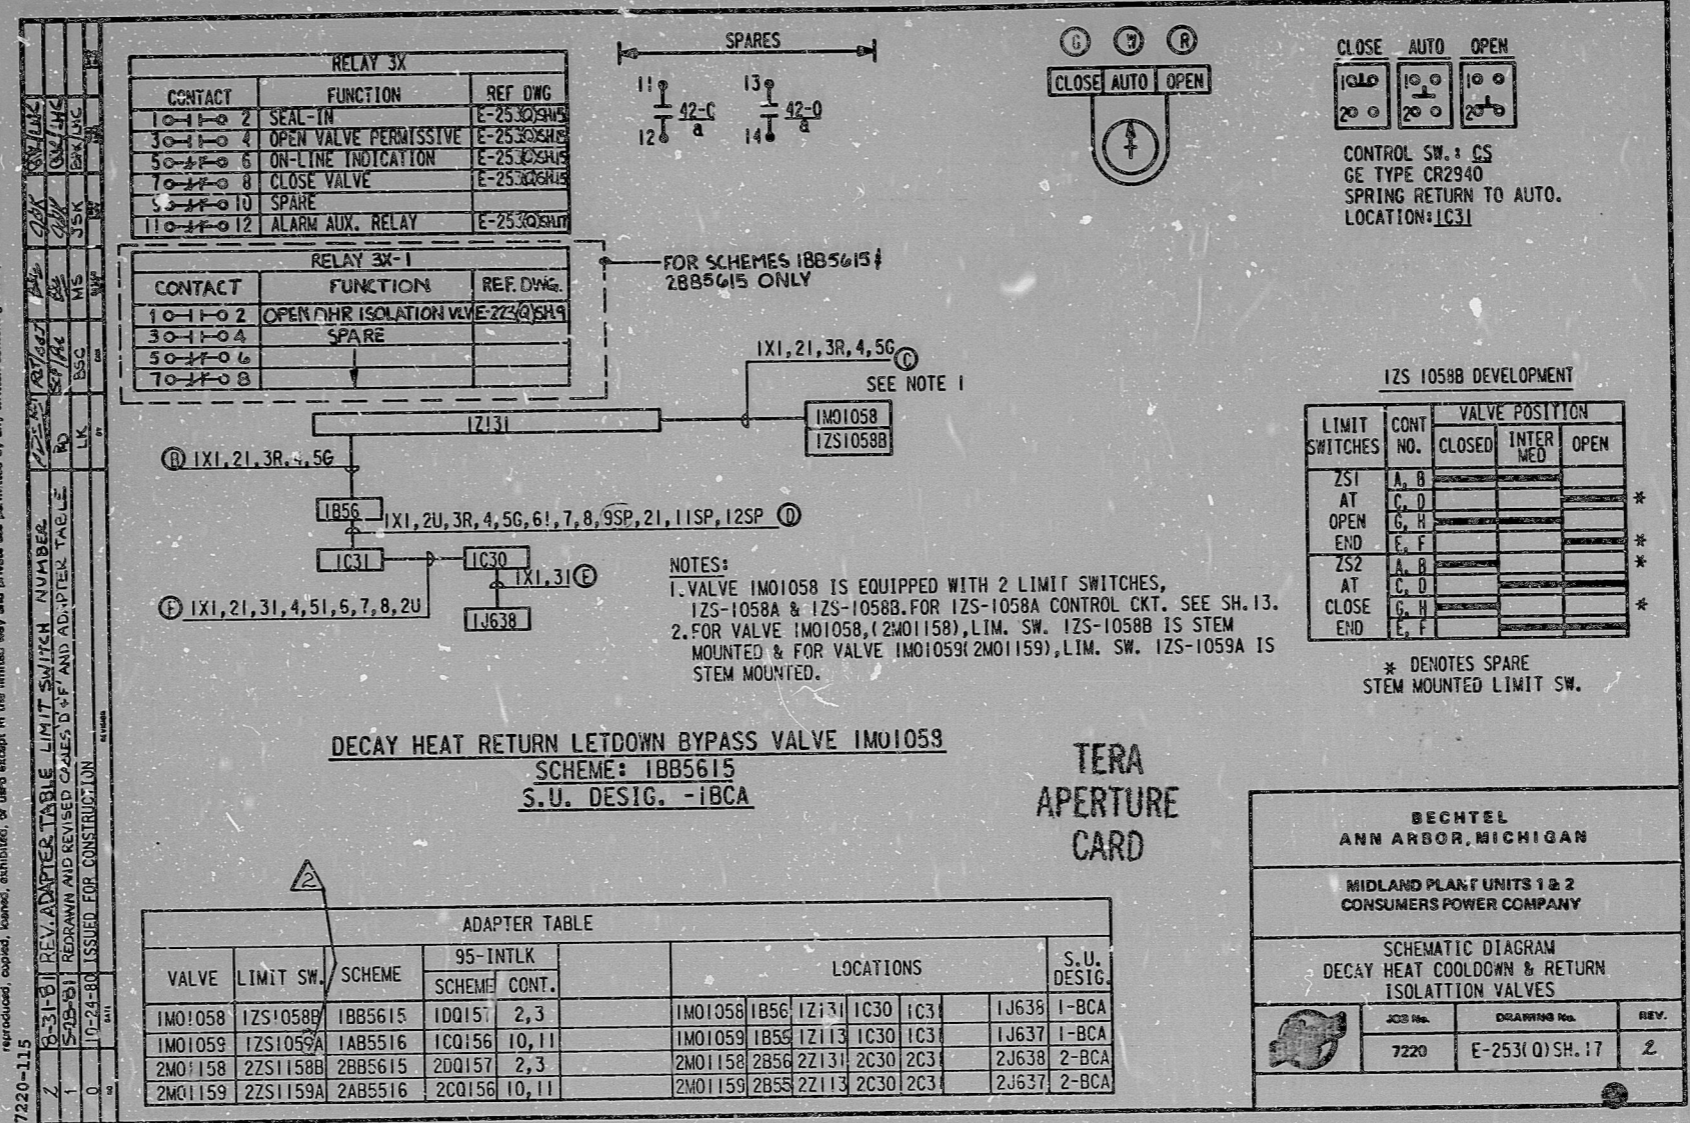

I certify that the image contained on this frame was made in the normal and regular course of business, on the date stated below and that it is an accurate reproduction of the document submitted to reprographics.

9-1-81 *B. H. ...*  
 DATE CAMERA OPERATOR SUPERVISOR OF MICROGRAPHICS

**16X**

G-1348

R:DS

8112280083

